


**Architectural Abbreviations:**

ADJ. Adjacent	F.E. Fire Extinguisher	P.C.F. Pounds Per Cubic Foot
A.F.F. Above Finish Floor	F.F. Finish Floor	PERF. Perforated
ALUM. Aluminum	FLR. Floor	P.L.F. Pounds Per Linear Foot
ALT. Alternate	F.O. Face of	PLY. Plywood
ARCH. Architectural	F.O.C. Face of Concrete	P.P.S. Pounds Per Square Foot
AVG. Average	F.O.M. Face of Masonry	P.S.I. Pounds Per Square Inch
	F.O.S. Face of Stud	P.T. Pressure Treated
BD. Board	FRMG. Framing	RAG. Return Air Grille
BDLG. Building	FTG. Footing	REF. Reference
BLKG. Blocking		REFR. Refrigerator
BM. Beam		REQD. Required
BTWN. Between		REV. Revision
	G. Gas	RM. Room
CA.TV. Cable Television	G.A. Gauge	R.O. Rough Opening
CBC. California Building Code	GALV. Galvanized	
C.I.P. Cast-In-Place Concrete	G.C. General Contractor	SECT. Section
C.J. Control Joint	G.F.I. Ground Fault Interrupter	S.F. Square Foot
CLG. Ceiling	GL. Glass	SHWR. Shower
CLR. Clear		SIM. Similar
C.M.U. Concrete Masonry Unit	HDR. Header	SPECS. Specifications
COL. Column	HGR. Hanger	SQ. Square
CONC. Concrete	HORIZ. Horizontal	S.S. Stainless Steel
CONT. Continuous	HT. Heating	STD. Standard
CPT. Carpet	HTG. Heating/Ventilating/Air-Conditioning	STL. Steel
C.T. Ceramic Tile	H.W. Hot Water	SUSP. Suspended
CTR. Center		SYS. System
C.W. Cold Water	INCL. Included/Including	TEL. Telephone
	INFO. Information	T.O.C. Top Of Concrete Thickness
D.F. Douglas Fir	INSUL. Insulation	THK. Thickness
DIA. Diameter	INT. Interior	T.O.B. Top Of Beam
DIM. Dimension		T.O.S. Top Of Slab
D.L. Dead Load	LAV. Lavatory	T.O.W. Top Of Wall
DN. Down	LB. Pound	TYP. Typical
DWG. Drawing	L.F. Linear Foot	
	L.L. Live Load	UBC. Uniform Building Code
EA. Each	MAX. Maximum	U.O.N. Unless Otherwise Noted
E.I.F.S. Exterior Insulation Finish System	MECH. Mechanical	V.I.F. Verify In Field
E.J. Expansion Joint	MFR. Manufacturer	VNR. Veneer
ELEC. Electrical	MICRO. Microwave	V.A. Vinyl Tile
ELEV. Elevation	MIN. Minimum	
E.O.S. Edge of Slab	MISC. Miscellaneous	W. With
EQ. Equal	MTL. Metal	W.C. Water Closet
EQUIP. Equipment		WD. Wood
EXT. Exterior	N/A. Not Applicable	W/D. Washer/Dryer
	NO. Number	W/O. Without
F.C.U. Fan Coil Unit	N.T.S. Not To Scale	WP. Waterproof
F.D. Floor Drain		WT. Weight
FDN. Foundation	O.C. On Center	

**Symbols:**

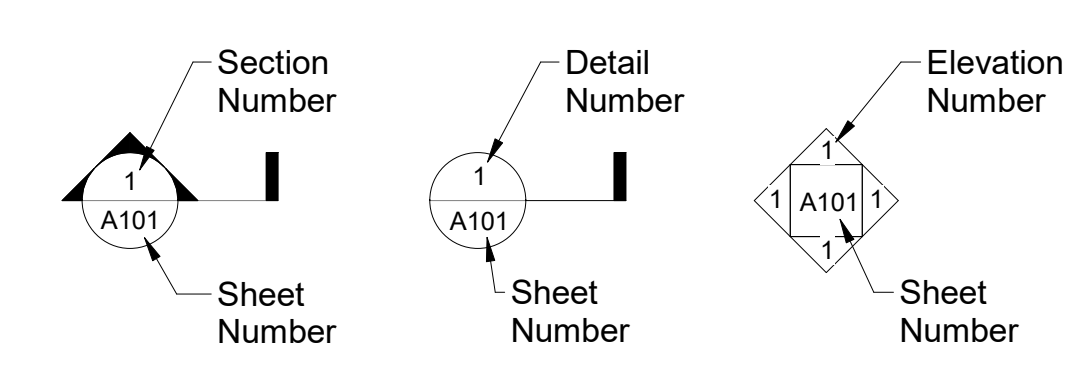

- Wall Type Reference
- Spot Elevation
- Elevation Level
- Door Tag
- Window Tag


**General Notes:**

- This project shall comply with the California Residential Code, 2022 Edition; The California Plumbing Code, 2022 Edition; The California Electrical Code, 2022 Edition; The California Mechanical Code, 2022 Edition; The California Fire Code, 2022 Edition; The California Energy Code, 2022 Edition; The California Green Building Standards Code, 2022 Edition; and all Amendments as adopted in Santa Barbara City Ordinance
- This project shall comply with the Santa Barbra Municipal Code; the applicable zoning ordinance for this project is 'Title 30 - Inland Zoning Ordinance'
- All dimensions are to face of stud, concrete or masonry, unless otherwise noted on drawings.
- Yard setbacks are to be measured from the exterior wall finish to the property line and not from the outside of the footing (or face of studs).
- Contractor shall bring to the attention of the architect any conflict, discrepancy or ambiguity in the contract documents and shall not proceed with any of the work effected thereby until clarification is given by the architect.
- City of Santa Barbara minimum construction specifications shall be a part of the construction documents. Is is the sole responsibility of the general contractor to review these specifications. Where these construction documents call for a higher standard than that called for in the city specifications, these documents shall take precedence.
- Contractor shall comply with all OSHA requirements.
- Tempered glass shall be permanently identified and visible when the unit is glazed.
- All windows are to have labels attached by N.F.R.C. showing compliance with energy standards.
- All showerheads for all shower fixtures shall be certified as having a maximum flow rate of no more than 1.8 gpm at 80 psi per CGC 4.303.1.
- All lavatory and kitchen faucets shall be fitted with a flow-restricting aerator with a certified, maximum flow rate of no more than 1.5 gpm for lavatory faucets and 1.8 gpm for kitchen faucets per CGC 4.303.1.
- All lavatory and kitchen flushometer valves, if any, shall be certified as using no more than 1.28 gallons per flush and shall meet the performance standards established by the American National Standards Institute Standard A112.19.2.
- Penetrations of fire-resistive walls, floor-ceilings and roof-ceilings shall be protected as required in CBC.
- A minimum of 65% of construction waste and demolition debris is to be recycled and/or salvaged per CGC 4.408.1.
- City will void all designed structural lumber if ripped.
- Only low volume drip or bubbler emitters shall be used to irrigate existing or proposed non-turf, outside landscaping.
- The contractor responsible for the construction of the seismic-force-resisting system shall submit a written Statement of Responsibility to the building official prior to the commencement of work on the system.
- Contractor is to provide an operation and maintenance manual for the owner at the time of final inspection per CGC 4.410.1.
- VOC's must comply with the limitations listed in CGC Section 4.504.3 and Tables 4.504.1, 4.504.2, 4.504.3 and 4.504.5 for: Adhesives, Paints and Coatings, Carpet and Composition Wood Products. CGC Section 4.504.2.
- Prior to final approval, Contractor will complete and sign the Green Building Standards Certification form to be filed with the building department official.
- The moisture content of wood shall not exceed 19% before it is enclosed in construction. Buildings materials with visible signs of water damage should not be used in construction. The moisture content shall be verified by the contractor by one of 3 methods specified under CGC 4.505.3.
- Contractor shall submit a Construction Waste Management Plan to the jurisdictional agency that regulates waste management, per CGC 4.408.2.
- Concrete slabs will be provided with a capillary break. CGC 4.505.2.1.
- Compliance with the documentation requirements of the 2022 Energy Efficiency Standards is necessary for this project. Registered, signed, and dated copies of the appropriate CF1R, CF2R, and CF3R forms shall be made available at necessary intervals for Building Inspector review. Final completed forms will be available for the building owner.
- During construction, ends of duct openings are to be sealed, and mechanical equipment is to be covered. CGC 4.504.1
- Bathroom Exhaust Fans are to be capable of providing 5 air changes per hour, and shall be Energy Star rated, vented directly to the outside.

**Drawing Index:**

- TS Title Sheet
- T1 Title 24
- T2 Title 24
- T3 Title 24
- T4 Title 24
- GN1 Specifications
- GN2 Specifications
- GN3 Specifications
- GN4 Specifications
- GN5 Fireplace Venting
- A1 Site Plan
- A2 First Floor Plan
- A3 Second Floor & Roof Plan
- A4 Elevations & Sections
- A5 Details
- A6 Details
- A7 Interior Elevations
- A8.1 Existing Plans
- A8.2 Existing Plans
- A8.3 Existing Plans
- A8.4 Existing Plans
- S-1.1 Structural Title Sheet
- S-1.2 Structural Specifications
- S-2.1 Foundation Plan
- S-2.2 Floor Framing Plan
- S-2.3 Roof Framing Plan
- S-3.1 Structural Details
- S-3.2 Structural Details
- ME Mechanical & Electrical Plans
- P Plumbing Plans
- CG1 CA Green Building Standards
- CG2 CA Green Building Standards
- BMP-1 Standard BMP
- BMP-2 Standard BMP
- BMP-3 Standard BMP
- BMP-4 Standard BMP
- BMP-5 Standard BMP
- BMP-6 BMP Plan

**Vicinity Map:**

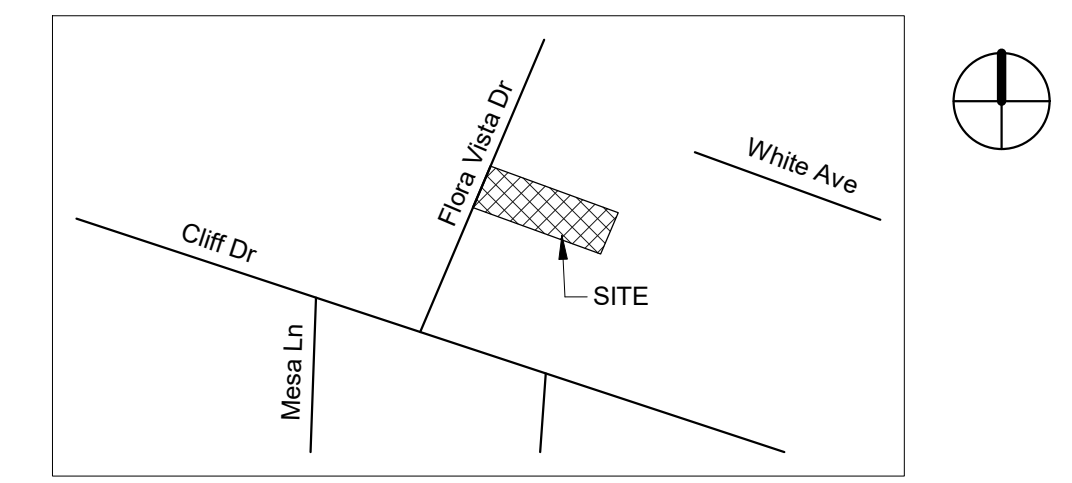

**F.A.R. Calculations:**

Project Address:	412 Flora Vista
Proposed TOTAL NET FAR:	2,594 sq. ft.
Zone:	RS-7.5 (SBMC Title 30)
Net Lot Area:	5,911 sq. ft.
Is the height of existing or proposed buildings 17 ft. or greater:	Yes
Are existing or proposed buildings two stories or greater:	Yes
Average Slope of Lot:	7%
Does the height of existing or proposed buildings exceed 25 ft.:	No
Is the site in the Hillside Design District:	No
Does the project include 500 or more cu. yds. of grading outside the main building footprint:	No
Floor Area Ratio (FAR):	0.444
Lot Size Range:	4,000 - 9,999 sq. ft.
MAX FAR Calculation:	1,200 + (0.25 x lot size)
100% MAX FAR:	2,678 sq. ft. (0.453)
85% of MAX FAR:	2,276 sq. ft.
80% of MAX FAR:	2,142 sq. ft.

**Mandatory BMP Inspections:**

Note: Inspections shall be called in by Contractor for inspection 72 hours prior to needed inspection. The City will then route the request to the QSP Inspector or third-party company.

Inspections for Storm Water Post-Construction Improvements:  
 - Confirmation that roof downspouts identified on sheet BMP-6 distribute storm water over rain garden area

**Project Directory:**

**Owner:**  
 Nate, Natalie, & Karen Evans  
 412 Flora Vista Drive  
 Santa Barbara, CA 93109  
 (805) 453-1723  
 nevans@tynangroup.com

**Contractor:**  
 TBD

**Designer:**  
 Nicodemus Design  
 Nate Nicodemus  
 8861 Villa La Jolla Dr.  
 La Jolla, CA 92037  
 (760) 473-1041  
 nn@natenicodemus.com

**Engineer:**  
 Ashley & Vance Engineering, Inc.  
 R. Paul Belmont, P.E.  
 210 East Cota Street  
 Santa Barbara, CA 93101  
 (805) 962-9966  
 paul@ashleyvance.com

**Project Information:**

**Project Description:**

Remodel of the existing single family residence. No changes to existing accessory dwelling unit are proposed. One small addition of 51 sq. ft. proposed to the second floor primary bedroom. No additions proposed to the first floor. New roof proposed at the second floor and all new windows and doors proposed throughout the home. All existing windows will be either replaced in kind or altered per elevations. New windows and doors will match the windows and doors on the existing ADU (per previous permit). New front porch and new chimney proposed at the first floor. Runoff treatment landscape area to be provided in side yard for redeveloped impervious areas (2nd floor roof and front porch).

A Minor Zoning Exception is required per SBMC30.165.040.B.2. for the change in openings with the setback on the second floor (new windows in an existing exterior wall that is over the setback by approximately 9 inches).

**Project Address:** 412 Flora Vista, Santa Barbara, CA  
**Assessor's Parcel Number:** 041-242-030  
**Construction Type:** V B - Wood Frame  
**Occupancy Classification:** R3  
**Automatic Fire Sprinklers:** Yes

**Santa Barbara Parcel Zoning:** RS-7.5 (SBMC Title 30)  
**Lot Area:** 5,911 sq. ft.  
**Stories:** Two  
**Proposed Main House Height:** 22'-9"  
**Existing ADU Height (No Change):** 15'-11 1/2"  
**Existing ADU Bedrooms:** 2  
**High Fire:** No  
**Flood Plain:** No  
**Parcel Slope:** 7%

**Parking Spaces Provided (EXISTING TO REMAIN):**  
 Accessory Dwelling Unit:  
     Existing: 0  
 Main Residence:  
     Existing: 2 uncovered

**Areas:**

**FLOOR AREA CALCULATIONS:**

<b>Total Existing Floor Area:</b>	<b>2,543 net sq. ft. / 2,764 gross sq. ft.</b>
Accessory Dwelling Unit:	945 net sq. ft. / 1,046 gross sq. ft.
2-Story Primary Residence:	1,598 net sq. ft. / 1,718 gross sq. ft.
1st Floor:	1,305 net sq. ft. / 1,394 gross sq. ft.
2nd Floor*:	293 net sq. ft. / 324 gross sq. ft.
*excludes stair: 53 net sq. ft. / 65 gross sq. ft.	
<b>2nd Floor Addition:</b>	<b>51 net sq. ft. / 51 gross sq. ft.</b>
<b>TOTAL PROPOSED AREA ON SITE:</b>	<b>2,594 net sq. ft. / 2,815 gross sq. ft.</b>

**IMPERMEABLE / PERMEABLE AREA:**

Existing Building Footprint:	2,440 sq. ft.
Existing Hardscape:	1,152 sq. ft.
Existing Landscape:	2,319 sq. ft.

Per SBMC 22.87:

New Impervious Area:	87 sq. ft.
*Includes new front porch and chimney	
Redeveloped Impervious Area:	596 sq. ft.
*Includes revised roof over 2nd floor & updated entry hardscape	
Removed Impervious Area:	25 sq. ft.
*Includes some removal of hardscape in front yard	

**ND DESIGN**

**NICODEMUS DESIGN**  
 8861 Villa La Jolla Dr.,  
 P.O. Box # 13367,  
 La Jolla, CA 92037  
 Phone: (760) 473-1041

DESIGNER:

Drawn By:  
 NN

Drawing Date:  
 October 10, 2023

revision	date	notes
1	12/13/23	Plan Check
2	02/05/24	Plan Check
3	05/04/24	Plan Check

**Evans Remodel**  
 412 Flora Vista, Santa Barbara, CA

PROJECT:

**Title Sheet**

DRAWING NUMBER:

**TS**





**NICODEMUS DESIGN**  
 8861 Villa La Jolla Dr.,  
 P.O. Box # 13367,  
 La Jolla, CA 92037  
 Phone: (760) 473-1041

DESIGNER:

Drawn By:  
 NN

Drawing Date:  
 October 10, 2023

revision	date	notes

**Evans Remodel**  
 412 Flora Vista, Santa Barbara, CA

PROJECT:

Title 24

SHEET TITLE:

T1

DRAWING NUMBER:

**BUILDING ENERGY ANALYSIS REPORT**

**PROJECT:**  
 Evans Residence  
 412 Flora Vista Dr  
 Santa Barbara, Ca 93109

**Project Designer:**  
 NN Design  
 9114 Regents Rd, #C  
 San Diego, Ca 92037  
 760-473-1041

**Report Prepared by:**  
 Brian Hansen  
 Technical Energy  
 4336 Goldfinch St  
 San Diego, Ca 92103  
 858-472-2680

**Job Number:**  
 23-347

**Date:**  
 10/1/2023

The EnergyPro computer program has been used to perform the calculations summarized in this compliance report. This program has approval and is authorized by the California Energy Commission for use with both the Residential and Nonresidential 2022 Building Energy Efficiency Standards. This program developed by EnergySoft, LLC - www.energysoft.com.

**CERTIFICATE OF COMPLIANCE - RESIDENTIAL PERFORMANCE COMPLIANCE METHOD** CF1R-PRF-01E  
**Project Name:** Evans Residence Calculation Date/Time: 2023-10-01T08:03:53-07:00  
**Calculation Description:** Title 24 Analysis Input File Name: 23-347 EvansEA.rbd22x (Page 1 of 12)

GENERAL INFORMATION			
01	Project Name	Evans Residence	
02	Run Title	Title 24 Analysis	
03	Project Location	412 Flora Vista Dr	
04	City	05	Standards Version
06	Zip code	07	Software Version
08	Climate Zone	09	Front Orientation (deg/ Cardinal)
10	Building Type	11	Number of Dwelling Units
12	Project Scope	13	Number of Bedrooms
14	Addition Cond. Floor Area (ft <sup>2</sup> )	15	Number of Stories
16	Existing Cond. Floor Area (ft <sup>2</sup> )	17	Fenestration Average U-factor
18	Total Cond. Floor Area (ft <sup>2</sup> )	19	Glazing Percentage (%)
20	ADU Bedroom Count	21	ADU Conditioned Floor Area
22	Fuel Type	23	Occupancy U:

COMPLIANCE RESULTS	
01	Building Complies with Computer Performance
02	This building incorporates features that require field testing and/or verification by a certified HERS rater under the supervision of a CEC-approved HERS provider.
03	Building does not incorporate Special Features

Registration Number: 423-P010178578A-000-000-0000000-0000  
 Registration Date/Time: 10/01/2023 19:39  
 HERS Provider: CHEERS  
 NOTE: This document has been generated by California Home Energy Efficiency Rating Services (CHEERS) using information uploaded by third parties not affiliated with or related to CHEERS. Therefore, CHEERS is not responsible for, and cannot guarantee, the accuracy or completeness of the information contained in this document.  
 CA Building Energy Efficiency Standards - 2022 Residential Compliance  
 Report Version: 2022.0.000  
 Schema Version: rev 20220901  
 Report Generated: 2023-10-01 08:04:38

**CERTIFICATE OF COMPLIANCE - RESIDENTIAL PERFORMANCE COMPLIANCE METHOD** CF1R-PRF-01E  
**Project Name:** Evans Residence Calculation Date/Time: 2023-10-01T08:03:53-07:00  
**Calculation Description:** Title 24 Analysis Input File Name: 23-347 EvansEA.rbd22x (Page 3 of 12)

ENERGY USE INTENSITY				
	Standard Design (kBtu/ft <sup>2</sup> - yr)	Proposed Design (kBtu/ft <sup>2</sup> - yr)	Compliance Margin (kBtu/ft <sup>2</sup> - yr)	Margin Percentage
Gross EUI <sup>1</sup>	19.53	19.47	0.06	0.31
Net EUI <sup>2</sup>	19.53	19.47	0.06	0.31

Notes  
 1. Gross EUI is Energy Use Total (not including PV) / Total Building Area.  
 2. Net EUI is Energy Use Total (including PV) / Total Building Area.

**REQUIRED SPECIAL FEATURES**  
 The following are features that must be installed as condition for meeting the modeled energy performance for this computer analysis.  
 • NO SPECIAL FEATURES REQUIRED

**HERS FEATURE SUMMARY**  
 The following is a summary of the features that must be field-verified by a certified HERS Rater as a condition for meeting the modeled energy performance for this computer analysis. Additional detail is provided in the building tables below. Registered CF2Rs and CF3Rs are required to be completed in the HERS Registry

- Kitchen range hood
- Minimum Airflow
- Verified SEER/SEER2
- Fan Efficacy Watts/CFM
- Verified heat pump rated heating capacity
- Duct leakage testing

BUILDING - FEATURES INFORMATION						
01	02	03	04	05	06	07
Project Name	Conditioned Floor Area (ft <sup>2</sup> )	Number of Dwelling Units	Number of Bedrooms	Number of Zones	Number of Ventilation Cooling Systems	Number of Water Heating Systems
Evans Residence	1783	1	3	2	0	1

Registration Number: 423-P010178578A-000-000-0000000-0000  
 Registration Date/Time: 10/01/2023 19:39  
 HERS Provider: CHEERS  
 NOTE: This document has been generated by California Home Energy Efficiency Rating Services (CHEERS) using information uploaded by third parties not affiliated with or related to CHEERS. Therefore, CHEERS is not responsible for, and cannot guarantee, the accuracy or completeness of the information contained in this document.  
 CA Building Energy Efficiency Standards - 2022 Residential Compliance  
 Report Version: 2022.0.000  
 Schema Version: rev 20220901  
 Report Generated: 2023-10-01 08:04:38

**CERTIFICATE OF COMPLIANCE - RESIDENTIAL PERFORMANCE COMPLIANCE METHOD** CF1R-PRF-01E  
**Project Name:** Evans Residence Calculation Date/Time: 2023-10-01T08:03:53-07:00  
**Calculation Description:** Title 24 Analysis Input File Name: 23-347 EvansEA.rbd22x (Page 2 of 12)

ENERGY USE SUMMARY						
Energy Use	Standard Design Source Energy (EDR1) (kBtu/ft <sup>2</sup> - yr)	Standard Design TDV Energy (EDR2) (KTDV/ft <sup>2</sup> - yr)	Proposed Design Source Energy (EDR1) (kBtu/ft <sup>2</sup> - yr)	Proposed Design TDV Energy (EDR2) (KTDV/ft <sup>2</sup> - yr)	Compliance Margin (EDR1)	Compliance Margin (EDR2)
Space Heating	0	7.69	0	8.17	0	-0.48
Space Cooling	0	19.16	0	17.91	0	1.25
IAQ Ventilation	0	0	0	0	0	0
Water Heating	0	32.16	0	32.16	0	0
Self Utilization/Flexibility Credit						
Efficiency Compliance Total	0	59.01	0	58.24	0	0.77
Photovoltaics	0		0			
Battery				0		
Flexibility						
Indoor Lighting	0	7.27	0	7.27		
Appl. & Cooking	0	22.4	0	22.38		
Plug Loads	0	32.09	0	32.09		
Outdoor Lighting	0	1.75	0	1.75		
<b>TOTAL COMPLIANCE</b>	<b>0</b>	<b>122.52</b>	<b>0</b>	<b>121.73</b>		

Registration Number: 423-P010178578A-000-000-0000000-0000  
 Registration Date/Time: 10/01/2023 19:39  
 HERS Provider: CHEERS  
 NOTE: This document has been generated by California Home Energy Efficiency Rating Services (CHEERS) using information uploaded by third parties not affiliated with or related to CHEERS. Therefore, CHEERS is not responsible for, and cannot guarantee, the accuracy or completeness of the information contained in this document.  
 CA Building Energy Efficiency Standards - 2022 Residential Compliance  
 Report Version: 2022.0.000  
 Schema Version: rev 20220901  
 Report Generated: 2023-10-01 08:04:38

**CERTIFICATE OF COMPLIANCE - RESIDENTIAL PERFORMANCE COMPLIANCE METHOD** CF1R-PRF-01E  
**Project Name:** Evans Residence Calculation Date/Time: 2023-10-01T08:03:53-07:00  
**Calculation Description:** Title 24 Analysis Input File Name: 23-347 EvansEA.rbd22x (Page 4 of 12)

ZONE INFORMATION						
01	02	03	04	05	06	07
Zone Name	Zone Type	HVAC System Name	Zone Floor Area (ft <sup>2</sup> )	Avg. Ceiling Height	Water Heating System 1	Status
Addition	Conditioned	n) heat pump1	65	8	DHW Sys 1	New
existing	Conditioned	n) heat pump1	1718	8	DHW Sys 1	Existing

OPAQUE SURFACES										
01	02	03	04	05	06	07	08	09	10	11
Name	Zone	Construction	Azimuth	Orientation	Gross Area (ft <sup>2</sup> )	Window and Door Area (ft <sup>2</sup> )	Tilt (deg)	Wall Exceptions	Status	Verified Existing Condition
Front Wall	Addition	R-13 Wall	290	Front	65	8	90	none	New	n/a
Right Wall	Addition	R-13 Wall	200	Right	65	12	90	none	New	n/a
Front Wall	existing	R-11 Wall	290	Front	281	76	90	none	Existing	No
Left Wall	existing	R-11 Wall	20	Left	425	66	90	none	Existing	No
back Wall	existing	R-11 Wall	110	Back	281	24.3	90	none	Existing	No
Right Wall 2	existing	R-11 Wall	200	Right	495	65	90	none	Existing	No
Front Wall 2	existing	R-11 Wall	290	Front	65	6	90	none	Existing	No
Left Wall 2	existing	R-11 Wall	20	Left	216	40	90	none	Existing	No
back Wall 2	existing	R-11 Wall	110	Back	130	24	90	none	Existing	No
Right Wall 3	existing	R-11 Wall	200	Right	152	8	90	none	Existing	No
to 2e	Addition->existing	R-0 Wall	n/a	n/a	65	0	n/a		New	n/a
to 2e 2	Addition->existing	R-0 Wall	n/a	n/a	65	0	n/a		New	n/a
Roof	Addition	R-30 Roof Attic	n/a	n/a	65	n/a	n/a		New	n/a
Roof 2	existing	R-19 Roof Attic	n/a	n/a	1005	n/a	n/a		Existing	No
Roof 3	existing	R-19 Roof Attic	n/a	n/a	324	n/a	n/a		Existing	No
Raised Floor	existing	R-19 Floor Crawlspace	n/a	n/a	1394	n/a	n/a		Existing	No

Registration Number: 423-P010178578A-000-000-0000000-0000  
 Registration Date/Time: 10/01/2023 19:39  
 HERS Provider: CHEERS  
 NOTE: This document has been generated by California Home Energy Efficiency Rating Services (CHEERS) using information uploaded by third parties not affiliated with or related to CHEERS. Therefore, CHEERS is not responsible for, and cannot guarantee, the accuracy or completeness of the information contained in this document.  
 CA Building Energy Efficiency Standards - 2022 Residential Compliance  
 Report Version: 2022.0.000  
 Schema Version: rev 20220901  
 Report Generated: 2023-10-01 08:04:38

**TABLE OF CONTENTS**

Cover Page	1
Table of Contents	2
Form CF1R-PRF-01-E Certificate of Compliance	3
Form RMS-1 Residential Measures Summary	15
Form MF1R Mandatory Measures Summary	17
HVAC System Heating and Cooling Loads Summary	22



[Handwritten Signature]

Drawn By:
NN

Drawing Date:
October 10, 2023

Revisions:

Table with 3 columns: revision, date, notes

CERTIFICATE OF COMPLIANCE - RESIDENTIAL PERFORMANCE COMPLIANCE METHOD CF1R-PRF-01E

Project Name: Evans Residence Calculation Date/Time: 2023-10-01T08:03:53-07:00
Calculation Description: Title 24 Analysis Input File Name: 23-347 EvansEA-ribd22x (Page 5 of 12)

Table with 11 columns: O1-O11. Headers: Name, Zone, Construction, Azimuth, Orientation, Gross Area (ft²), Window and Door Area (ft²), Tilt (deg), Wall Exceptions, Status, Verified Existing Condition.

Table with 10 columns: O1-O10. Headers: Name, Construction, Type, Roof Rise (x in 12), Roof Reflectance, Roof Emittance, Radiant Barrier, Cool Roof, Status, Verified Existing Condition.

FENESTRATION / GLAZING

Table with 16 columns: O1-O16. Headers: Name, Type, Surface, Orientation, Azimuth, Width (ft), Height (ft), Mult., Area (ft²), U-factor, U-factor Source, SHGC, SHGC Source, Exterior Shading, Status, Verified Existing Condition.

Registration Number: 423-P010178578A-000-000-0000000-0000 Registration Date/Time: 10/01/2023 19:39 HERS Provider: CHEERS
NOTE: This document has been generated by California Home Energy Efficiency Rating Services (CHEERS) using information uploaded by third parties not affiliated with or related to CHEERS. Therefore, CHEERS is not responsible for, and cannot guarantee, the accuracy or completeness of the information contained in this document.
CA Building Energy Efficiency Standards - 2022 Residential Compliance Report Version: 2022.0.000 Report Generated: 2023-10-01 08:04:38
Schema Version: rev 20220901

CERTIFICATE OF COMPLIANCE - RESIDENTIAL PERFORMANCE COMPLIANCE METHOD CF1R-PRF-01E

Project Name: Evans Residence Calculation Date/Time: 2023-10-01T08:03:53-07:00
Calculation Description: Title 24 Analysis Input File Name: 23-347 EvansEA-ribd22x (Page 7 of 12)

Table with 16 columns: O1-O16. Headers: Name, Type, Surface, Orientation, Azimuth, Width (ft), Height (ft), Mult., Area (ft²), U-factor, U-factor Source, SHGC, SHGC Source, Exterior Shading, Status, Verified Existing Condition.

OPAQUE SURFACE CONSTRUCTIONS

Table with 8 columns: O1-O8. Headers: Construction Name, Surface Type, Construction Type, Framing, Total Cavity R-value, Interior / Exterior Continuous R-value, U-factor, Assembly Layers.

Registration Number: 423-P010178578A-000-000-0000000-0000 Registration Date/Time: 10/01/2023 19:39 HERS Provider: CHEERS
NOTE: This document has been generated by California Home Energy Efficiency Rating Services (CHEERS) using information uploaded by third parties not affiliated with or related to CHEERS. Therefore, CHEERS is not responsible for, and cannot guarantee, the accuracy or completeness of the information contained in this document.
CA Building Energy Efficiency Standards - 2022 Residential Compliance Report Version: 2022.0.000 Report Generated: 2023-10-01 08:04:38
Schema Version: rev 20220901

CERTIFICATE OF COMPLIANCE - RESIDENTIAL PERFORMANCE COMPLIANCE METHOD CF1R-PRF-01E

Project Name: Evans Residence Calculation Date/Time: 2023-10-01T08:03:53-07:00
Calculation Description: Title 24 Analysis Input File Name: 23-347 EvansEA-ribd22x (Page 9 of 12)

Table with 12 columns: O1-O12. Headers: Name, System Type, Distribution Type, Water Heater Name, Number of Units, Solar Heating System, Compact Distribution, HERS Verification, Water Heater Name (P), Status, Verified Existing Condition, Existing Water Heating System.

WATER HEATERS

Table with 15 columns: O1-O15. Headers: Name, Heating Element Type, Tank Type, # of Units, Tank Vol. (gal), Heating Efficiency Type, Efficiency, Rated Input Type, Input Rating or Pilot, Tank Insulation R-value (Int/Ext), Standby Loss or Recovery Eff, 1st Hc. Rating or Flow Rate, Tank Location, Status, Verified Existing Condition.

WATER HEATING - HERS VERIFICATION

Table with 7 columns: O1-O7. Headers: Name, Pipe Insulation, Parallel Piping, Compact Distribution, Compact Distribution Type, Recirculation Control, Shower Drain Water Heat Recovery.

SPACE CONDITIONING SYSTEMS

Table with 12 columns: O1-O12. Headers: Name, System Type, Heating Unit Name, Heating Equipment Count, Cooling Unit Name, Cooling Equipment Count, Fan Name, Distribution Name, Required Thermostat Type, Status, Verified Existing Condition, Existing HVAC System.

Registration Number: 423-P010178578A-000-000-0000000-0000 Registration Date/Time: 10/01/2023 19:39 HERS Provider: CHEERS
NOTE: This document has been generated by California Home Energy Efficiency Rating Services (CHEERS) using information uploaded by third parties not affiliated with or related to CHEERS. Therefore, CHEERS is not responsible for, and cannot guarantee, the accuracy or completeness of the information contained in this document.
CA Building Energy Efficiency Standards - 2022 Residential Compliance Report Version: 2022.0.000 Report Generated: 2023-10-01 08:04:38
Schema Version: rev 20220901

CERTIFICATE OF COMPLIANCE - RESIDENTIAL PERFORMANCE COMPLIANCE METHOD CF1R-PRF-01E

Project Name: Evans Residence Calculation Date/Time: 2023-10-01T08:03:53-07:00
Calculation Description: Title 24 Analysis Input File Name: 23-347 EvansEA-ribd22x (Page 6 of 12)

Table with 16 columns: O1-O16. Headers: Name, Type, Surface, Orientation, Azimuth, Width (ft), Height (ft), Mult., Area (ft²), U-factor, U-factor Source, SHGC, SHGC Source, Exterior Shading, Status, Verified Existing Condition.

FENESTRATION / GLAZING

Table with 16 columns: O1-O16. Headers: Name, Type, Surface, Orientation, Azimuth, Width (ft), Height (ft), Mult., Area (ft²), U-factor, U-factor Source, SHGC, SHGC Source, Exterior Shading, Status, Verified Existing Condition.

Registration Number: 423-P010178578A-000-000-0000000-0000 Registration Date/Time: 10/01/2023 19:39 HERS Provider: CHEERS
NOTE: This document has been generated by California Home Energy Efficiency Rating Services (CHEERS) using information uploaded by third parties not affiliated with or related to CHEERS. Therefore, CHEERS is not responsible for, and cannot guarantee, the accuracy or completeness of the information contained in this document.
CA Building Energy Efficiency Standards - 2022 Residential Compliance Report Version: 2022.0.000 Report Generated: 2023-10-01 08:04:38
Schema Version: rev 20220901

CERTIFICATE OF COMPLIANCE - RESIDENTIAL PERFORMANCE COMPLIANCE METHOD CF1R-PRF-01E

Project Name: Evans Residence Calculation Date/Time: 2023-10-01T08:03:53-07:00
Calculation Description: Title 24 Analysis Input File Name: 23-347 EvansEA-ribd22x (Page 8 of 12)

Table with 8 columns: O1-O8. Headers: Construction Name, Surface Type, Construction Type, Framing, Total Cavity R-value, Interior / Exterior Continuous R-value, U-factor, Assembly Layers.

OPAQUE SURFACE CONSTRUCTIONS

Table with 8 columns: O1-O8. Headers: Construction Name, Surface Type, Construction Type, Framing, Total Cavity R-value, Interior / Exterior Continuous R-value, U-factor, Assembly Layers.

BUILDING ENVELOPE - HERS VERIFICATION

Table with 5 columns: O1-O5. Headers: Quality Insulation Installation (QII), High R-value Spray Foam Insulation, Building Envelope Air Leakage, CFM50, CFM50.

Registration Number: 423-P010178578A-000-000-0000000-0000 Registration Date/Time: 10/01/2023 19:39 HERS Provider: CHEERS
NOTE: This document has been generated by California Home Energy Efficiency Rating Services (CHEERS) using information uploaded by third parties not affiliated with or related to CHEERS. Therefore, CHEERS is not responsible for, and cannot guarantee, the accuracy or completeness of the information contained in this document.
CA Building Energy Efficiency Standards - 2022 Residential Compliance Report Version: 2022.0.000 Report Generated: 2023-10-01 08:04:38
Schema Version: rev 20220901

CERTIFICATE OF COMPLIANCE - RESIDENTIAL PERFORMANCE COMPLIANCE METHOD CF1R-PRF-01E

Project Name: Evans Residence Calculation Date/Time: 2023-10-01T08:03:53-07:00
Calculation Description: Title 24 Analysis Input File Name: 23-347 EvansEA-ribd22x (Page 10 of 12)

Table with 13 columns: O1-O13. Headers: Name, System Type, Number of Units, Heating Efficiency Type, HSPF / HSPF2 / COP, Cap 47, Cap 17, Efficiency Type, SEER / SEER2, EER / EER / CEER, Zonally Controlled, Compressor Type, HERS Verification.

HVAC HEAT PUMPS - HERS VERIFICATION

Table with 9 columns: O1-O9. Headers: Name, Verified Airflow, Airflow Target, Verified EER/EER2, Verified SEER/SEER2, Verified Refrigerant Charge, Verified HSPF/HSPF2, Verified Heating Cap 47, Verified Heating Cap 17.

HVAC - DISTRIBUTION SYSTEMS

Table with 16 columns: O1-O16. Headers: Name, Type, Design Type, Duct Ins. R-value, Duct Location, Surface Area, Bypass Duct, Duct Leakage, HERS Verification, Status, Verified Existing Condition, Existing Distribution System, New Ducts 25 ft.

Registration Number: 423-P010178578A-000-000-0000000-0000 Registration Date/Time: 10/01/2023 19:39 HERS Provider: CHEERS
NOTE: This document has been generated by California Home Energy Efficiency Rating Services (CHEERS) using information uploaded by third parties not affiliated with or related to CHEERS. Therefore, CHEERS is not responsible for, and cannot guarantee, the accuracy or completeness of the information contained in this document.
CA Building Energy Efficiency Standards - 2022 Residential Compliance Report Version: 2022.0.000 Report Generated: 2023-10-01 08:04:38
Schema Version: rev 20220901



DESIGNER:

Signature of Designer

Drawn By: NN

Drawing Date: October 10, 2023

Revisions:

Table with columns: revision, date, notes

Table with columns: revision, date, notes

Table with columns: revision, date, notes

2022 Single-Family Residential Mandatory Requirements Summary



NOTE: Single-family residential buildings subject to the Energy Codes must comply with all applicable mandatory measures, regardless of the compliance approach used. Review the respective section for more information. (04/2022)

Building Envelope:

- § 110.6(a)1: Air Leakage. Manufactured fenestration, exterior doors, and exterior pet doors must limit air leakage to 0.3 CFM per square foot or less when tested per NFRC-60, ASTM E283, or AIAA/NWMA/CSA 1011.5.2(2444)-2011.
§ 110.6(a)5: Labeling. Fenestration products and exterior doors must have a label meeting the requirements of § 10-111(a).
§ 110.6(b): Field fabricated exterior doors and fenestration products must use U-factors and solar heat gain coefficient (SHGC) values from Tables 110.6-A, 110.6-B, or J4.5 for exterior doors. They must be caulked and/or weather-stripped.
§ 110.7: Air Leakage. All joints, penetrations, and other openings in the building envelope that are potential sources of air leakage must be caulked, gasketed, or weather-stripped.
§ 110.8(a): Insulation Certification by Manufacturers. Insulation must be certified by the Department of Consumer Affairs, Bureau of Household Goods and Services (BHGS).
§ 110.8(g): Insulation Requirements for Heated Slab Floors. Heated slab floors must be insulated per the requirements of § 110.8(g).
§ 110.8(i): Roofing Products Solar Reflectance and Thermal Emittance. The thermal emittance and aged solar reflectance values of the roofing material must meet the requirements of § 110.8(i) and be labeled per § 110-113 when the installation of a cool roof is specified on the CFR.
§ 110.8(j): Radiant Barrier. When required, radiant barriers must have an emittance of 0.05 or less and be certified to the Department of Consumer Affairs.
§ 150.0(a): Roof Deck, Ceiling and Rafter Roof Insulation. Roof decks in newly constructed attics in climate zones 4 and 8-16 area-weighted average U-factor not exceeding U-0.184. Ceiling and rafter roofs minimum R-22 insulation in wood-frame ceiling, or area-weighted average U-factor must not exceed 0.043. Rafter roof alterations minimum R-19 or area-weighted average U-factor of 0.054 or less. Attic access doors must have permanently attached insulation using adhesive or mechanical fasteners. The attic access must be gasketed to prevent air leakage. Insulation must be installed in direct contact with a roof or ceiling which is sealed to limit infiltration and exfiltration, as specified in § 110.7, including but not limited to placing insulation either above or below the roof deck or on top of a drywall ceiling.
§ 150.0(b): Loose-fill Insulation. Loose fill insulation must meet the manufacturer's required density for the labeled R-value.
§ 150.0(c): Wall Insulation. Minimum R-13 insulation in 2x4 inch wood framing wall or have a U-factor of 0.102 or less, or R-20 in 2x6 inch wood framing or have a U-factor of 0.071 or less. Oppose non-framed assemblies must have an overall assembly U-factor not exceeding 0.102. Masonry walls must meet Tables 150.1-A or B.
§ 150.0(d): Raised-floor Insulation. Minimum R-19 insulation in raised wood framed floor or 0.037 maximum U-factor.
§ 150.0(f): Slab Edge Insulation. Slab edge insulation must meet all of the following: have a water vapor permeance no greater than 2.0 perm per inch; be protected from physical damage and UV light deterioration; and, when installed as part of a heated slab floor, meet the requirements of § 110.8(g).
§ 150.0(g)1: Vapor Retarder. In climate zones 1 through 16, the earth floor or unvented crawl space must be covered with a Class I or Class II vapor retarder. This requirement also applies to controlled ventilation crawl space for buildings complying with the exception to § 150.0(g).
§ 150.0(g)2: Vapor Retarder. In climate zones 14 and 16, a Class I or Class II vapor retarder must be installed on the conditioned space side of all insulation in all exterior walls, vented attics, and unvented attics with air-permeable insulation.
§ 150.0(i): Fenestration Products. Fenestration, including skylights, separating conditioned space from unconditioned space or outdoors must have a maximum U-factor of 0.45; or area-weighted average U-factor of all fenestration must not exceed 0.45.
Fireplaces, Decorative Gas Appliances, and Gas Log:
§ 110.5(e): Pilot Light. Continuously burning pilot lights are not allowed for indoor and outdoor fireplaces.
§ 150.0(e)1: Closable Doors. Masonry or factory-built fireplaces must have a closable metal or glass door covering the entire opening of the firebox.
§ 150.0(e)2: Combustion Intake. Masonry or factory-built fireplaces must have a combustion outside air intake, which is at least six square inches in area and is equipped with a readily accessible, operable, and light-firing damper or combustion-air control device.
§ 150.0(e)3: Flue Damper. Masonry or factory-built fireplaces must have a flue damper with a readily accessible control.
Space Conditioning, Water Heating, and Plumbing System:
§ 110.4-§ 110.3: Certification. Heating, ventilation, and air conditioning (HVAC) equipment, water heaters, showerheads, faucets, and all other regulated appliances must be certified by the manufacturer to the California Energy Commission.
§ 110.2(a): HVAC Efficiency. Equipment must meet the applicable efficiency requirements in Table 110.2-A through Table 110.2-N.
§ 110.2(b): Controls for Heat Pumps with Supplementary Electric Resistance Heaters. Heat pumps with supplementary electric resistance heaters must have controls that prevent supplementary heater operation when the heating load can be met by the heat pump alone; and in which the cut-on temperature for compression heating is higher than the cut-on temperature for supplementary heating; and the cut-off temperature for compression heating is higher than the cut-off temperature for supplementary heating.
§ 110.2(c): Thermostats. All heating or cooling systems not controlled by a central energy management control system (EMCS) must have a setback thermostat.
§ 110.2(c): Insulation. Unfired service water heater storage tanks and solar water-heating backup tanks must have adequate insulation, or tank surface heat loss rating.
§ 110.3(c): Isolation Valves. Instantaneous water heaters with an input rating greater than 6.9 kBtu per hour (2 kW) must have isolation valves with hose bibbs or other fittings on both cold and hot water lines to allow for flushing the water heater when the valves are closed.
§ 110.3(c): Solar Water-heating Systems. Solar water-heating systems and collectors must be certified and rated by the Solar Rating and Certification Corporation (SRCC), the International Association of Plumbing and Mechanical Officials, Research and Testing (IAPMO R&T), or by a listing agency that is approved by the executive director.






RESIDENTIAL MEASURES SUMMARY RMS-1

Table with columns: Project Name, Building Type, Date, Project Address, California Energy Climate Zone, Total Cond. Floor Area, Addition, # of Units

INSULATION table with columns: Construction Type, Cavity, Area (ft²), Special Features, Status

FENESTRATION table with columns: Orientation, Area (ft²), U-Fac, SHGC, Overhang, Sidesfins, Exterior Shades, Status

HVAC SYSTEMS table with columns: Qty., Heating, Min. Eff, Cooling, Min. Eff, Thermostat, Status

HVAC DISTRIBUTION table with columns: Location, Heating, Cooling, Duct Location, Duct R-Value, Status

WATER HEATING table with columns: Qty., Type, Gallons, Min. Eff, Distribution, Status

EnergyPro 9.2 by EnergySoft User Number: 1082 ID: 23-347 Page 15 of 22

CERTIFICATE OF COMPLIANCE - RESIDENTIAL PERFORMANCE COMPLIANCE METHOD CF1R-PRF-01E

Project Name: Evans Residence Calculation Date/Time: 2023-10-01T08:03:53-07:00
Calculation Description: Title 24 Analysis Input File Name: 23-347 EvansEA-ribd22x (Page 11 of 12)

HVAC DISTRIBUTION - HERS VERIFICATION table with columns: 01, 02, 03, 04, 05, 06, 07, 08, 09

HVAC - FAN SYSTEMS table with columns: 01, 02, 03, 04

HVAC FAN SYSTEMS - HERS VERIFICATION table with columns: 01, 02, 03

Registration Number: 423-P010178578A-000-000-0000000-0000
NOTE: This document has been generated by California Home Energy Efficiency Rating Service (CHEERS) using information uploaded by third parties not affiliated with or related to CHEERS. Therefore, CHEERS is not responsible for, and cannot guarantee, the accuracy or completeness of the information contained in this document.
CA Building Energy Efficiency Standards - 2022 Residential Compliance Report Version: 2022.0.000 Report Generated: 2023-10-01 08:04:38
Schema Version: rev 20220901

CERTIFICATE OF COMPLIANCE - RESIDENTIAL PERFORMANCE COMPLIANCE METHOD CF1R-PRF-01E

Project Name: Evans Residence Calculation Date/Time: 2023-10-01T08:03:53-07:00
Calculation Description: Title 24 Analysis Input File Name: 23-347 EvansEA-ribd22x (Page 12 of 12)

DOCUMENTATION AUTHOR'S DECLARATION STATEMENT

Table with columns: Documentation Author Name, Signature, Date, Address, City/State/Zip

RESPONSIBLE PERSON'S DECLARATION STATEMENT

- I, certify that this Certificate of Compliance documentation is accurate and complete.
1. I am eligible under Division 3 of the Business and Professions Code to accept responsibility for the building design identified on this Certificate of Compliance.
2. I certify that the energy features and performance specifications identified on this Certificate of Compliance conform to the requirements of Title 24, Part 1 and Part 6 of the California Code of Regulations.
3. The building design features or system design features identified on this Certificate of Compliance are consistent with the information provided on other applicable compliance documents, worksheets, calculations, plans and specifications submitted to the enforcement agency for approval with this building permit application.

Table with columns: Responsible Designer Name, Signature, Date Signed, License, Address, City/State/Zip

Digitally signed by California Home Energy Efficiency Rating Service (CHEERS). This digital signature is provided in order to secure the content of this registered document, and to not require Registration Provider responsibility for the accuracy of the information.
Registration Number: 423-P010178578A-000-000-0000000-0000
NOTE: This document has been generated by California Home Energy Efficiency Rating Service (CHEERS) using information uploaded by third parties not affiliated with or related to CHEERS. Therefore, CHEERS is not responsible for, and cannot guarantee, the accuracy or completeness of the information contained in this document.
CA Building Energy Efficiency Standards - 2022 Residential Compliance Report Version: 2022.0.000 Report Generated: 2023-10-01 08:04:38
Schema Version: rev 20220901

RESIDENTIAL MEASURES SUMMARY RMS-1

Table with columns: Project Name, Building Type, Date, Project Address, California Energy Climate Zone, Total Cond. Floor Area, Addition, # of Units

INSULATION table with columns: Construction Type, Cavity, Area (ft²), Special Features, Status

FENESTRATION table with columns: Orientation, Area (ft²), U-Fac, SHGC, Overhang, Sidesfins, Exterior Shades, Status

HVAC SYSTEMS table with columns: Qty., Heating, Min. Eff, Cooling, Min. Eff, Thermostat, Status

HVAC DISTRIBUTION table with columns: Location, Heating, Cooling, Duct Location, Duct R-Value, Status

WATER HEATING table with columns: Qty., Type, Gallons, Min. Eff, Distribution, Status

EnergyPro 9.2 by EnergySoft User Number: 1082 ID: 23-347 Page 16 of 22

2022 Single-Family Residential Mandatory Requirements Summary



NOTE: Single-family residential buildings subject to the Energy Codes must comply with all applicable mandatory measures, regardless of the compliance approach used. Review the respective section for more information. (04/2022)

Building Envelope:

- § 110.5: Pilot Lights. Continuously burning pilot lights are prohibited for natural gas, fan-type central furnaces, household cooking appliances (except appliances without an electrical supply voltage connection with pilot lights that consume less than 150 Btu per hour), and pool and spa heaters.
§ 150.0(h)1: Building Cooling and Heating Loads. Heating and/or cooling loads are calculated in accordance with the ASHRAE Handbook, Equipment Volume, Applications Volume, and Fundamentals Volume, the SMACNA Residential Comfort System Installation Standards Manual; or the ACCA Manual J using design conditions specified in § 150.0(h)2.
§ 150.0(h)3A: Clearances. Air conditioner and heat pump outdoor condensing units must have a clearance of at least five feet from the outlet of any dryer.
§ 150.0(h)3B: Liquid Line Drier. Air conditioners and heat pump systems must be equipped with liquid line filter driers if required, as specified by the manufacturer's instructions.
§ 150.0(i): Water Piping, Solar Water-heating System Piping, and Space Conditioning System Line Insulation. All domestic hot water piping must be insulated as specified in § 609.11 of the California Plumbing Code.
§ 150.0(j)2: Insulation Protection. Piping insulation must be protected from damage, including that due to sunlight, moisture, equipment maintenance, and wind as required by § 120.3(b). Insulation exposed to weather must be water retardant and protected from UV light (no adhesive tapes). Insulation covering chilled water piping and refrigerant suction piping located outside the conditioned space must include, or be protected by, a Class I or Class II vapor retarder. Pipe insulation buried below grade must be installed in a waterproof and non-crushable casing or sleeve.
§ 150.0(j)1: Gas or Propane Water Heating Systems. Systems using gas or propane water heaters to serve individual dwelling units must designate a space at least 2.5 x 2.5 x 7' suitable for the future installation of a heat pump water heater, and meet electrical and plumbing requirements, based on the distance between the designated space and the water heater location; and a condensate drain no more than 2' higher than the base of the water heater.
§ 150.0(k)3: Solar Water-heating Systems. Solar water-heating systems and collectors must be certified and rated by the Solar Rating and Certification Corporation (SRCC), the International Association of Plumbing and Mechanical Officials, Research and Testing (IAPMO R&T), or by a listing agency that is approved by the executive director.

Ducts and Fans:

- § 110.8(j)3: Ducts. Insulation installed on an existing space-conditioning duct must comply with § 604.0 of the California Mechanical Code (CMC). If a contractor installs the insulation, the contractor must certify to the customer, in writing, that the insulation meets this requirement.
§ 150.0(m)1: CMC Compliance. All air-distribution system ducts and plenums must meet CMC §§ 601.0-605.0 and ANSISMACNA-006-2006 HVAC Duct Construction Standards Metal and Flexible 3rd Edition. Portions of supply-air and return-air ducts and plenums must be insulated to R-6.0 or higher; ducts located entirely in conditioned space as confirmed through field verification and diagnostic testing (RA3.1.4.3.9) do not require insulation. Connections of metal ducts and inner core of flexible ducts must be mechanically fastened. Openings must be sealed with mastic, tape, or other duct-closure system that meets the applicable UL requirements, or aerosol sealant that meets UL 723. The combination of mastic and either mesh or tape must be used to seal openings greater than 1/4". If mastic or tape is used, Building cavities, air handler support platforms, and plenums designed or constructed with materials other than sealed sheet metal, duct board or flexible duct must not be used to convey conditioned air. Building cavities and support platforms may contain ducts; ducts installed in these spaces must not be compressed.
§ 150.0(m)2: Factory-Fabricated Duct Systems. Factory-fabricated duct systems must comply with applicable requirements for duct construction, connections, and closures; joints and seams of duct systems and their components must not be sealed with cloth back rubber adhesive duct tapes unless such tape is used in combination with mastic and draw bands.
§ 150.0(m)3: Field-Fabricated Duct Systems. Field-fabricated duct systems must comply with applicable requirements for: pressure-sensitive tapes, mastics, sealants, and other requirements specified for duct construction.
§ 150.0(m)7: Backdraft Damper. Fan systems that exchange air between the conditioned space and outdoors must have backdraft or automatic dampers.
§ 150.0(m)6: Gravity Ventilation Dampers. Gravity ventilating systems serving conditioned space must have either automatic or readily accessible, manually operated dampers in all openings to the outside, except combustion inlet and outlet air openings and elevator shaft vents.
§ 150.0(m)9: Protection of Insulation. Insulation must be protected from damage due to sunlight, moisture, equipment maintenance, and wind. Insulation exposed to weather must be suitable for outdoor service (e.g., protected by aluminum, sheet metal, painted canvas, or plastic cover). Cellular foam insulation must be protected as above or painted with a water retardant and solar radiation-resistant coating.
§ 150.0(m)10: Porous Inner Core Flex Duct. Porous inner cores of flex ducts must have a non-porous layer or air barrier between the inner core and outer vapor barrier.
§ 150.0(m)11: Duct System Sealing and Leakage Test. When space conditioning systems use forced air duct systems to supply conditioned air to an occupiable space, the ducts must be sealed and duct leakage tested, as confirmed through field verification and diagnostic testing, in accordance with Reference Residential Appendix RA3.1.
§ 150.0(m)12: Air Filtration. Space conditioning systems with ducts exceeding 10 feet and the supply side of ventilation systems must have MERV 13 or equivalent filters. Filters for space conditioning systems must have a two inch depth or can be one inch if labeled per Equation 150.0-A. Clean-filter pressure drop and labeling must meet the requirements in § 150.0(m)12. Filters must be accessible for regular service. Filter racks or grilles must use gaskets, sealing, or other means to close gaps around the inserted filters to and prevents air from bypassing the filter.



revision	date	notes

2022 Single-Family Residential Mandatory Requirements Summary

§ 150.0(m)3: **Space Conditioning System Airflow Rate and Fan Efficiency.** Space conditioning systems that use ducts to supply cooling must have a hole for the placement of a static pressure probe, or a permanently installed static pressure probe in the supply plenum. Airflow must be ≥ 250 CFM per ton of nominal cooling capacity, and an air-handling unit fan efficiency ≤ 0.45 watts per CFM for gas furnace air handlers and ≤ 0.56 watts per CFM for all others. Small duct high velocity systems must provide an airflow ≥ 250 CFM per ton of nominal cooling capacity, and an air-handling unit fan efficiency ≤ 0.62 watts per CFM. Field verification testing is required in accordance with Reference Residential Appendix RA3.3. \*

**Ventilation and Indoor Air Quality:**  
 § 150.0(i): **Requirements for Ventilation and Indoor Air Quality.** All dwelling units must meet the requirements of ASHRAE Standard 62.2, Ventilation and Acceptable Indoor Air Quality in Residential Buildings subject to the amendments specified in § 150.0(i)1. \*  
 § 150.0(i)1B: **Central Fan Integrated (CFI) Ventilation Systems.** Continuous operation of CFI air handlers is not allowed to provide the whole-dwelling unit ventilation airflow required per § 150.0(i)1C. A motorized damper(s) must be installed on the ventilation duct(s) that prevents all airflow through the space conditioning duct system when the damper(s) is closed and controlled per § 150.0(i)1Bii&iv. CFI ventilation systems must have controls that track outdoor air ventilation run time, and either open or close the motorized damper(s) for compliance with § 150.0(i)1C.  
 § 150.0(i)1C: **Whole-Dwelling Unit Mechanical Ventilation for Single-Family Detached and townhouses.** Single-family detached dwelling units, and attached dwelling units not sharing ceilings or floors with other dwelling units, occupiable spaces, public garages, or commercial spaces must have mechanical ventilation airflow specified in § 150.0(i)1Cii.  
 § 150.0(i)1G: **Local Mechanical Exhaust.** Kitchens and bathrooms must have local mechanical exhaust; nonenclosed kitchens must have demand-controlled exhaust system meeting requirements of § 150.0(i)1Gii. Enclosed kitchens and bathrooms can use demand-controlled or continuous exhaust meeting § 150.0(i)1Gii-iv. Airflow must be measured by the installer per § 150.0(i)1Gv, and rated for sound per § 150.0(i)1Gvi. \*

**Pool and Spa Systems and Equipment:**  
 § 110.4(a): **Certification by Manufacturers.** Any pool or spa heating system or equipment must be certified to have all of the following: compliance with the Appliance Efficiency Regulations and listing in MACTDS; an on-off switch mounted outside of the heater that allows shutting off the heater without adjusting the thermostat setting; a permanent weatherproof plate or card with operating instructions; and must not use electric resistance heating. \*  
 § 110.4(b)1: **Piping.** Any pool or spa heating system or equipment must be installed with at least 3/8 inches of pipe between the filter and the heater, or dedicated suction and return lines, or built-in or built-up connections to allow for future solar heating.  
 § 110.4(b)2: **Covers.** Outdoor pools or spas that have a heat pump or gas heater must have a cover.  
 § 110.4(b)3: **Directional Inlets and Time Switches for Pools.** Pools must have directional inlets that adequately mix the pool water, and a time switch that will allow all pumps to be set or programmed to run only during off-peak electric demand periods.  
 § 110.5: **Pilot Light.** Natural gas pool and spa heaters must not have a continuously burning pilot light.  
 § 150.0(p): **Pool Systems and Equipment Installation.** Residential pool systems or equipment must meet the specified requirements for pump sizing, flow rate, piping, filters, and valves. \*

**Lighting:**  
 § 110.9: **Lighting Controls and Components.** All lighting control devices and systems, ballasts, and luminaires must meet the applicable requirements of § 110.9. \*  
 § 150.0(k)1A: **Luminaire Efficacy.** All installed luminaires must meet the requirements in Table 150.0-A, except lighting integral to exhaust fans, kitchen range hoods, built vanity mirrors, and garage door openers; navigation lighting less than 5 watts; and lighting internal to drawers, cabinets, and linen closets with an efficacy of at least 45 lumens per watt.  
 § 150.0(k)1B: **Screw based luminaires.** Screw based luminaires must contain lamps that comply with Reference Joint Appendix JA8. \*  
 § 150.0(k)1C: **Recessed Downlight Luminaires in Ceilings.** Luminaires recessed into ceilings must not contain screw based sockets, must be airtight, and must be sealed with a gasket or caulk. California Electrical Code § 410.116 must also be met.  
 § 150.0(k)1D: **Light Sources in Enclosed or Recessed Luminaires.** Lamps and other separable light sources that are not compliant with the JA8 elevated temperature requirements, including marking requirements, must not be installed in enclosed or recessed luminaires.  
 § 150.0(k)1E: **Blank Electrical Boxes.** The number of electrical boxes that are more than five feet above the finished floor and do not contain a luminaire or other device shall be no more than the number of bedrooms. These boxes must be served by a dimmer, vacancy sensor control, low voltage wiring, or fan speed control.  
 § 150.0(k)1F: **Lighting Integral to Exhaust Fans.** Lighting integral to exhaust fans (except when installed by the manufacturer in kitchen exhaust hoods) must meet the applicable requirements of § 150.0(k). \*

5/6/22

2022 Single-Family Residential Mandatory Requirements Summary

§ 150.0(k)1G: **Screw based luminaires.** Screw based luminaires must contain lamps that comply with Reference Joint Appendix JA8. \*  
 § 150.0(k)1H: **Light Sources in Enclosed or Recessed Luminaires.** Lamps and other separable light sources that are not compliant with the JA8 elevated temperature requirements, including marking requirements, must not be installed in enclosed or recessed luminaires.  
 § 150.0(k)1I: **Light Sources in Drawers, Cabinets, and Linen Closets.** Light sources internal to drawers, cabinetry or linen closets are not required to comply with Table 150.0-A or be controlled by vacancy sensors provided that they are rated to consume no more than 5 watts of power, emit no more than 150 lumens, and are equipped with controls that automatically turn the lighting off when the drawer, cabinet or linen closet is closed.  
 § 150.0(k)2A: **Interior Switches and Controls.** All forward phase cut dimmers used with LED light sources must comply with NEMA SSL 7A.  
 § 150.0(k)2B: **Accessible Controls.** Lighting must have readily accessible wall-mounted controls that allow the lighting to be manually turned on and off. \*  
 § 150.0(k)2C: **Multiple Controls.** Controls must not bypass a dimmer, occupant sensor, or vacancy sensor function if the dimmer or sensor is installed to comply with § 150.0(k).  
 § 150.0(k)2D: **Mandatory Requirements.** Lighting controls must comply with the applicable requirements of § 110.9.  
 § 150.0(k)2E: **Energy Management Control Systems.** An energy management control system (EMCS) may be used to comply with dimming, occupancy, and control requirements if it provides the functionality of the specified control per § 110.9 and the physical controls specified in § 150.0(k)2A.  
 § 150.0(k)2F: **Automatic Shut-off Controls.** In bathrooms, garages, laundry rooms, utility rooms and walk-in closets, at least one installed luminaire must be controlled by an occupancy or vacancy sensor providing automatic-off functionality. Lighting inside drawers and cabinets with opaque fronts or doors must have controls that turn the light off when the drawer or door is closed.  
 § 150.0(k)2G: **Dimmers.** Lighting in habitable spaces (e.g., living rooms, dining rooms, kitchens, and bedrooms) must have readily accessible wall-mounted dimming controls that allow the lighting to be manually adjusted up and down. Forward phase cut dimmers controlling LED light sources in these spaces must comply with NEMA SSL 7A.  
 § 150.0(k)2K: **Independent controls.** Integrated lighting of exhaust fans shall be controlled independently from the fans. Lighting under cabinets or shelves, lighting in display cabinets, and switched outlets must be controlled separately from ceiling-installed lighting.  
 § 150.0(k)3A: **Residential Outdoor Lighting.** For single-family residential buildings, outdoor lighting permanently mounted to a residential building, or to other buildings on the same lot, must have a manual on/off switch and either a photocell and motion sensor or automatic time switch control) or an astronomical time clock. An energy management control system that provides the specified control functionality and meets all applicable requirements may be used to meet these requirements.  
 § 150.0(k)4: **Internally illuminated address signs.** Internally illuminated address signs must either comply with § 140.8 or consume no more than 5 watts of power.  
 § 150.0(k)5: **Residential Garages for Eight or More Vehicles.** Lighting for residential parking garages for eight or more vehicles must comply with the applicable requirements for nonresidential garages in §§ 110.9, 130.0, 130.1, 130.4, 140.6, and 141.0.

**Solar Readiness:**  
 § 110.10(a)1: **Single-family Residences.** Single-family residences located in subdivisions with 10 or more single-family residences and where the application for a tentative subdivision map for the residences has been deemed complete and approved by the enforcement agency, which do not have a photovoltaic system installed, must comply with the requirements of § 110.10(b)4.  
 § 110.10(b)1A: **Minimum Solar Zone Area.** The solar zone must have a minimum total area as described below. The solar zone must comply with access, pathway, smoke ventilation, and spacing requirements as specified in Title 24, Part 9 or other parts of Title 24 or in any requirements adopted by a local jurisdiction. The solar zone total area must be comprised of areas that have no dimension less than 5 feet and are no less than 80 square feet each for buildings with roof areas less than or equal to 10,000 square feet or no less than 160 square feet each for buildings with roof areas greater than 10,000 square feet. For single-family residences, the solar zone must be located on the roof or overhang of the building and have a total area no less than 250 square feet. \*  
 § 110.10(b)2: **Azimuth.** All sections of the solar zone located on steep-sloped roofs must have an azimuth between 90-300° of true north.  
 § 110.10(b)3A: **Shading.** The solar zone must not contain any obstructions, including but not limited to: vents, chimneys, architectural features, and roof mounted equipment.  
 § 110.10(b)3B: **Shading.** Any obstruction located on the roof or any other part of the building that projects above a solar zone must be located at least twice the horizontal distance of the height difference between the highest point of the obstruction and the horizontal projection of the nearest point of the solar zone, measured in the vertical plane.  
 § 110.10(b)4: **Structural Design Loads on Construction Documents.** For areas of the roof designated as a solar zone, the structural design loads for roof dead load and roof live load must be clearly indicated on the construction documents.  
 § 110.10(c): **Interconnection Pathways.** The construction documents must indicate: a location reserved for inverters and metering equipment and a pathway reserved for routing of conduit from the solar zone to the point of interconnection with the electrical service; and for single-family residences and central water-heating systems, a pathway reserved for routing plumbing from the solar zone to the water-heating system. Documentation. A copy of a construction document or a comparable document indicating the information from § 110.10(b)4-c) must be provided to the occupant.  
 § 110.10(d): **Main Electrical Service Panel.** The main electrical service panel must have a minimum busbar rating of 200 amps.  
 § 110.10(e)1: **Main Electrical Service Panel.** The main electrical service panel must have a reserved space to allow for the installation of a double pole circuit breaker for a future solar electric installation. The reserved space must be permanently marked as "For Future Solar Electric."  
 § 110.10(e)2: **Electric and Energy Storage Ready.**

5/6/22

2022 Single-Family Residential Mandatory Requirements Summary

§ 150.0(x): **Energy Storage System (ESS) Ready.** All single-family residences must meet all of the following: Either ESS-ready interconnection equipment with backed-up capacity of 60 amps or more and four or more ESS supplied branch circuits, or a dedicated raceway from the main service to a subpanel that supplies the branch circuits in § 150.0(x); at least four branch circuits must be identified and have their source collocated at a single panelboard suitable to be supplied by the ESS, with one circuit supplying the refrigerator, one lighting circuit near the primary exit, and one circuit supplying a sleeping room recessed outlet; main panelboard must have a minimum busbar rating of 225 amps, sufficient space must be reserved to allow future installation of a system isolation equipment transfer switch within 3' of the main panelboard, with raceways installed between the panelboard and the switch location to allow the connection of backup power source.  
 § 150.0(y): **Heat Pump Space Heater Ready.** Systems using gas or propane furnaces to serve individual dwelling units must include: A dedicated unobstructed 240V branch circuit wiring installed within 3' of the furnace with circuit conductors rated at least 30 amps with the blank cover identified as "240V ready"; and a reserved main electrical service panel space to allow for the installation of a double pole circuit breaker permanently marked as "For Future 240V use."  
 § 150.0(z): **Electric Cooktop Ready.** Systems using gas or propane cooktop to serve individual dwelling units must include: A dedicated unobstructed 240V branch circuit wiring installed within 3' of the cooktop with circuit conductors rated at least 50 amps with the blank cover identified as "240V ready"; and a reserved main electrical service panel space to allow for the installation of a double pole circuit breaker permanently marked as "For Future 240V use."  
 § 150.0(v): **Electric Clothes Dryer Ready.** Clothes dryer locations with gas or propane plumbing to serve individual dwelling units must include: A dedicated unobstructed 240V branch circuit wiring installed within 3' of the dryer location with circuit conductors rated at least 30 amps with the blank cover identified as "240V ready"; and a reserved main electrical service panel space to allow for the installation of a double pole circuit breaker permanently marked as "For Future 240V use."

\*Exceptions may apply.


5/6/22

HVAC SYSTEM HEATING AND COOLING LOADS SUMMARY

Project Name		Date
Evans Residence		10/1/2023
System Name		Floor Area
n) heat pump		1,783

ENGINEERING CHECKS		SYSTEM LOAD				
Number of Systems		COIL COOLING PEAK		COIL HTG. PEAK		
		CFM	Sensible	Latent	CFM	Sensible
<b>Heating System</b>						
Output per System	48,000					
Total Output (Btuh)	48,000					
Output (Btuh/sqft)	26.9					
<b>Cooling System</b>						
Output per System	42,000					
Total Output (Btuh)	42,000					
Total Output (Tons)	3.5					
Total Output (Btuh/sqft)	23.6					
Total Output (sqft/Ton)	509.4					
<b>Air System</b>						
CFM per System	1,250					
Airflow (cfm)	1,250					
Airflow (cfm/sqft)	0.70					
Airflow (cfm/Ton)	357.1					
Outside Air (%)	0.0%					
Outside Air (cfm/sqft)	0.00					
<b>Total Adjusted System Output</b>						
(Adjusted for Peak Design conditions)		35,722		5,643		
		32,466				
<b>TIME OF SYSTEM PEAK</b>						
		Aug 3 PM		Jan 1 AM		

Note: values above given at ARI conditions

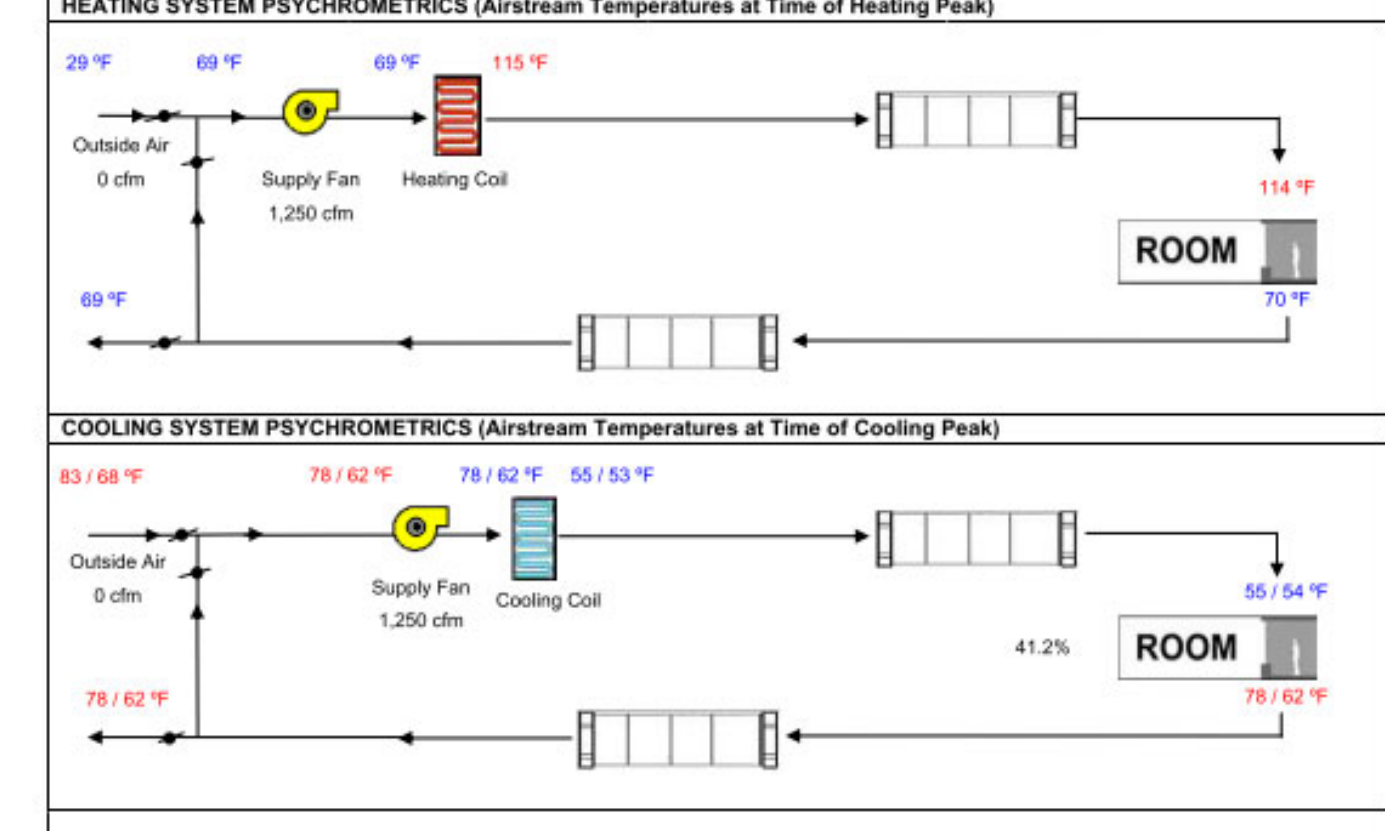



# SPECIFICATIONS

## DIVISION 1 – GENERAL REQUIREMENTS AND CONDITIONS

### I. GENERAL REQUIREMENTS

A. General Conditions: The project specifications, construction drawings and bid package are part of the construction documents.

B. Substitutions: The General Contractor shall inform the Designer in writing of any variances or substitutions to the project specifications or construction drawings with the project bid. Any substitutions or deviation from these documents must be submitted as a proposed alternate and include all information necessary for evaluation together with reason or justification for substitution to the Designer and Owner before the final contract for construction is signed. The written decision accepting or denying the proposed alternate shall govern. It is the responsibility of the General Contractor to obtain approval from the Owner for all materials or items not herein specified.

C. Dimensions:

1. All dimensions and conditions shall be checked and verified by the General Contractor prior to the commencement of work. Any errors or discrepancies shall be brought to the attention of the Designer before construction begins.

2. Reproductions of the construction documents may be subject to distortion. Do not scale construction documents. Contact the Designer or Engineer for any dimension(s) that may appear to be missing.

3. Yard setbacks are to be measured from the exterior wall finish to the property line and not from the outside of footing or face of studs. The plan must be designed with the wall finish thickness (i.e. 7/8" stucco, etc.) added to the plans for setback requirements. The field inspector will add the planned wall finish thickness to the foundation setback. If the wall finish is to be changed after approval, the effect on meeting the setback requirement must be considered to get the change approved by the building and planning departments.

D. These requirements shall apply continuously and not be limited to normal working hours.

1. The General Contractor shall furnish all labor, materials, utensils, utilities, temporary facilities, etc. for the full performance of work specified herein. The General Contractor shall insure the work is to be properly pursued, completed and ready to occupy in a timely manner. The General Contractor shall recycle all demolition and construction waste when possible.

2. The General Contractor shall maintain facilities for the inspection of all work. All hold-downs to be tied in place prior to calling for foundation inspection.

3. The General Contractor shall properly protect all structures, facilities, grounds, plants, trees, paving etc. from damage by natural causes or by acts of carelessness or vandalism.

4. The General Contractor agrees to assume sole and complete responsibility for job site conditions during the course of construction including the safety of all persons and property.

E. The General Contractor shall defend, indemnify and hold the Owner and Consultants harmless from any and all liability, real or alleged, in connection with the performance of the work on this project except for liability arising from the sole negligence of the Owner or Consultants.

F. The General Contractor shall remove all rubbish, leaving the building and site in clean, perfect working order and condition upon completion of the work.

G. All public improvements shall be made in accordance with the latest adopted city standard drawings and specifications. All work shall conform to applicable city ordinances.

H. The General Contractor shall guarantee all work against defective materials or faulty workmanship for a period of one year after the date of final payment.

I. An encroachment permit shall be required for all work in the public right of way.

J. The Contractor shall comply with all OSHA requirements.

### II. SPECIAL REQUIREMENTS

A. Permits, Fees, Taxes, Licenses and Deposits: Shall be paid for by each Subcontractor and the General Contractor as they relate to their work. The Owner shall pay all building permit fees and associated fees. If arrangements are made in advance with the Owner, the General Contractor may pay these fees at the time of issuance of the permit and be reimbursed by the Owner.

B. Code Compliance: Project shall comply with the 2019 California Building Code (CBC) that adopts the 2018 International Building Code (IBC), the 2018 International Residential Code (IRC), the 2018 Uniform Mechanical Code (UMC), the 2018 Uniform Plumbing Code (UPC) and the 2017 National Electric Code (NEC). Compliance with all current adopted Codes, Ordinances, Rules and Regulations governing the work shall be made and/or enforced by the General Contractor and Subcontractors at all times.

C. Special Inspection: Special inspections, as required, shall be arranged for and scheduled by the General Contractor and paid for by the Owner.

D. Deferred Submittals: Submittal documents for deferred submittal items shall be submitted to the designer or engineer of record, who shall review them and forward them to the building official with a notation indicating that the deferred submittal documents have been reviewed and that they have been found to be in general conformance with the design of the building. The deferred submittal items shall not be installed until their design and submittal documents have been approved by the building official. Deferred submittals for this project, if any, are located within the construction documents on sheet T1.

E. Reproduction: These construction documents may not be altered or used at any other location without written authorization of all professionals involved. The project specifications and construction drawings are property of NN Design (Nathaniel Nicodemus) and are protected by copyright. Reproduction in any form without express written permission is prohibited.

### III. TEMPORARY FACILITIES

A. The General Contractor shall provide and maintain all temporary facilities for the project for the duration of the Contract including, but not limited to the following: (Unless otherwise agreed to by the Owner.)

1. Electricity and water.

2. Work site toilet facilities.

3. Fences, barricades and protective devices necessary for the safety of workmen, conforming to all governing laws and regulations.

4. Trash bin.

## DIVISION 2 – SECTION 1 – DEMOLITION

### I. GENERAL REQUIREMENTS

A. Scope: This section includes all labor, material and equipment necessary to complete all work specified herein and as indicated within the construction documents. The work of this section includes, but is not limited to; demolition of all structures, fencing, paving, etc. not specifically noted to remain.

B. Job Conditions: Perform all work in accordance with accepted safety standards. All work areas left exposed during non-working hours shall be sufficiently barricaded to prevent pedestrian or vehicular hazards.

### II. PERFORMANCE OF WORK

A. General Requirements: Contractor to provide all labor, materials and equipment to demolish and legally dispose of all structures, fencing, paving, etc. not specifically noted to remain.

## DIVISION 2 – SECTION 2 – EARTH WORK

### I. GENERAL REQUIREMENTS

A. Scope: This section includes all labor, material and equipment necessary to complete all work specified herein and as indicated within the

construction documents. The work of this section includes, but is not limited to; grading, filling, compaction and backfilling.

B. Special Requirements: All work performed under this section shall be performed by a State of California licensed grading contractor.

C. Job Conditions: Perform all work in accordance with accepted safety standards. All excavation work left exposed during non-working hours shall be sufficiently barricaded to prevent pedestrian or vehicular hazards.

### II. PERFORMANCE OF WORK

A. General Requirements: Contractor to provide all labor, materials and equipment to excavate, backfill, compact and grade as required for a complete finished job. If existing elevations, dimensions and/or site conditions are different from those indicated on the plans, report discrepancy and obtain instructions from Designer before starting work. The Contractor shall be responsible for the accuracy of all work.

B. Preparation for Grading: Verify elevations, dimensions and site conditions before commencing work. In addition, verify disposition of all site vegetation before any removal. If a soils report has been prepared for this project, the soils engineer must be notified 2 days prior to the commencement of any site or foundation work. The soils engineer shall be present during such work and upon completion of the foundation shall submit a letter stating his acceptance to the Owner, General Contractor, Designer and City.

C. Excavation: Excavate foundations to size and depth shown. Footings shall be entirely into solid undisturbed soil or entirely into compacted fill. No uncompacted fill is permitted under footings. Bottoms of all footing excavations to be level. Excavations to be kept free of standing water.

D. Backfilling, Fill and Compaction: All structural fill underlying building areas, and within two horizontal feet of pavement and sidewalk sub-grade, shall be compacted to at least 90% of its maximum dry density.

E. Trenching: All trenching for underground piping, electrical conduits, etc. shall be done by trade installing pipes, conduits, etc. in a manner to prevent settlement. Backfilling of trenches shall conform to the requirements for compacted fill.

F. Finish Grading: Slope all grades a minimum of 2% away from structure and foundation unless otherwise noted. At the conclusion of the work all earth shall be raked free of debris and left with a uniformly fine graded surface. All finish grades shall be held 6" below top of building slab and 2" below flat-work unless otherwise noted on plans. The General Contractor shall oversee and approve all site grading and site drainage.

## DIVISION 3 – SECTION 1 – STRUCTURAL CONCRETE

See Sheet S-1 for additional requirements.

### I. GENERAL REQUIREMENTS

A. Scope: This section includes all labor, material and equipment necessary to complete all work specified herein and as indicated within the construction documents. The work of this section includes, but is not limited to; structural concrete, under-slab vapor barrier.

### II. MATERIALS

A. Under-slab Vapor Barrier: FORTIFIBER Moistop Ultra 10 (10-mil polyolefin film) and Moistop Joint Tape, or approved equal.

B. Rebar Chairs: Plastic

### III. PERFORMANCE OF WORK

A. General Requirements: Contractor to provide all labor, materials and equipment to form, place and finish concrete as required for a complete finished job.

B. Install under-slab vapor barrier over capillary break as detailed within construction documents. Lap and tape all seams and penetrations per manufacturer's recommendations. Seal edges and items projecting through vapor retarders and vapor barriers. Inspect and repair membrane; tape tears, perforations and similar damage. Provide 2" thick sand cushion over vapor barrier prior to placing slab reinforcing.

C. Interior slabs shall be level with no variations of greater than 1/8" in 10 feet unless sloping surface is specifically noted on plans.

## DIVISION 4 – SECTION 1 – STRUCTURAL MASONRY

See sheet S-1

## DIVISION 4 – SECTION 2 – EXTERIOR STONE CLADDING

### I. GENERAL REQUIREMENTS

A. Scope: This section contains all labor, material and equipment necessary to complete all work specified herein and as indicated on within the construction documents. The work of this section includes, but is not limited to; tile non-structural veneer.

### II. MATERIALS

A. Natural Stone Tile: To be determined by Owner. Sample to be submitted for approval by Designer.

B. Type N mortar.

C. Grout: Color to be determined by Owner.

### III. PERFORMANCE OF WORK

A. Tile veneer shall be installed as indicated within the construction documents in accordance with Chapter 14 of the International Building Code (IBC).

B. Protect adjacent finishes and clean surface of tile of all loose grout after installation.

C. Cut pieces to length as required. Layout joint locations to avoid small cut pieces and to provide the most visually balanced joint pattern.

## DIVISION 5 – SECTIONS 1 – STRUCTURAL METALS

See Sheet S-1

## DIVISION 5 – SECTION 3 – DECORATIVE METAL

### I. GENERAL REQUIREMENTS

A. Scope: This section includes all labor, material and equipment necessary to complete all work specified herein and as indicated within the construction documents. The work of this section includes, but is not limited to; the furnishing and installation of all non-structural metal fabrication with the exception of exterior metal stairs and grating.

### II. MATERIALS

A. Steel Members: Size and type per plan. All members shall conform to ASTM A-36 except as noted or shown within the construction documents.

B. Bolts: All bolts shall conform to ASTM A-305 except as noted or shown on plans.

### III. PERFORMANCE OF WORK

A. Steel parts shall be accurately fabricated as shown on plans. Field-verify measurements prior to fabrication. Cut, drill and tap to receive hardware as required. Grind all welds smooth.

B. Provide necessary anchorage devices and fasteners for securing items in place.

C. Exterior metal items shall be powder coated unless otherwise indicated within the construction documents.

D. Interior metal items shall receive 1 shop coat of inorganic zinc primer after fabrication.

## DIVISION 6 – SECTION 1 – STRUCTURAL CARPENTRY

### I. GENERAL REQUIREMENTS

A. Scope: See Sheet S-1 for general information.

### II. MATERIALS

A. In addition to requirements noted on S-1, all structural framing designed to be exposed is to be of lumber #1 or better, clear, or #1 Free of Heart Center (FOHC).

## DIVISION 6 – SECTION 2 – EXTERIOR FINISH CARPENTRY

### III. GENERAL REQUIREMENTS

A. Scope: This section contains all labor, material and equipment necessary to complete all work specified herein and as indicated on the plans. The work of this section includes, but is not limited to, furnishing and installation of all non-structural exterior finished wood members and wall siding.

### IV. MATERIALS

A. Trim, Soffits and Porch Ceilings: BORAL TruExterior trim, except as noted or shown on plans.

B. Decking: Natural stone tile to be determined by Owner. Sample to be submitted for approval by Designer.

### V. PERFORMANCE OF WORK

A. Finish Carpentry: Members shall be installed level and plumb, neatly and accurately scribed in place. All members shall be installed in full lengths. Joints shall be scarfed, corners mitered or coped.

B. Nails and Fasteners: Arranged in a straight line, uniform pattern, evenly spaced. All exposed fasteners set and filled. Hammer marks are not acceptable. Members damaged shall be replaced. Exterior finish wood fasteners: stainless steel nails unless shown otherwise.

## DIVISION 6 – SECTION 3 – INTERIOR FINISH CARPENTRY AND MILLWORK

### I. GENERAL REQUIREMENTS

A. Scope: This section includes all labor, material and equipment necessary to complete all work specified herein and as indicated within the construction documents. The work of this section includes, but is not limited to; the furnishing and installation of all non-structural finished wood members, shaped wood members and miscellaneous specialties.

B. Special Requirements: All millwork shall conform to the latest edition of the Woodwork Institute of California, (W.I.C.) Manual of Millwork, - Custom grade.

### II. MATERIALS

A. Interior Trim: Pine, except as noted or shown within the construction documents.

B. Door Jamb: All door frames shall be 3/4" thick clear pine, width shall match wall thickness.

C. Handrail: As detailed within the construction documents.

D. Decorative Beams: Pine unless otherwise noted, as detailed within the construction documents.

E. Closet Accessories: All closets shall be equipped with closet hanging poles and support fittings shall be chrome finished metal. Hanging poles shall be provided with center supports for spans longer than 4'-0" in length.

### III. PERFORMANCE OF WORK

A. Finish Carpentry: Members shall be neatly and accurately scribed in place. All members shall be installed in full lengths. Joints shall be scarfed, corners mitered or coped. Fasten securely in place accurately, scribe neatly into walls, ceilings or other surfaces so open joints do not occur. All joints shall be filled and sanded after installation.

B. Nails and Fasteners: Arranged in a straight line, uniform pattern, evenly spaced. All exposed fasteners set and filled. Hammer marks are not acceptable. Members damaged shall be replaced.

## DIVISION 6 – SECTION 4 – CABINETS

### I. GENERAL REQUIREMENTS

A. Scope: This section includes all labor, material and equipment necessary to complete all work specified herein and as indicated within the construction documents. The work of this section includes, but is not limited to; the fabrication and installation of cabinetry.

### II. MATERIALS

A. Stain grade cabinetry shall be birch veneer plywood with solid alder face frames, stiles, rails and drawer fronts, unless otherwise noted.

B. Paint grade cabinetry shall be medium density fiberboard with solid poplar face frames, stiles, rails and drawer fronts, unless otherwise noted.

C. Closet built-ins shall be medium density fiberboard; painted, unless otherwise noted.

D. Cabinet interiors shall be melamine faced, except that the interior of open cabinets and cabinets with glass doors shall match the cabinet finish.

E. Door and drawer front style shall be as detailed within the construction documents, see interior elevations and schedules.

F. Door and drawer type and style shall be per the construction documents, see interior elevations and schedules.

G. All drawers shall have BLUM side mounted full extension drawer glides, or approved equal. Door hinges shall be concealed 110-degree opening European type, unless otherwise noted.

H. Pulls shall be as selected by Owner (provide allowance).

### III. PERFORMANCE OF WORK

A. Cabinets shall be fabricated to conform to the Woodwork Institute of California, (W.I.C.) Manual of Millwork, Style B, Type II, Premium Grade and as detailed within the construction documents.

B. All cabinets shall be installed level, plumb and true, securely fastened to the walls and each other. Cabinets abutting walls shall be scribed to fit. Finished casework items and surfaces shall have no visible gaps or seams.


C. Cabinet installer shall adjust hinges, glides and convenience hardware as need to allow even reveals and smooth operation. Install cabinet pulls as directed by Designer/Owner.

## DIVISION 7 – SECTION 1 – CORRUGATED METAL ROOF

### I. GENERAL REQUIREMENTS

A. Scope: This section includes all labor, material and equipment necessary to complete all work specified herein and as indicated within the construction documents. This section covers the pre-finished, pre-fabricated Architectural standing seam roof system All metal trim, accessories, fasteners, insulation and sealants indicated on the drawings as part of this section

B. Special Requirements: All work under this section shall be performed by a State of California licensed roofing contractor.

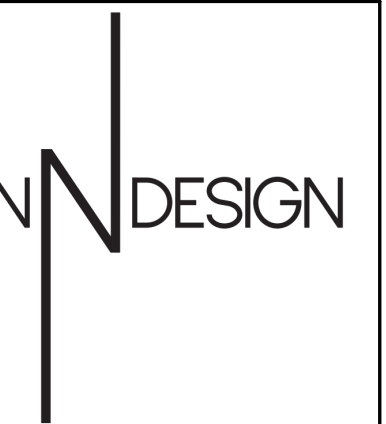

## NICODEMUS DESIGN

8861 Villa La Jolla Dr.,  
P.O. Box # 13367,  
La Jolla, CA 92037  
Phone: (760) 473-1041

DESIGNER:

Drawn By:

NN

Drawing Date:

October 10, 2023

Revisions:

revision	date	notes

Evans Remodel  
412 Flora Vista, Santa Barbara, CA

PROJECT:

Specifications

SHEET TITLE:

GN1

DRAWING NUMBER:





**NICODEMUS DESIGN**

8861 Villa La Jolla Dr.,  
P.O. Box # 13367,  
La Jolla, CA 92037  
Phone: (760) 473-1041

DESIGNER:



Drawn By:  
NN

Drawing Date:  
October 10, 2023

Revisions:

revision	date	notes

Evans Remodel  
412 Flora Vista, Santa Barbara, CA

PROJECT:

Specifications

SHEET TITLE:

DRAWING NUMBER:  
**GN2**

**II. MATERIALS**

- A. Corrugated Metal Roof: Custom-Bit Metals ESR # 2048, "Class A" U.L. fire rating, ICC# ESR-2048, or approved equal, color to be selected by Owner. Contour Corrugated 7/8" Through-Fastened Panels, fabricated of 24 GA metal. Panels to be spaced and fastened as required by the manufacturer to provide for both positive and negative design loads, while allowing for the expansion and contraction of the entire roof system resulting from variations in temperature.
- B. Trim: Trim shall be fabricated of the same material and finish to match the profile, and will be press broken in lengths of 10 to 12 feet. Trim shall be formed only by the manufacturer of their approved dealer. Trim to be erected in overlapped condition. Miter conditions shall be factory welded material to match the sheeling.
- C. Closures: use composition or metal profiled closures at the top of each elevation to close ends of the panels. Metal closures to be made in the same material and finish as face sheet.
- D. Fasteners: Fasteners shall be of type, material, size, corrosion resistance, holding power and other properties required to fasten miscellaneous framing members to substrates.
- E. Substrate shall be 1/2" DensDeck Roof Board as manufactured by GEORGIA PACIFIC or approved equal, over plywood sheathing.
- F. Roofing Underlayment: CLAD-GARD SA-FR Underlayment as manufactured by Firestone or approved equal, over plywood sheathing.
- G. Sealants: Exterior grade silicone sealant recommended by roofing manufacturer.

**III. PERFORMANCE OF WORK**

- A. Panels shall be installed plumb and true in a proper alignment and in relation to the structural framing. The erector must have at least five years successful experience with similar applications.
- B. Install metal panels, fasteners, trim and related sealants in accordance with manufacturer's written specification and the construction documents and as may be required for a weather-tight installation.
- C. Remove all strippable coating and provide a dry-wipe down cleaning of the panels as they are erected.

**DIVISION 7 – SECTION 2 – INSULATION**

**I. GENERAL REQUIREMENTS**

- A. Scope: This section includes all labor, material and equipment necessary to complete all work specified herein and as indicated within the construction documents. The work of this section includes, but is not limited to; insulation at all interior and exterior walls, ceilings, floors over unconditioned and conditioned space and other locations indicated within the construction documents.

**II. MATERIALS**

- A. Batt Insulation: OWENS/CORNING or equal, fiberglass batts sized to fit cavity. R-value per construction documents.
- B. Blown-In Insulation: OWENS/CORNING "PROPIK L77" loose fill insulation or approved equal. Provide R-value per construction documents and Title 24 requirements.
- C. Closed Cell Blown-In Insulation: Touch 'N' Foam closed cell spray foam insulation or approved equal. Provide R-value per construction documents and Title 24 requirements

**III. PERFORMANCE OF WORK**

- A. Install with facing toward interior. Insulation shall fit snugly into all voids and cavities.
- B. Provide baffle between attic vents to maintain 1" clear airspace.

**DIVISION 7 – SECTION 3 – BUILDING WRAP AND NONMETAL FLASHING**

**I. GENERAL REQUIREMENTS**

- A. Scope: This section includes all labor, material and equipment necessary to complete all work specified herein and as indicated within the construction documents. The work of this section includes, but is not limited to; building weather protection wrap, parapet and other horizontal surface waterproofing, door and window flashing, at grade flashing, etc.

**II. MATERIALS**

- A. Building Weather Protection Wrap: DUPONT "Tyvek HomeWrap", or approved equal.
- B. Parapet and other Horizontal Surface Waterproofing: Nonmetallic flashing shall be PROTECTOWRAP "Jiffy-Seal 140/60" membrane, or approved equal. For sealant in contact with "Jiffy-Seal", use products manufactured by PROTECTOWRAP, 160 H mastic or JSLM urethane.
- C. Door and Window Flashing: Opening flashing shall be "Moistop" by FORTIFIBER, or approved equal.
- D. At Grade Flashing: Copper-faced nonmetallic flashing shall be PROTECTOWRAP "Fast-Flash H.D." flashing tape, or approved equal.

**III. PERFORMANCE OF WORK**

- A. Vertical Surfaces: Comply with CBC Section 1402. Apply building paper horizontally with upper course lapped over lower course not less than 2" and end laps of not less than 6". Provide two layers of building papers over solidly sheathed portions of the structure.
- B. Parapet and other Horizontal Surface Waterproofing: Installed in accordance with manufacturer's instructions over building paper. Extend a continuous membrane a minimum of 4" below edge of parapet, each side. Provide a minimum end lap of 4" over adjoining membrane sheet. Where membrane encounters vertical surfaces, the membrane shall extend up surface 4" and be lapped under building wrap. No nailing shall be done on horizontal surface of "Jiffy-Seal".
- C. Door and Window Flashing: Install per details on plans. Install sill flashing prior to setting windows. Install jamb, then head flashing with minimum 2" lap over flashing below.

**DIVISION 7 – SECTION 4 – SHEET METAL**

**I. GENERAL REQUIREMENTS**

- A. Scope: This section includes all labor, material and equipment necessary to complete all work specified herein and as indicated within the construction documents. The work of this section includes, but is not limited to; flashing, counter flashing, gutters, downspouts, scuppers, roof penetrations and miscellaneous exterior metal.
- B. Special Requirements: All work performed under this section shall be performed by a State of California licensed sheet metal contractor.
- C. Workmanship: All work shall conform to the Sheet Metal and Air Conditioning Contractors National Association (S.M.A.C.N.A.) Architectural Sheet Metal Manual, latest edition.

**II. MATERIALS**

- A. Gutters and Downspouts: 16 oz. copper sheet metal, continuous roll-formed to required length, style and size per plans.
- B. Flashing and all other Sheet Metal: 16 oz. copper sheet metal, unless detailed otherwise.

**III. PERFORMANCE OF WORK**

- A. Install sheet metal in maximum practical lengths.
- B. Lap joints 4" in full bed of sealant unless otherwise noted on plans.
- C. Fasten to substrate with corrosion resistant fasteners. Do not nail through horizontal surface of flashing.

**DIVISION 7 – SECTION 5 – BELOW GRADE WATERPROOFING**

**I. GENERAL REQUIREMENTS**

- A. Scope: This section includes all labor, material and equipment necessary to complete all work specified herein and as indicated within the construction documents. The work of this section includes, but is not limited to; below grade waterproofing, sub-grade drainage.

**II. MATERIALS**

- A. Waterproofing System:
  1. Liquid Applied Waterproofing: CARLISLE CCW 525 liquid applied waterproof membrane, or approved equal
  2. Drainage Board: CARLISLE CCW Miradrain 6000 geocomposite drainage board, or approved equal.
  3. Below Slab Vapor Barrier: STEGO Wrap Vapor Barrier 15-MIL multi-layer plastic extrusion, or approved equal
  4. Under Slab Waterproofing: CARLISLE CCW Miraclay Bentonite clay waterproofing, or approved equal (Mat. #305119)
- B. Sub-grade Drainage:
  1. 4" Perforated rigid plastic drain line: SCR35 or approved equal.
  2. Filter fabric: MIRAF 140N or approved equal.

**III. PERFORMANCE OF WORK**

- A. Install 2 layers 60 mil. liquid applied waterproofing each at earth side of below-grade basement walls. Liquid applied waterproofing shall be installed per manufacturer's recommendations and specifications.
- B. Install J-Drain SWD per manufacturer's instructions on basement walls. Connect drain to solid pipe beyond building line and daylight solid pipe as indicated on plans. DO NOT connect any surface drainage to sub-grade drain system.
- C. Install Bentonite clay waterproofing over liquid applied waterproofing. Install per manufacturer's specifications. Surrounding affected earth to be recompactd to at least 90%.

**DIVISION 7 – SECTION 6 – CAULKING AND SEALANTS**

**I. GENERAL REQUIREMENTS**

- A. Scope: This section includes all labor, material and equipment necessary to complete all work specified herein and as indicated within the construction documents. The work of this section includes, but is not limited to; caulking and sealants.
- B. Special Requirements: All materials shall be in accordance with 2016 California Green Building Standards Code (CGC) Section 4.504.2.1.

**II. MATERIALS**

- A. Caulking and Sealant: Manufactured by DOW CORNING, or approved equal. Sealant type for specific application, substrate preparation and installation shall be verified by Contractor with the manufacturer's representative. The representative shall be consultant to verify sealant application and if surface primers will be required for proper installation. Sealant for each particular application shall be reviewed by the Contractor for compatibility with surrounding materials prior to application. Color of exposed sealant shall match surrounding materials, unless otherwise noted.
- B. Warranty: Sealants shall have a 20 year warranty.

**III. PERFORMANCE OF WORK**

- A. Installation: Sealant shall be non-drying gun applied to make a watertight seal at all joints, sills, windows, doors, trim elements, etc. Backer rods or bond breaker agents shall be used depending on the specific application. Surfaces to be sealed shall be properly cleaned prior to application. Sealant shall be applied per the manufacturer's specifications.

**DIVISION 7 – SECTION 7 – WATERPROOF DECK MEMBRANE**

**I. GENERAL REQUIREMENTS**

- A. Scope: This section includes all labor, material and equipment necessary to complete all work specified herein and as indicated within the construction documents. The work of this section includes, but is not limited to; waterproof deck membranes.
- B. Special Requirements: All work performed under this section shall be by an installer certified by the product manufacturer.

**II. MATERIALS**

- A. Traffic Bearing Surfaces: CROSSFIELD PRODUCTS "Dex-O-Tex Weatherwear" (ICC# ESR-1757). Finish coat color to be selected by Owner/Designer, or approved equal.
- B. Crickets & Counter-slopes: CROSSFIELD PRODUCTS "A-81" underlayment, or approved equal.
- C. Under Concrete Patches: PROTECTOWRAP "Jiffy-Seal 140/60" membrane, "Jiffy-Seal 500" detail tape and "Jiffy-Seal 80" primer (ICC# ESR-1127), or approved equal.

**III. PERFORMANCE OF WORK**

- A. General: Apply each component of waterproof neoprene composition traffic bearing roof deck surfacing system according to manufacturer's directions to produce monolithic surface of thickness indicated.
- B. Prepare and prime the sheet metal or alternate flashing. Inspect all transitions and terminations for proper waterproof seal that the installation of the flashing is in accordance with the recommended application methods.
- C. Apply slip-sheet over properly prepared substrate. Overlap seams a minimum of 2 inches. Apply latex bonding coat when required.
- D. Apply reinforced membrane at all vertical junctures. Embed polypropylene fabric into neoprene membrane liquid.
- E. Apply aqueous neoprene rubber waterproof membrane solution with glass fabric reinforcement to entire area to be coated. Overlap all seams a minimum of 2 inches.
- F. Trowel apply two coats of neoprene and aggregate composition traffic surfacing over all surfaces previously covered with waterproof membrane. Sand surface to remove trowel marks or small surface imperfections.
- G. Trowel apply two smoothing coats of neoprene and fine aggregate composition to achieve smooth, filled surface. Sand to remove trowel marks or small surface imperfections.
- H. Roller apply two coats of final finish dressing to a uniform finish.
- I. Finished neoprene composition traffic-bearing roof deck surfacing shall be a nominal 3/16 inch thick, smooth and uniform in color and texture.

**DIVISION 8 – SECTION 1 – DOORS**

**I. GENERAL REQUIREMENTS**

- A. Scope: This section includes all labor, material and equipment necessary to complete all work specified herein and as indicated within the construction documents. This section includes furnishing and installing interior and exterior doors, except for doors covered in DIVISION 8 – SECTION 4 – ALUMINUM SLIDING POCKET DOORS, and DIVISION 8 – SECTION 3 – CLAD WOOD WINDOWS AND DOORS.

**II. MATERIALS**

- A. Exterior Doors: Door size, style and finish shall be per the construction documents, see door schedule/legend. All doors shall be fabricated with Type I adhesives. Door thickness per door schedule.
- B. Interior Doors: Doors to be MDF panel doors, single recess with square sticking, 1-3/4" thick, as manufactured by TRUSTILE, or approved equal. All doors shall be fabricated with Type I adhesives. All doors from interior of house to garage shall have a fire rating of 20 minutes for door and frame, equipped with a self closure.

- C. Garage Door: Shall be per the construction documents, see door schedule/legend. Provide electrical automatic door opener system with two (2) remote controls.
- D. Refer to door schedule/legend and Title 24 energy notes within the construction documents for additional requirements.

**III. PERFORMANCE OF WORK**

- A. Installation: Install doors plumb and square with uniform 1/8" gap between door and frame. Undercut doors as required for floor finish.

**DIVISION 8 – SECTION 2 – DOOR HARDWARE**

**I. GENERAL REQUIREMENTS**

- A. Scope: This section includes all labor, material and equipment necessary to complete all work specified herein and as indicated within the construction documents. The work of this section includes, but is not limited to; the furnishing of all finish hardware including door handles, door stops, door hinges etc.

**II. MATERIALS**

- A. Door Hardware: Manufacturer, type, style and finish shall be per door schedule/legend within the construction documents.

**DIVISION 8 – SECTION 3 – CLAD WOOD WINDOWS AND DOORS**

**I. GENERAL REQUIREMENTS**

- A. Scope: This section includes all labor, material and equipment necessary to complete all work specified herein and as indicated on the plans. The work of this section includes, but is not limited to, the furnishing and installation of all clad wood windows and doors as indicated on plans.

**II. MATERIALS**

- A. Clad Windows and Doors: LINCOLN WINDOWS aluminum clad wood windows with nailing fins and doors, or approved equal. Size and type per plan and/or schedule.
- B. Finish: Bronze Color Exterior, Pine Interior.
- C. Glazing: Shall be Low-E II insulating glass with 7/8" SDL and bronze internal spacer, interior bars – square, glass tempered and/or laminated where noted on schedule, unless otherwise noted on plans. Refer to construction drawings for life layout.
- D. Hardware: Provide Contempo Handle on all casement and awning windows, Bronze Color.
- E. Screens: All operable windows shall have Standard BetterVue screens in metal frames, color to match exterior window color.
- F. Locks: All clad wood doors with glazing shall have keyed locks. Locks shall be keyed to match other exterior door locks.

**III. PERFORMANCE OF WORK**

- A. Installation: install clad windows and doors plumb and square.
- B. Glazing:
  1. Tempered glass shall be permanently identified and visible when unit is glazed.
  2. All windows shall have labels attached by N.F.R.C. showing compliance with energy standards.

**DIVISION 8 – SECTION 4 – ALUMINUM SLIDING DOORS**

**I. GENERAL REQUIREMENTS**

- A. Scope: This section includes all labor, material and equipment necessary to complete all work specified herein and as indicated within the construction documents. The work of this section includes, but is not limited to; the furnishing and installation of all aluminum sliding pocket doors.

**II. MATERIALS**

- A. Aluminum Sliding Doors: Series 1000 Traditional Sliding Door, as manufactured by FLEETWOOD WINDOWS & DOORS, or approved equal. Size and type per construction documents, see schedule.
- B. Finish: Black Anodize.
- C. Glazing: Shall be Low-E II insulating glass, glass tempered.
- D. Hardware: Rollers and other operating hardware shall be stainless steel.
- E. Screen doors: Per construction drawings.

**III. PERFORMANCE OF WORK**

- A. Installation: Install doors plumb, square and true in accordance with manufacturer's published installation instructions. Adjust for proper operation.

**DIVISION 9 – SECTION 1 – LATH AND EXTERIOR PLASTER**

**I. GENERAL REQUIREMENTS**

- A. Scope: This section includes all labor, material and equipment necessary to complete all work specified herein and as indicated within the construction documents. This section of work includes, but is not limited to; building wrap, lath and lath attachments, corner reinforcement, expansion screeds and exterior Portland cement plaster (stucco).
- B. Special Requirements: All work performed under this section shall be performed by a State of California licensed plastering contractor.
- C. All lath and plaster shall be prepared and installed per the International Building Code (IBC) and the California Lathing and Plastering Contractors Association Standards unless otherwise noted.
- D. See also DIVISION 7 – SECTION 2 – INSULATION and DIVISION 9 – SECTION 2 – GYPSUM WALLBOARD for related work.

**II. MATERIALS**

- A. Lathing:
  1. Vertical exterior lathing for exterior Portland cement plaster (stucco) shall be 17 ga. woven steel wire fabric (stucco netting) galvanized with 1-1/2" openings or as noted in the manufacturer's installation instructions for Omega Stucco.
  2. Horizontal exterior lathing for exterior Portland cement plaster (stucco) shall be 3/8" high rib – 3.4 lbs / sq. yard, galvanized steel expanded metal or expanded metal (diamond mesh) lath design specifically for horizontal applications or as noted in the manufacturer's installation instructions for Omega Stucco.

**B. Accessories:**

- 1. Weep screed, corner bead, casing and miscellaneous stucco accessories as required by details or as needed to perform a complete and thorough job, shall be exterior grade vinyl by AMCO or equal.

**C. Plaster:**

- 1. Portland cement plaster shall be by LAHABRA. Conform to Standard Specification for Portland Cement ASTM Designation: C 150, Type I or Type II. When plastic or waterproof cement is used no lime or other plasticizer may be added to the mix.



DESIGNER:

Drawn By:  
 NN

Drawing Date:  
 October 10, 2023

Revisions:

revision	date	notes
1	12/13/23	Plan Check

PROJECT:

**Evans Remodel**  
 412 Flora Vista, Santa Barbara, CA

SHEET TITLE:

**Specifications**

**GN3**  
 DRAWING NUMBER:

- Sand shall be clean and well graded from coarse to fine.
- The approved application shall be per manufacturer's recommended installation instructions.
- Finish coat shall be integral color by LAHABRA, color as selected by Designer.

**III. PERFORMANCE OF WORK**

- Install stucco true to lines and level. Stucco shall be installed to provide uniform surface flatness with a maximum surface variation of 1/8" in 10 feet in any direction. Square outside corners.
- Extreme care shall be taken to fully mask all exposed aluminum, glass, wood and other exposed surfaces prior to plastering. Surfaces shall be protected until all plastered surfaces are hardened and fully cured. All stucco walls to have a stucco screed located not less than 8" above finish grade or 2" above concrete or deck surface unless otherwise noted.
- Stucco finish coat texture shall be "fine" per manufacturer's specifications.

**DIVISION 9 – SECTION 2 – GYPSUM WALLBOARD**

**I. GENERAL REQUIREMENTS**

- Scope: This section includes all labor, material and equipment necessary to complete all work specified herein and as indicated within the construction documents. This section of work includes all gypsum wallboard materials and installation as shown on the plans. All gypsum wallboard shall be installed per the International Building Code and per the manufacturer's instructions for installation.
  - Special Requirements: All work performed under this section shall be performed by a State of California licensed drywall contractor.
- II. MATERIALS**
- Wallboard: **U.S. GYPSUM** or equal, 5/8" thick, Type 'X' where noted within the construction documents. Gypsum wallboard shall have tapered or beveled edges.
  - Fasteners: Screws shall be 1-1/4" long minimum, Type 'W' drywall screw.
  - Joint Reinforcing Tape: Joint tape of same manufacturer as wallboard or fiberglass reinforced tape.
  - Corner Bead, Casing Bead & other Drywall Trim: Shall be 90-degree corner paper faced metal drywall corners (B1XWNB) and other similar trim by **BEADEX** or approved equal.
  - Reglets: as specified under **DIVISION 6 – SECTION 3 – INTERIOR FINISH CARPENTRY AND MILLWORK**
  - Tile Backer Board: as specified under **DIVISION 9 – SECTION 3 – CERAMIC TILE**

**III. PERFORMANCE OF WORK**

- Application: Apply wallboard first to ceiling, then to walls with long dimension at right angles to framing members. Maximum spacing of fasteners shall be 12" o.c. Gypsum board shall be installed and finished per manufacturer's specifications.
- Finishing:
  - Joints: Finish all exposed joints with reinforcing tape and joint cement in accordance with written instructions of wallboard manufacturer per specific finish coating system.
  - Corner Beads and Trim: Install at all exterior angles and where wallboard abuts other materials and no trim is shown
  - Finish Texture: Hand trowel smooth finish. Provide 3' x 3' finish texture sample for Owner and Designer approval prior to texture application.

**DIVISION 9 – SECTION 3 – CERAMIC TILE**

**I. GENERAL REQUIREMENTS**

- Scope: This section includes all labor, material and equipment necessary to complete all work specified herein and as indicated within the construction documents. The work of this section includes, but is not limited to, the following areas: floors, walls, shower walls and floors, countertops, decks and balconies, patios and walkways.
  - Special Requirements: All work performed under this section shall be performed by a State of California licensed contractor.
  - Quality Assurance: All workmanship and material shall be in conformance with applicable portions of **ANSI Specifications and Standards and Handbook for Ceramic Tile Installation** by the Tile Council of America, current edition.
- II. MATERIALS**
- Tile: As selected by Owner. Refer to the construction documents, see plans, finish schedule and interior elevations for areas receiving tile.
  - Tile Backer Board: **GEORGIA PACIFIC BUILDING PRODUCTS DensShield** Tile Backer.
  - Membranes:
    - Cleavage Membrane: 15# roofing felt or approved equal.
    - Moisture Barrier: 15# roofing felt.
    - Waterproof Membrane: hot mopped felt, or approved equal.
  - Mortar Bed: **CUSTOM BUILDING PRODUCTS Custom-Float Bedding Mortar** mixed with water and **Acrylic Mortar Admix**. Metal lath – 2.5 lbs/yd self furred expanded metal.
  - Tile Adhesives: **CUSTOM BUILDING PRODUCTS Master-Blend** mixed with **Custom-Flex** latex.
  - Grout: **CUSTOM BUILDING PRODUCTS Polyblend Sanded Colored Tile Grout** – for joints 1/8" - 1/2". All grout colors shall be selected by the Owner.
  - Elastomeric Joint Caulk: All joints between floors and walls and at all joints between tile and dissimilar materials. **CUSTOM BUILDING PRODUCTS Polyblend Ceramic Tile Caulk**. Texture and color shall match adjacent grout.
  - Tile Sealer: as recommended by **CUSTOM BUILDING PRODUCTS** and approved by Owner. Apply sealer per manufacturer's specifications.

**III. INSTALLATION**

- Examine surfaces which are to receive tile or stone. Verify that surfaces to receive tile are stable, flat, firm, dry, clean and free of oil, waxes and curing compounds. Do not proceed with work until defects or conditions which would adversely affect quality, execution and permanence of finish work are corrected. All concrete substrates shall be at least 28 days old, completely cured and free of hydrostatic conditions and/or moisture problems. Protect adjacent surfaces prior to beginning tile work.
- Installation Methods:
  - Over Wood Subfloor: Thin-set over glass mesh mortar units. Attach glass mesh mortar units to subfloor per manufacturer's recommendations.
  - Shower Floors, Tile-seat, Tub Platform Tops: Mortar bed over waterproof membrane over sloped mortar fill. Mortar bed shall be 3/4" thick minimum and 1-1/4" maximum. Verify mortar thickness with actual field conditions. Water test membranes at showers and other wet areas before installing mortar bed.
  - Shower & Tub Walls and Back-splashes: Mortar bed over 15# felt moisture barrier.

- Walls (Dry Locations): Thin-set over glass mesh mortar units.
- Countertop: Mortar bed over 15# felt moisture barrier.

- Lay tile in grid pattern unless otherwise indicated on plans or directed by Designer. Terminate tile neatly at obstructions, edges and corners without disruption of pattern or joint alignment. Where tile cuts are necessary cuts shall be neat and scribed. Provide expansion joints, control joints, etc. as shown on plans and elsewhere as required.
- Install grout in accordance with manufacturer's directions.
- Clean and seal tile and grout in accordance with product manufacturer's recommendations.

**DIVISION 9 – SECTION 4 – STONE**

**I. GENERAL REQUIREMENTS**

- Scope: This section includes all labor, material and equipment necessary to complete all work specified herein and as indicated on the plans.
  - Quality Assurance: All workmanship and material shall be in conformance with applicable portions of **ANSI Specifications and Standards and Handbook for Stone Installation** by the Marble Institute of America, current edition.
- II. MATERIALS**
- Granite: Polished granite slab, 3/4" thick and 1-1/2" edge for countertops, edge profile to be determined by owner, 3/4" thick for backsplash. Provide cut-outs for sinks and faucets (refer to construction documents, see plumbing fixture schedule). Polish edges of sink cut-outs. Refer to construction documents for areas receiving stone. Slabs to be selected by Owner.
  - Stone Sealer: As recommended by **CUSTOM BUILDING PRODUCTS** and approved by Owner. Apply sealer per manufacturer's specifications.
- III. INSTALLATION**
- Examine surfaces which are to receive stone. Verify that surfaces to receive stone are stable, flat, firm, dry, clean and free of oil, waxes and curing compounds. Do not proceed with work until defects or conditions which would adversely affect quality, execution and permanence of finished work are corrected.
  - Protect adjacent surfaces prior to beginning stone work.
  - Install grout in accordance with manufacturer's directions.
  - Clean, seal and grout in accordance with product manufacturer's recommendations.

**DIVISION 9 – SECTION 5 – HARDWOOD FLOORING**

**I. GENERAL REQUIREMENTS**

- Scope: This section includes all labor, material and equipment necessary to complete all work specified herein and as indicated within the construction documents. The work of this section includes, but is not limited to, hardwood flooring and finishing.
  - Special Requirements: All work performed under this section shall be performed by a State of California licensed flooring contractor.
- II. MATERIALS**
- Hardwood Flooring over Wood Sub-floor: Pre-finished Engineered T&G hardwood flooring as selected by Owner.
  - Provide matching hardwood floor registers at HVAC vents in areas to receive hardwood flooring.
  - Provide matching 1" thick stair treads and/or risers as noted within the construction documents.
  - Verify base shoe material and profile with Designer or Owner prior to install.

**III. PERFORMANCE OF WORK**

- Hardwood flooring over wood sub-floors shall be blind nailed to sub-floor.

**DIVISION 9 – SECTION 6 – PAINTING**

**I. GENERAL REQUIREMENTS**

- Scope: This section includes all labor, material and equipment necessary to complete all work specified herein and as indicated within the construction documents. This section includes, but is not limited to, the painting or staining of all surfaces as shown and/or specified. Refer to the construction documents, see finish schedule and notes for location and finish of surface to be painted.
- Special Requirements: All work performed under this section shall be performed by a State of California licensed painting contractor.
- Special Requirements: All paint materials shall be in accordance with **2016 California Green Building Standards Code (CGC) Section 4.504.2.2**.

**II. MATERIALS**

- All paint materials shall be by **DUNN EDWARDS** or approved equal. Colors as selected by Designer and samples approved by Owner.

**III. PERFORMANCE OF WORK**

- Application:
  - Where interior painting is specified for walls of a room, paint all incidental exposed surfaces in the room such as base trim, grilles and other miscellaneous items. Allow for three color scheme at interior (i.e. walls, ceiling and trim each a different color from the others). Hardware such as hinges, levers or vinyl weather-stripping shall not be painted unless specified. Items that are not to be painted shall be masked to prevent over spray or splatter.
  - Paint shall be applied at the manufacturer's recommended rate of coverage. Each coat shall be even, smooth and uniform; free of laps, skips, runs and color variations. Sand lightly between all coats. Edges of doors and windows scheduled to receive paint shall have complete coverage.
  - Woodwork Preparation: Sand rough spots; seal knots, pitch pockets and sappy spots; spackle nail holes, cracks and joints after primer coat; caulk baseboard and trim (as occur) to adjacent surfaces.
- Paint Schedule:
  - Exterior wood doors, exterior trim: One coat primer, two coats semi-gloss acrylic enamel. Coating shall include all surfaces including top and bottom edges.
  - Clad French Doors and Windows: Interior to receive one coat enamel undercoat and two coats semi-gloss acrylic enamel. Coating shall include all surfaces including top and bottom edges.
  - Gypsum Board: One coat sealer and two coat flat acrylic-vinyl, except at kitchens and baths. Apply one coat sealer and two coats satin 100% acrylic enamel.
  - Stained Interior Woodwork and Cabinetry: One coat wiping stain (submit color samples for Owner's selection), one coat sanding sealer, two coats satin lacquer.
  - Paint-grade Interior Doors, Woodwork, and Paint-grade Cabinetry: one coat enamel undercoat and two coats semi-gloss acrylic enamel. Coating shall include all surfaces including top and bottom edges.

**DIVISION 10 – SECTION 1 – PREFABRICATED FIREPLACES**

**I. GENERAL REQUIREMENTS**

- Scope: This section includes all labor, material and equipment necessary to complete all work specified herein and indicated within the construction documents. This section of work includes, but is not limited to; prefabricated fireplaces and flue, etc.
- II. MATERIALS**
- Prefabricated Fireplace and Flue (Type A): **HEAT&GLO** Phoenix TrueView size 42 gas burning appliance with closable glass doors per 2019 California Energy Code 150.0(e). Include traditional interior & high definition logs. Listed to ANSI standards for "Vented Decorative Gas Appliances"; ANSI Z21.50-2016/CSA 2.22-2016. Install per manufacturer's instructions
  - Spark Arrestors and Chimney Screens: Provide an approved spark arrestor and custom welded copper chimney screen for all vents/chimneys, see construction drawings for information pertaining to the copper chimney screens.

**III. PERFORMANCE OF WORK**

- Installation: Install per manufacturer's instructions.

**DIVISION 10 – SECTION 2 – BATH ACCESSORIES**

**I. GENERAL REQUIREMENTS**

- Scope: This section includes all labor, material and equipment necessary to complete all work specified herein and as indicated within the construction documents. This section of work includes, but is not limited to; bath and shower enclosures, towel bars, etc.
- II. MATERIALS**
- Frameless hinged Shower and Bath Enclosures:
    - Hinges: **CR LAURENCE Cardiff Series** pivot hinges for 3/8" glass, at top and bottom of each door. Coordinating wall mount offset bracket to be used when necessary, finish to coordinate with plumbing fixtures
    - Clamps: **CR LAURENCE Square Style Notch-in-Glass** clamps, finish to coordinate with plumbing fixtures
  - Glazing: use 3/8" clear tempered glass, silicone sealant, wipes where required
  - Shower Door Hardware: **CL LAURENCE BM Series Pull Handle/Towel Bar Combination** without Metal Washers 8" Pull Handle, 22" Towel bar, finish to coordinate with plumbing fixtures. Notify Designer if smaller towel bar size is needed due to space constraints
  - Miscellaneous Glass Door Hardware: **BM Series Pull Handle** without Metal Washers 8" Pull Handle, finish to coordinate with plumbing fixtures
  - Towel Bars, Toilet Paper Holder, Towel Hooks, Towel Ring: By Owner, refer to construction documents, see plans for mounting locations and towel bar length. Blocking to be provided at all bath hardware locations as indicated on the plans.

**III. PERFORMANCE OF WORK**

- Installation: Install per manufacturer's instructions

**DIVISION 10 – SECTION 3 – EXTERIOR ACCESSORIES**

**I. GENERAL REQUIREMENTS**

- Scope: This section includes all labor, material and equipment necessary to complete all work specified herein and as indicated within the construction documents. This section of work includes, but is not limited to; architectural house numbers, mail receptacle, eave and wall vents, etc.
- II. MATERIALS**
- Architectural House Numbers: To be determined by Owner. Install per locations documented within construction documents, verify specific address numbers with Designer prior to order. Numbers shall be a min. of 4" high with a min. stroke width of 1/2" per CFC Section 505.1.
  - Mail slot: To be determined by Owner. Install per locations documented within construction documents.
  - Mail receptacle: To be determined by Owner. Install per locations documented within construction documents.

**III. PERFORMANCE OF WORK**

- Installation: Refer to construction documents, see details

**DIVISION 11 – SECTION 1 – RESIDENTIAL APPLIANCES**

**I. GENERAL REQUIREMENTS**

- Scope: This section includes all labor, material and equipment necessary to complete all work specified herein and as indicated within the construction documents.
- II. MATERIALS**
- Appliances not specified within the construction documents are to be selected by the Owner. Provide cost allowance for items not selected.
- III. PERFORMANCE OF WORK**
- Install all appliances per manufacturer's instructions.
  - All work and materials shall be in accordance with all governing and applicable codes, rules and regulations, the **Uniform Mechanical Code** and the **National Electrical Code**, latest adopted editions.
  - All equipment shall be clean, connected and tested for proper operation. All equipment operating instructions and component warranty information shall be given to Owner at project completion.

**DIVISION 15 – SECTION 1 – PLUMBING**

**I. GENERAL REQUIREMENTS**

- Scope: This section includes all labor, material and equipment necessary to complete all work specified herein and as indicated within the construction documents. Furnish and install a complete plumbing system in full compliance with all applicable sections of the latest adopted codes and governing regulations.
  - Special Requirements: All work performed under this section shall be performed by a State of California licensed plumbing contractor.
- II. MATERIALS**
- All materials shall be new and shall be in full conformance with all governing and applicable codes, rules and regulations.
  - All water lines shall be insulated PEX (cross-linked polyethylene pipe) and shall include the following: distribution manifold(s) with balancing and flow control valves where required, cold expansion and compression sleeve fittings, pipe fasteners as approved by the manufacturer of the PEX piping.
  - All waste lines above the slab within the building shall be cast iron. All others shall be A.B.S. DWV Schedule 40.
  - Fixtures and fittings shall be per the construction documents, see plumbing fixture schedule. Water closets and sinks shall have premium stainless steel flexible supply hoses with chrome connectors and fittings. Provide all accessories and connectors required for proper operation of fixtures, appliances and equipment.

- All water closets and associated flushometer valves, if any, shall be certified as using no more than 1.28 gallons per flush and shall meet the





**NICODEMUS DESIGN**

8861 Villa La Jolla Dr.,  
P.O. Box # 13367,  
La Jolla, CA 92037  
Phone: (760) 473-1041

DESIGNER:

Drawn By:  
NN

Drawing Date:  
October 10, 2023

Revisions:

revision	date	notes

**Evans Remodel**  
412 Flora Vista, Santa Barbara, CA

PROJECT:

**Specifications**

SHEET TITLE:

**GN4**

DRAWING NUMBER:

performance standards established by the American National Standard Institute Standard A112.19.2.

2. All lavatory and kitchen faucets shall be fitted with a flow-restricting aerator with a certified, maximum flow rate of no more than 1.2 gpm for lavatory faucets and 1.8 gpm for kitchen faucets per CGC 4.303.1.

E. All showerheads for all shower fixtures shall be certified as having a maximum flow rate of no more than 1.8 gallons per minute per CGC 4.303.1.

F. Water Heaters: **NAVLEN** Residential Tankless Water Heater model NPE-240A & NPE-180A. Locations as indicated within the construction documents, see mechanical/electrical plans.

G. Provide recessed washing machine supply and discharge box as manufactured by **LSP Products** Model Kahuna Outlet Box.

H. Deck drains shall be bonderized copper with built-in overflow and snap-in stainless steel cover as manufactured by **THUNDERBIRD PRODUCTS**. See plans for sizes.

I. Shower Drain: **EBBE PRO** square drain; Finish per owner.

J. Shower Drain: **QUICK DRAIN USA** low profile linear shower drain in brushed stainless steel finish; model #LDBO SS, "Tile-in" option, lengths as needed.

**III. PERFORMANCE OF WORK**

A. All work and materials shall be installed in accordance with all governing and applicable codes, rules and regulations, including the **2015 International Building Code (IBC)**, and the **2015 Uniform Mechanical Code (UMC)**, and the **2014 National Electric Code (NEC)**.

B. Cold and hot water piping to fixtures shall be thoroughly flushed and rinsed prior to placing system in service.

C. Cold and hot water piping shall be a minimum of 12" apart where piping is parallel.

D. Plumbing contractor shall review all kitchen, bath and other equipment and make service connections to each as required.

E. All hose bibs shall be provided with permanent vacuum breakers and mounted 18" above the finish surface unless otherwise noted.

F. Provide new service (gas, water and sewer) at new projects. Verify existing meter and service capacity at remodel/addition projects and upgrade and rebocate as required.

G. Where possible, water lines shall not run beneath slabs.

H. Insulate all hot water piping per Title 24 requirements.

I. Waste, vent and rain water leaders shall not run into shear walls.

J. Boring and notching of shear panels, plates and studs shall be neatly drilled or cut. Borings or notches shall be of the minimum size to accommodate the particular pipe. Refer to **SECTION 1 - STRUCTURAL CARPENTRY**.

**II. COMPLETION REQUIREMENTS**

A. All equipment shall be clean, connected and tested for proper operation. Any extra parts and operating or maintenance instructions shall be given to the Owner.

**DIVISION 15 - SECTION 2 - HEATING AND AIR CONDITIONING**

**I. GENERAL REQUIREMENTS**

A. Scope: This section includes all labor, material and equipment necessary to complete all work specified herein and as indicated within the construction documents. The work of this section includes, but is not limited to, system layout, system sizing calculations, ducts and duct installation, equipment and equipment installation, grilles/registers and installation, thermostat, any system adjustment needed or required, and

any material or fitting not specifically mentioned, but which are necessary to make a complete, properly functioning system.

B. Special Requirements:

1. All work performed under this section shall be performed by a State of California licensed mechanical contractor.

2. Duct layout shown on plans is schematic. Contractor shall be responsible for design of all ductwork and registers. All duct work shall be sized and installed in accordance with **Chapter 8 of 2015 Uniform Mechanical Code (UMC)**, and **C.C.R. Title 24, part 4**.

**II. MATERIALS**

A. All work and materials shall be in accordance with all governing and applicable codes, rules and regulations, the **2015 International Building Code (IBC)**, and **2015 Uniform Mechanical Code (UMC)**, and the **2014 National Electric Code (NEC)**.

1. Forced Air Units, Air Intake and Exhaust Fan and Cooling Equipment:

a. Split System: **FUJITSU ASUGRLF& AOUSRLFW1** wall mounted split system, 9,000 BTU cooling/10,200 BTU heating

b. Air Intake and Exhaust Fan: **FANTECH VHF04**. Refer to construction documents; see mechanical/electrical plans for locations and additional information.

2. Above-grade Supply and Return Ductwork: 26 ga. flex sheetmetal, insulated per Title 24.

a. Under-slab Ductwork: PVS clad steel ducts (ICBO #2872)

3. Supply Registers:

a. Wall: **HART & COOLLY A600** Series or equal.

b. Ceiling: **HART & COOLLY A500** Series or equal.

4. Thermostat: **NEST** Learning Thermostat.

**III. PERFORMANCE OF WORK**

A. Under-slab ducts shall slope back to supply plenum at 1/8" /ft. Seal all joints with **GLENCOAT** compound. Encase all joints, transitions, register boxes and plenums in minimum 3" thick concrete. Wrap remaining ducts in .005" polyethylene, folded and stapled at top of duct, and encase in 3" minimum of clean sand.

B. All above-grade supply and return ducts and plenums shall be sealed airtight at all duct joints, branch takeoffs and connections to equipment with a non-hardening, non-migrating mastic or liquid elastic sealant as recommended by the manufacturer specifically for sealing joints and seams in ductwork.

C. The return air plenum serving the mechanical equipment must be fully ducted from equipment to the conditioned space. Dropped ceilings, wall cavities and equipment platforms may not be used as plenums.

D. Visible portions of supply and return ducts shall be painted black behind registers and grilles.

E. Coordinate equipment installation locations with all trades prior to installation of equipment.

F. Exhaust fans for baths and laundry room shall provide 5 air changes per hour. Refer to the construction documents, see lighting fixture schedule for exhaust fans, type and size. Exhaust discharge point shall be at least 3 ft. from any openings into the building.

G. Mechanical system seismic restraints shall conform to "Guidelines for Seismic Restraints of Mechanical Systems" as published by **SMACNA 2008** edition and/or **2015 International Building Code (IBC)**.

H. Air conditioning units cannot be placed in the front or side yard setbacks, or in the five foot rear yard (accessory building) setback. All machinery must conform to the City of Coronado Noise Ordinance.

I. Equipment access shall conform to **2015 Uniform Mechanical Code (UMC)**.

**IV. COMPLETION REQUIREMENTS**

A. All equipment shall be clean, connected and tested prior to operation. Any extra parts and operating or maintenance instructions shall be given to the Owner.

B. Once system is in place Contractor shall test system for the following: Balance system to provide even heating and cooling in all rooms, adjust ducting to eliminate any air noises.

**DIVISION 16 - SECTION 1 - ELECTRICAL POWER & LIGHTING**

**III. GENERAL REQUIREMENTS**

A. Scope: This section includes all labor, material and equipment necessary to complete all work specified herein and as indicated within the construction documents. Also included are materials not specifically mentioned herein or shown, but which are necessary to make a complete, properly functioning electrical system.

1. A complete service and distribution system including the main panels, conduit, conductor, breakers, sub panels, etc. as required. Electrical contractor shall provide electrical load calculations, single line diagram and panel schedules to City Building Department prior to start of work.

2. Complete branch circuit wiring system for lighting, motors, vents, receptacles and junction boxes as shown or specified.

3. Furnishing and installation of lighting fixtures, receptacles, fans, etc. as shown on the plans complete with all lamps.

4. Minor cutting and notching as required for proper installation of electrical system.

5. Trenching necessary for underground telephone and electrical service needed.

6. Refer to the construction documents, see appliance schedule for appliances and their respective electrical requirements. Also refer to mechanical plan for equipment schedule.

B. Special Requirements: All work performed under this section shall be performed by a State of California Licensed electrical contractor.

**IV. MATERIALS**

A. All work and materials shall be in accordance with all governing and applicable codes, rules and regulations, the **2015 International Building Code (IBC)**, and the **2015 Uniform Mechanical Code (UMC)**, and the **2014 National Electric Code (NEC)**.

B. All materials shall be new and UL listed (Refer to the construction documents, see electrical plans and lighting schedule for fixtures). Provide a cost allowance for items not selected.

C. All wiring shall be copper. Wire gauge shall be sufficient for anticipated electrical loads.

D. Receptacles, wall plates and other related receptacles such as telephone jacks, GFCI receptacles and cable outlets shall be **LEVITON Decora**. Color of all items shall be white unless otherwise noted.

E. Switches and dimmers shall be **LEVITON Decora** controls. See **DIVISION 16 - SECTION 2 - GYPSUM WALLBOARD**.

F. Timer switches shall be fan/light time delay type, as manufactured by **EFI**

**V. PERFORMANCE OF WORK**

A. Contractor shall coordinate with all other trades (HVAC, Security System, Intercom/Phone System, etc.) to assist with electrical requirements as needed.

B. The locations of switches, outlets and light fixtures shown on electrical plans are approximate. Do not run wire until all boxes are in place and the Owner or Owner's agent has been called to make visual review of all locations.

C. All outlet receptacles shall be 5" above finish floor unless otherwise noted.

D. Mounting heights for light fixtures shown on plans are from finish floor or flatwork to the centerline of junction box unless otherwise noted. Also refer to Exterior and Interior Elevations for additional information regarding fixture mounting heights.

E. Convenience outlets in bathrooms, kitchens, outdoors, basements and garages shall be ground fault interrupt circuit (GFCI) type.

F. Electrical outlet plate gaskets shall be installed on all receptacles, switches or other electrical boxes in exterior walls and any walls on perimeter of conditioned space.

G. Verify electrical requirements for new appliances and mechanical equipment prior to running wire. See Appliance Schedule and plans for equipment.

H. All electrical panels shall have permanent legible labels indicating circuit use, amperage, etc.

I. Arc-fault circuit interrupted protection is required in family rooms, dining rooms, living rooms, parlors, libraries, dens, bedrooms, sunrooms, recreation rooms, closets, hallways, or similar rooms per **CEC 210.12(B)**.

J. Junction boxes for ceiling fans shall be securely fastened to framing per fan manufacturer's instructions.

K. Smoke detectors shall be installed in each bedroom and at a point centrally located serving sleeping areas and on each level of residence. Smoke detectors shall be interconnected per **CBC [F] 907.2.11.3**, permanently wired to the building electrical system and shall be equipped with battery backup per **CBC [F] 907.2.11.4**.

L. Carbon monoxide alarms shall be installed outside bedrooms, at a point centrally located serving sleeping areas and on each level of residence. Carbon monoxide alarms shall be interconnected per **CBC 420.4.1.2**, permanently wired to the building electrical system and shall be equipped with battery backup per **CBC 420.4.1.1**.

**VI. COMPLETION REQUIREMENTS**

A. All fixtures shall be clean, lamps installed and tested to respond to appropriate switch. Other electrical devices shall be tested for proper operation. Any extra lamps and operating or maintenance instructions shall be given to the Owner.

**DIVISION 16 - SECTION 2 - LOW VOLTAGE WIRING & LIGHTING CONTROLS**

**I. GENERAL REQUIREMENTS**

1. Scope: This section includes all labor, material and equipment necessary to complete all work specified herein and as indicated within the construction documents. Also included are materials not specifically mentioned herein or shown, but which are necessary to make a complete, properly functioning low voltage wiring system and lighting control system.

2. Structured wiring for television cable, data network, telephone line, built-in speaker wiring and security system pre-wire (verify location with Owner if not shown). Coordinate telephone system with local telephone company.

3. Door bell.

4. Minor cutting and notching as required for proper installation of electrical system.

5. Trenching necessary for underground telephone and cable service needed.

**II. MATERIALS**

A. All work and materials shall be in accordance with all governing and applicable codes, rules and regulations, the **2015 International Building Code (IBC)**, and the **2015 Uniform Mechanical Code (UMC)**, and the **2014 National Electric Code (NEC)**.

B. Structured Wiring Central Panel: 8-zone surface mounted distribution panel with cover for structured wiring. **HONEYWELL Super-Pro, LEVITON Structured Media Series**, or equal.

C. Jacks/Data Ports: Shall be single-gang **LEVITON** Quickports with **Decora** coverplates. Color off all items shall be white unless otherwise noted.

D. All wiring shall be copper. All materials shall be new and UL listed. Wire gauge shall be sufficient for anticipated electrical loads.

1. Phone Cable: CAT6

2. Co-axial: RG6

3. Audio/Visual Cable: 14 ga. **TRX-certified Monster Cable**.

E. Door Bell:

1. Button: Hardwired doorbell button by owner; refer to construction drawings for location information.

2. Chime: Per Owner.

**III. PERFORMANCE OF WORK**

A. Contractor shall coordinate with all other trades as needed.

B. All electric switches, unless otherwise noted on plan, are to be located 48" above the finish floor. The locations of switches and jacks/data ports shown on electrical plans are approximate. Do not run wire until after all boxes are in place and the Owner or Owner's agent has been called to make visual review of all locations.

C. Mounting heights for jacks/data ports shown on plans are from finish floor or flatwork to the centerline of junction box unless otherwise noted.

D. Electrical outlet plate gaskets shall be installed on all jacks/data port boxes in exterior walls and any walls on perimeter of conditioned space.



revision	date	notes

## 4 Termination Location and Vent Information

### A. Chimney Diagram

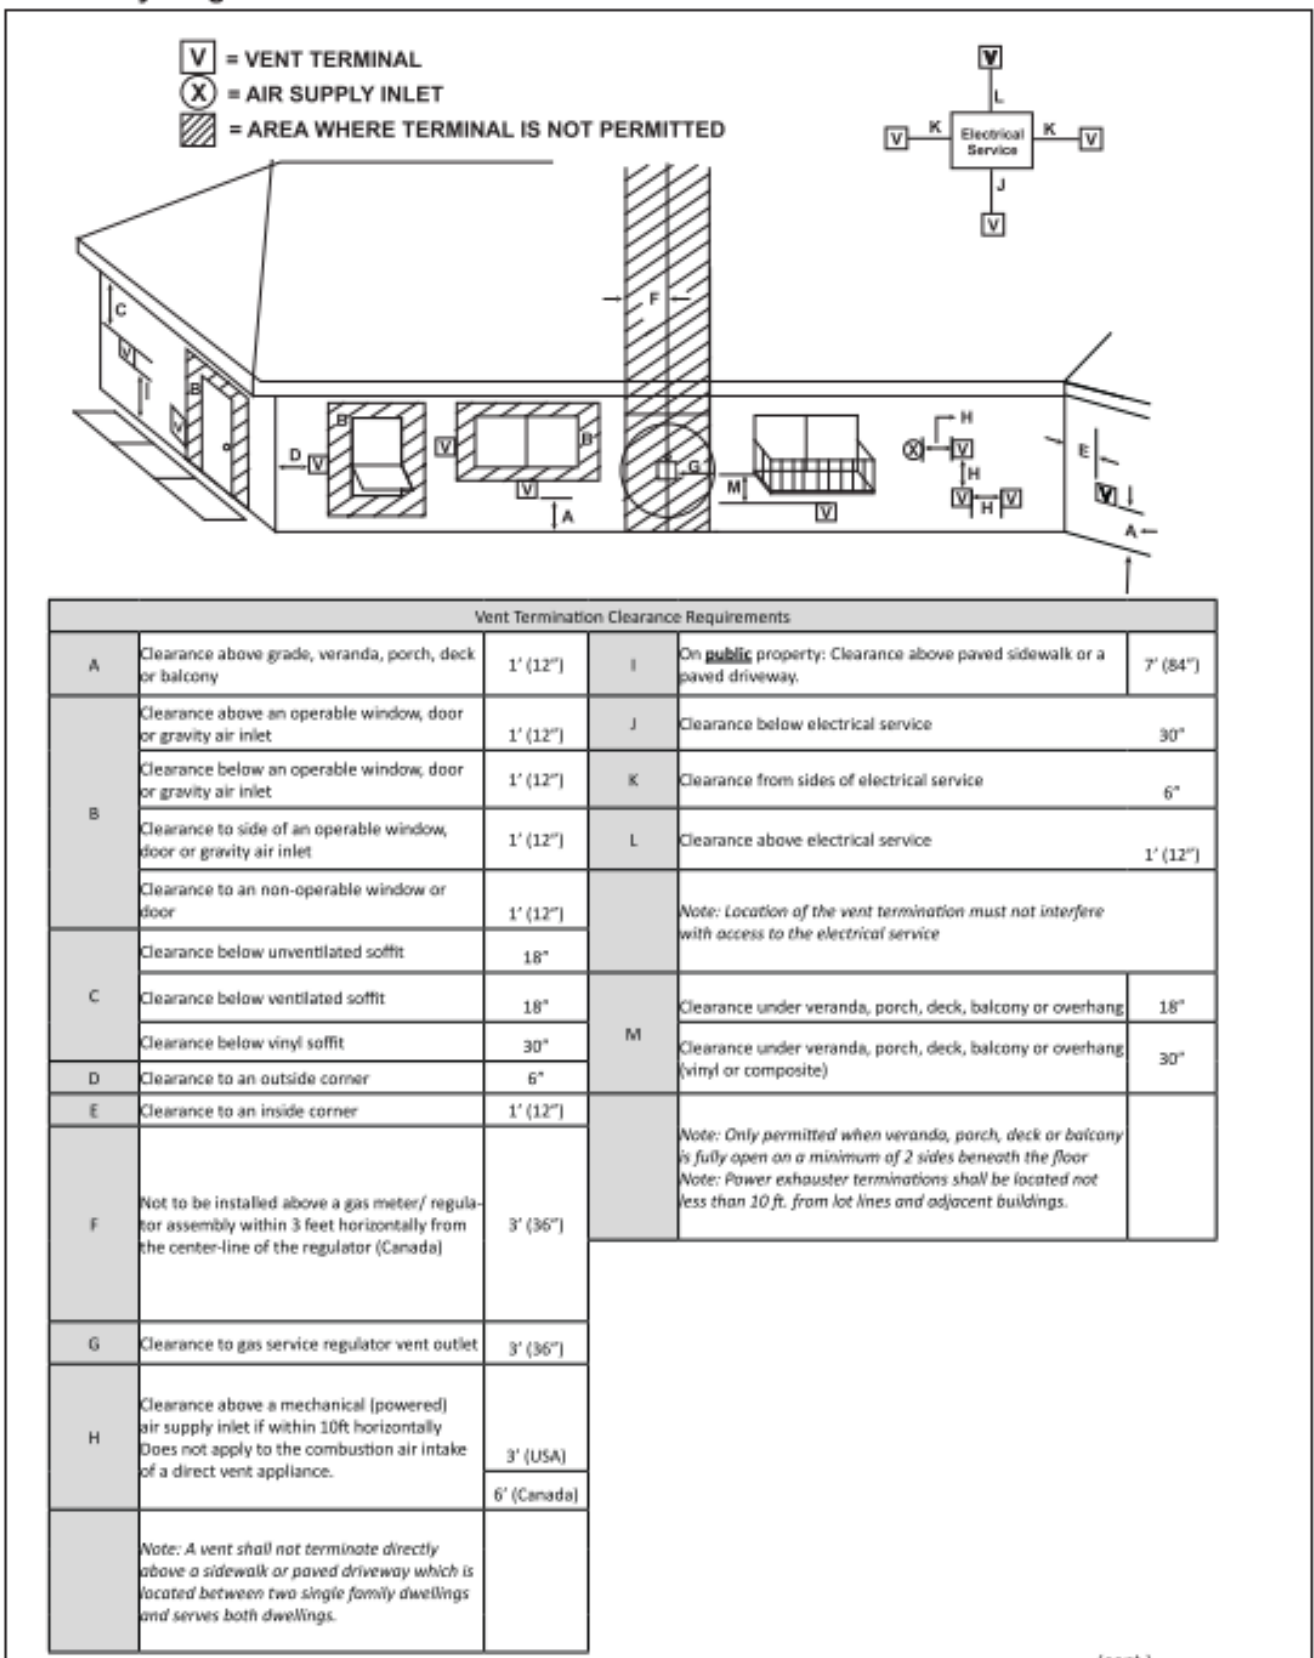


Figure 4.1 Minimum Clearances for Termination (cont.)

### B. Approved Pipe

This appliance is approved for use with Hearth & Home Technologies SLG venting system. Refer to Section 12.A for vent component information and dimensions. DO NOT mix pipe, fittings or joining methods from different manufacturers. The pipe is tested to be run inside an enclosed wall. There is no requirement for inspection openings at each joint within the wall. **WARNING! Risk of Fire or Asphyxiation.** This appliance requires a separate vent. DO NOT vent to a pipe serving a separate solid fuel burning appliance.

### C. Use of Elbows

- A maximum of three 90° elbows (or six 45°) may be used in any vent configuration.
- Each 90° elbow, whether installed vertically or horizontally, counts as two feet towards the total vent run.
- Each 45° elbow, whether installed vertically or horizontally, counts as one foot towards the total vent run.
- Elbows may be placed back to back anywhere in the system.
- Any 90° elbow may be replaced with two 45° elbows.

**WARNING:** Elbows may NOT be installed in a downward direction. Figure 4.3 shows the vertical and horizontal offsets for SLG elbows.

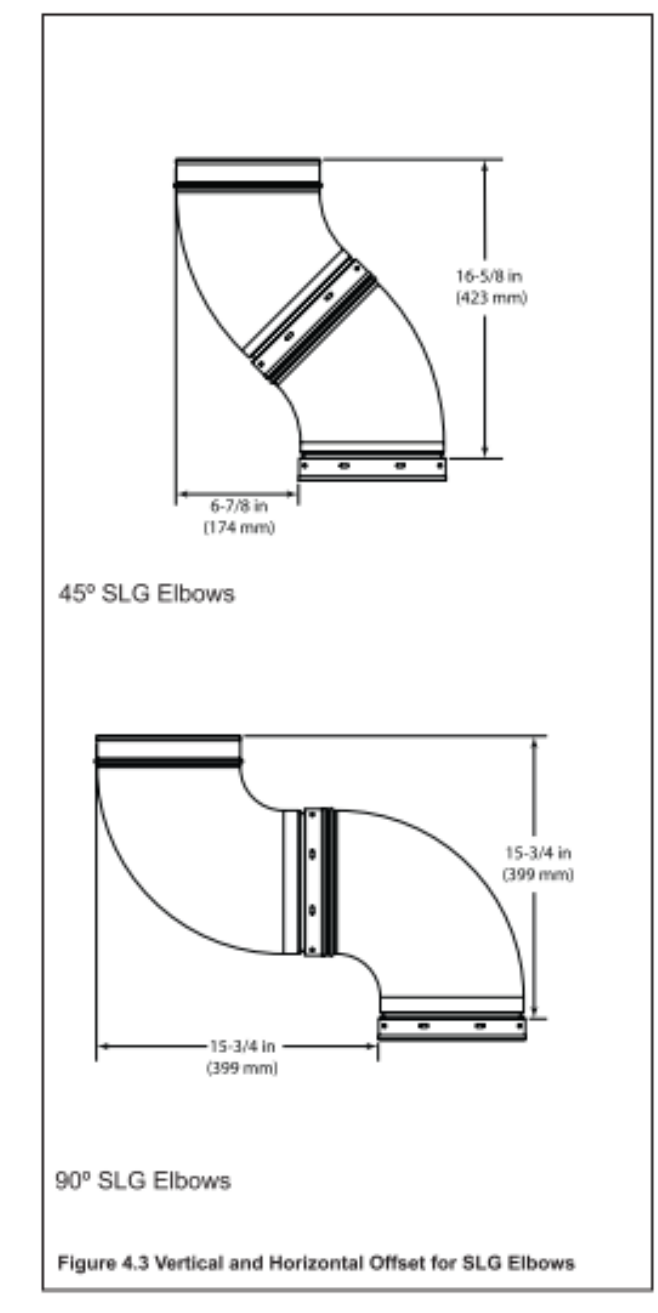


Figure 4.3 Vertical and Horizontal Offset for SLG Elbows

### E. Vent Diagrams

As shown in Figure 4.5, many different top vent or vent configurations are possible with the PHOENIX appliance, however there are few general rules that must be followed:

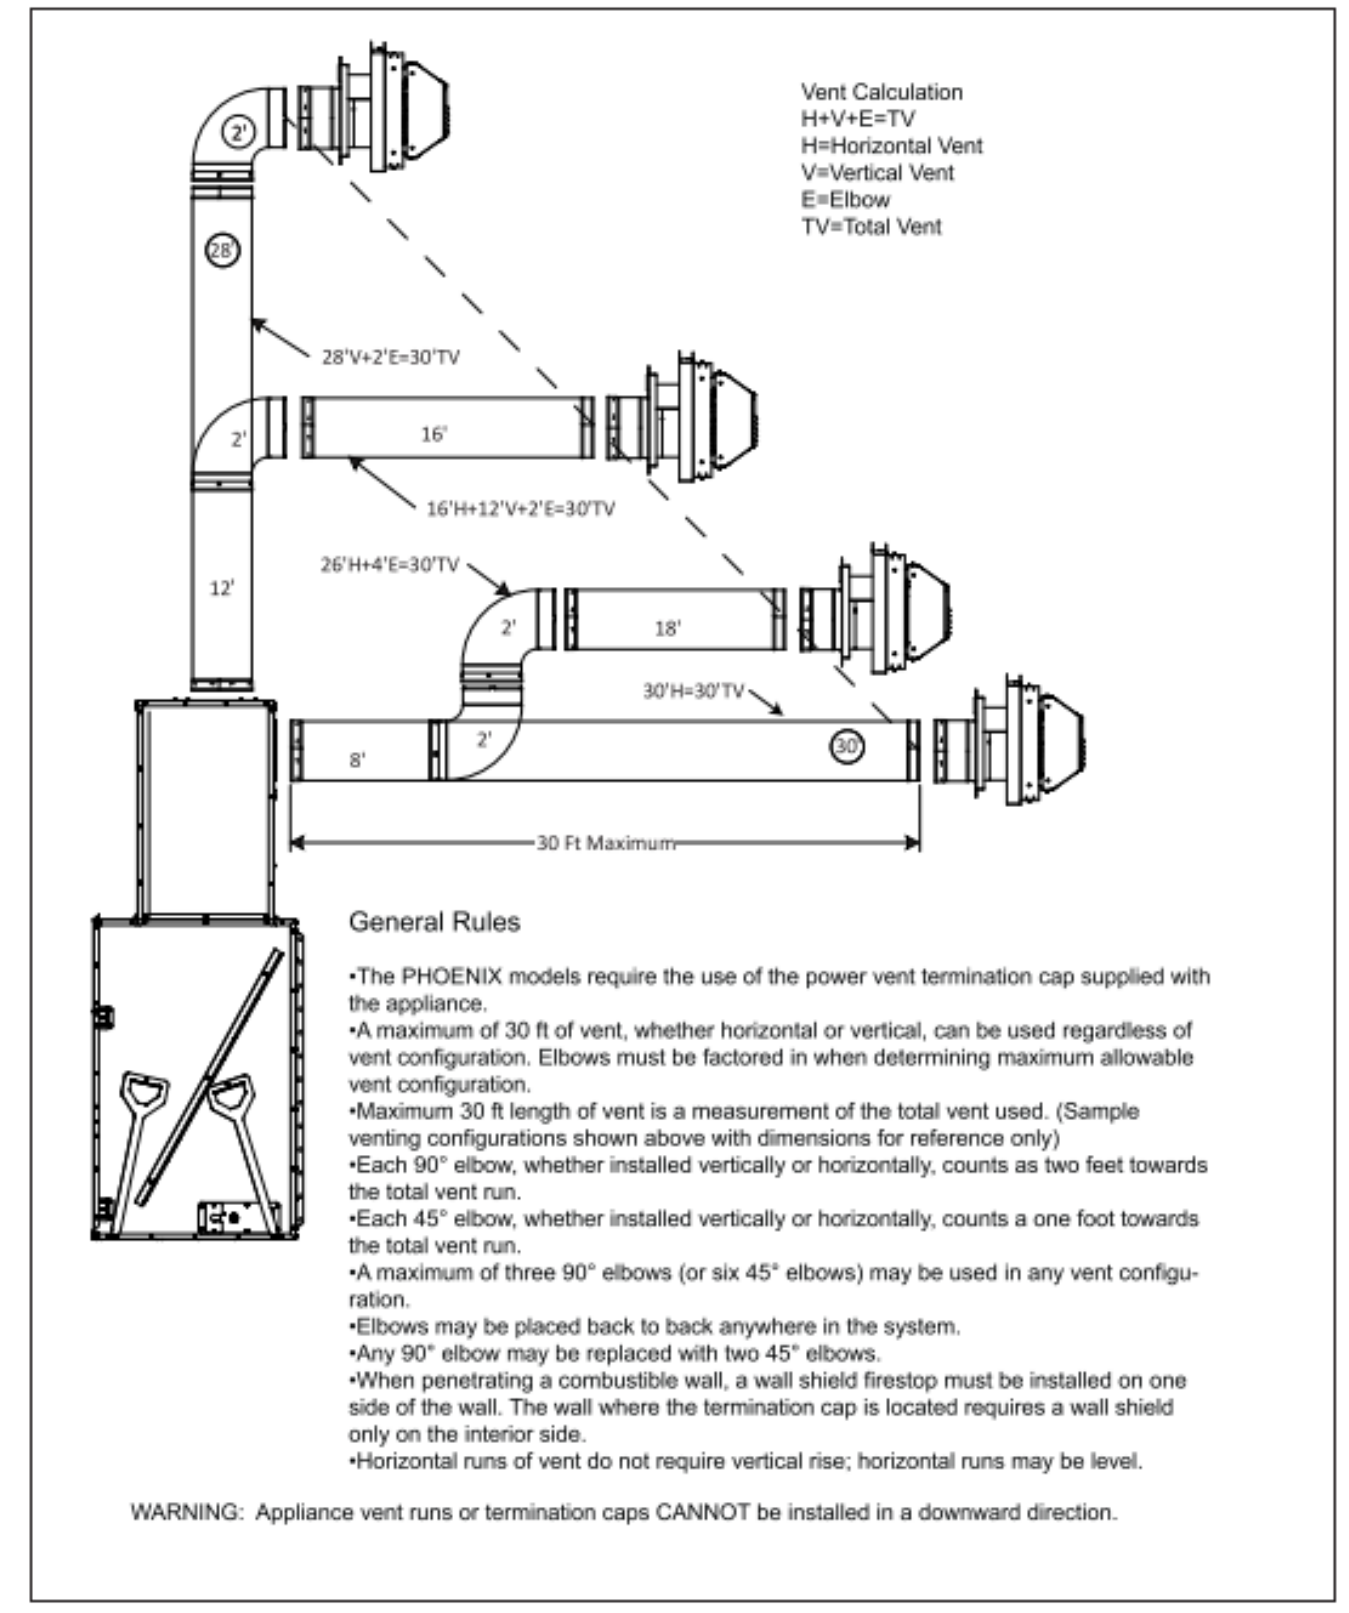


Figure 4.5 Venting

## 5 Vent Clearances and Framing

### A. Pipe Clearances to Combustibles

**WARNING! Risk of Fire! Maintain air space clearance to vent. DO NOT pack insulation or other combustibles:**

- Between ceiling firestops
- Between wall shield firestops
- Around vent system

Failure to keep insulation or other material away from vent pipe could cause overheating and fire.

Note: Heat shields MUST overlap by a minimum of 1-1/2 in. (38 mm).

- SLG heat shield - designed to be used on a wall 4 in. to 7 in. (102 mm to 178 mm) thick.
- If wall thickness is less than 4 in., the existing heat shields must be field trimmed.

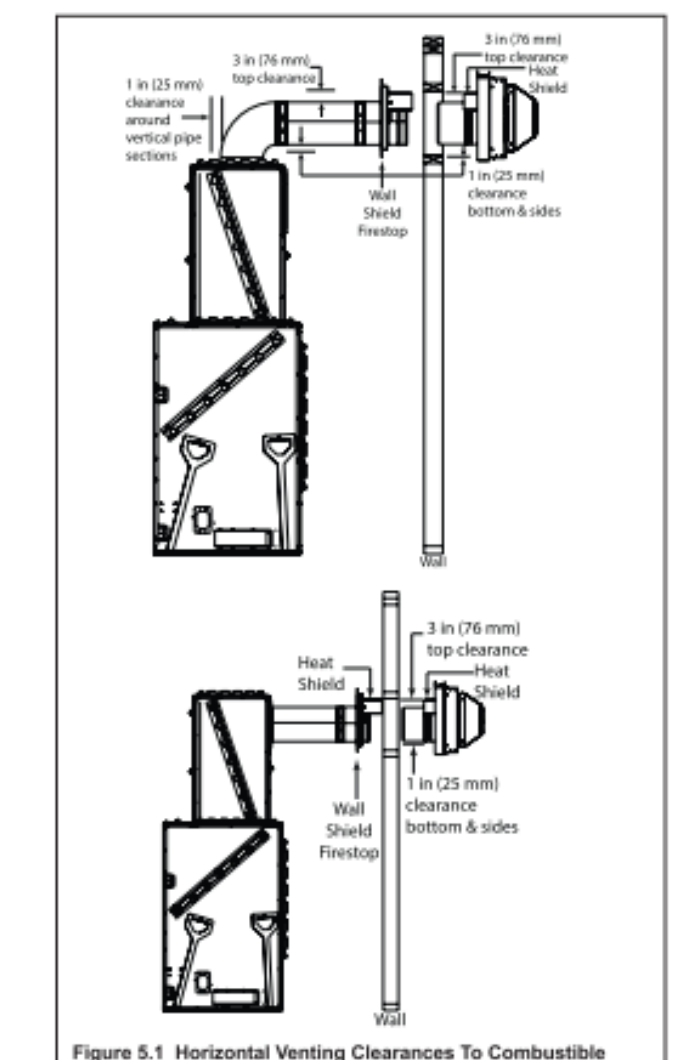


Figure 5.1 Horizontal Venting Clearances To Combustible Materials

### B. Wall Penetration Framing/Firestops

**Combustible Wall Penetration**  
Whenever a combustible wall is penetrated, you must frame a hole for the wall shield firestop(s). The wall shield firestop maintains minimum clearances and prevents cold air infiltration.

- The opening must be framed on all four sides using the same size framing materials as those used in the wall construction.
- The PHOENIX appliance is supplied with a wall shield specifically designed for use on the inside of the exterior wall in which the termination cap is to be located. A minimum of 1-1/2 in. (38 mm) overlap of attached heat shields must be maintained.
- A wall shield (DVP-WS) must be placed on one side of the interior walls. See Section 7.E for information regarding the installation of a horizontal termination cap.

**Non-Combustible Wall Penetration**  
If the hole being penetrated is surrounded by non-combustible materials such as concrete, a hole with diameter one inch greater than the pipe is acceptable.

Whenever a non-combustible wall is penetrated, the wall shield firestop is only required on one side and no heat shield is necessary.

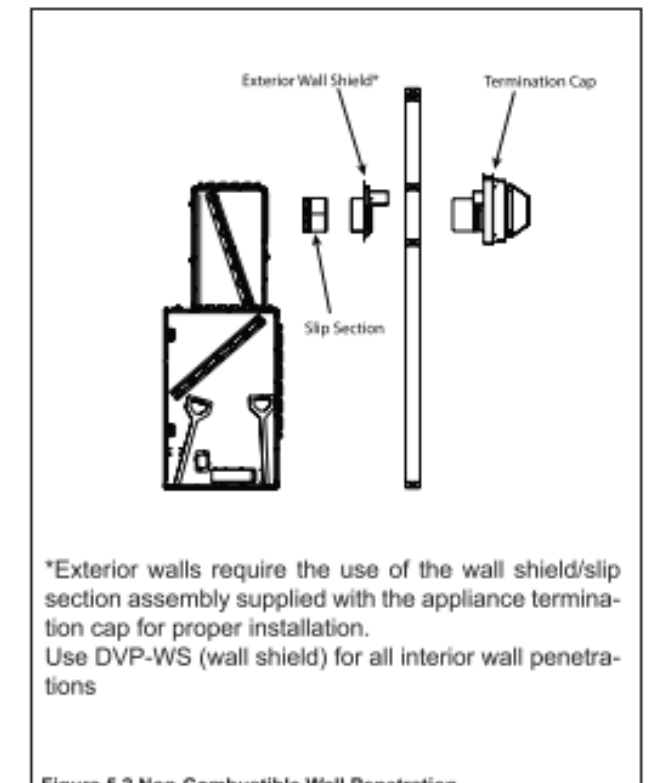


Figure 5.2 Non-Combustible Wall Penetration

### Chimney Diagram (cont.)

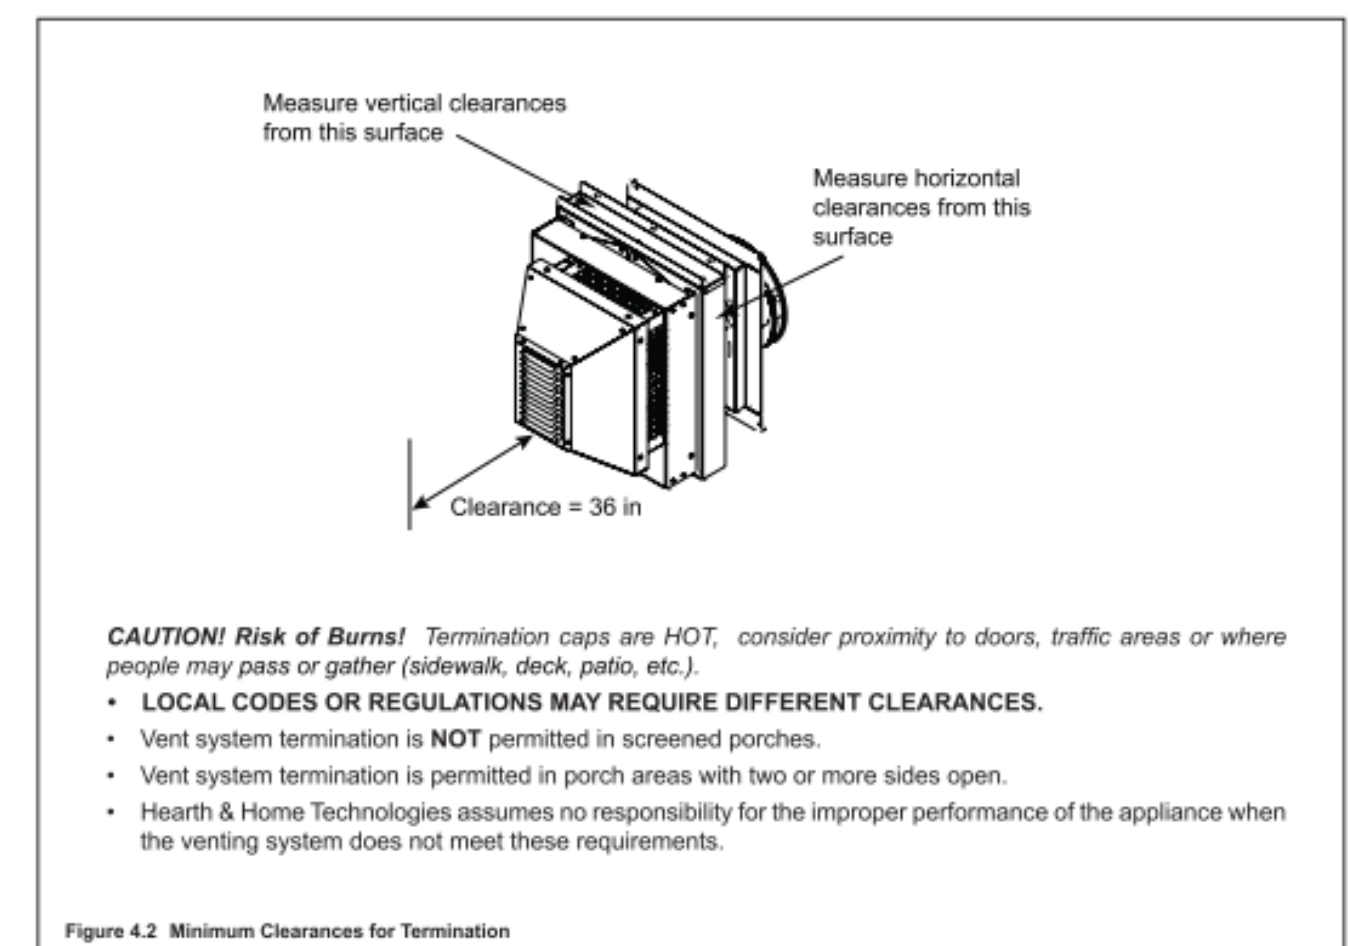


Figure 4.2 Minimum Clearances for Termination

### D. Measuring Standards

Vertical and horizontal measurements listed in the vent diagrams were made using the following standards:

- Pipe measurements are shown using the effective length of pipe. See Figure 4.4 for information on effective length of pipe components.
- Total vent length is measured from the start of the vent run, to the end of the vent run, including straight pipe as well as elbows.
- Horizontal pipe installed level with no rise.

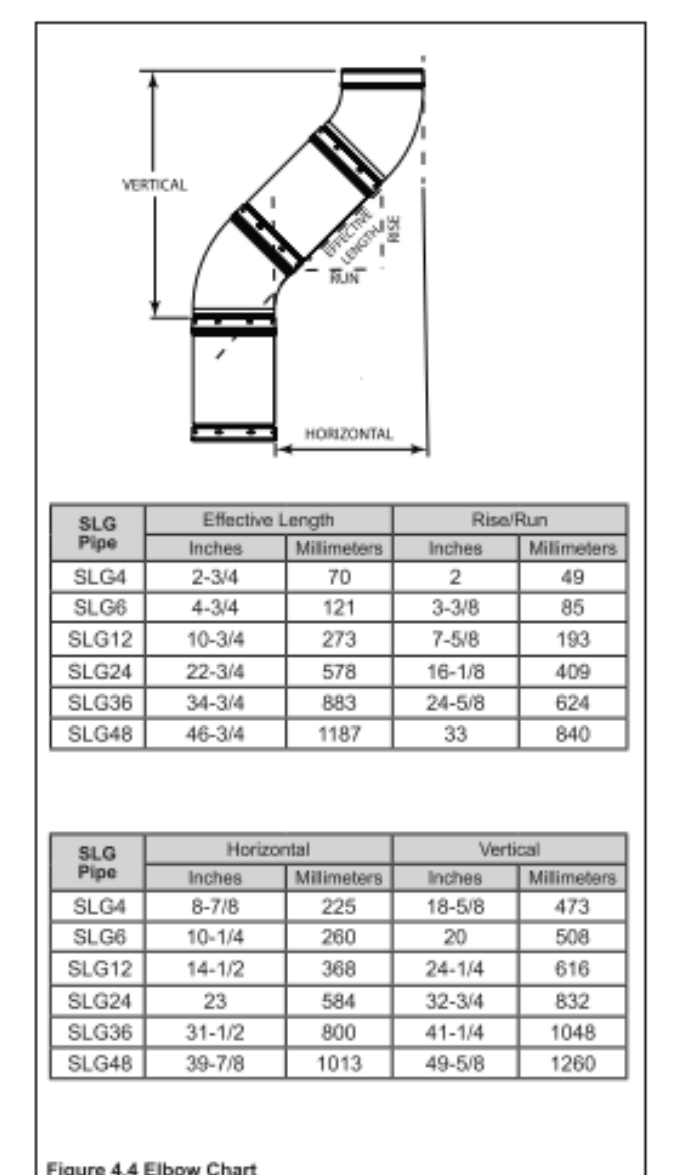


Figure 4.4 Elbow Chart


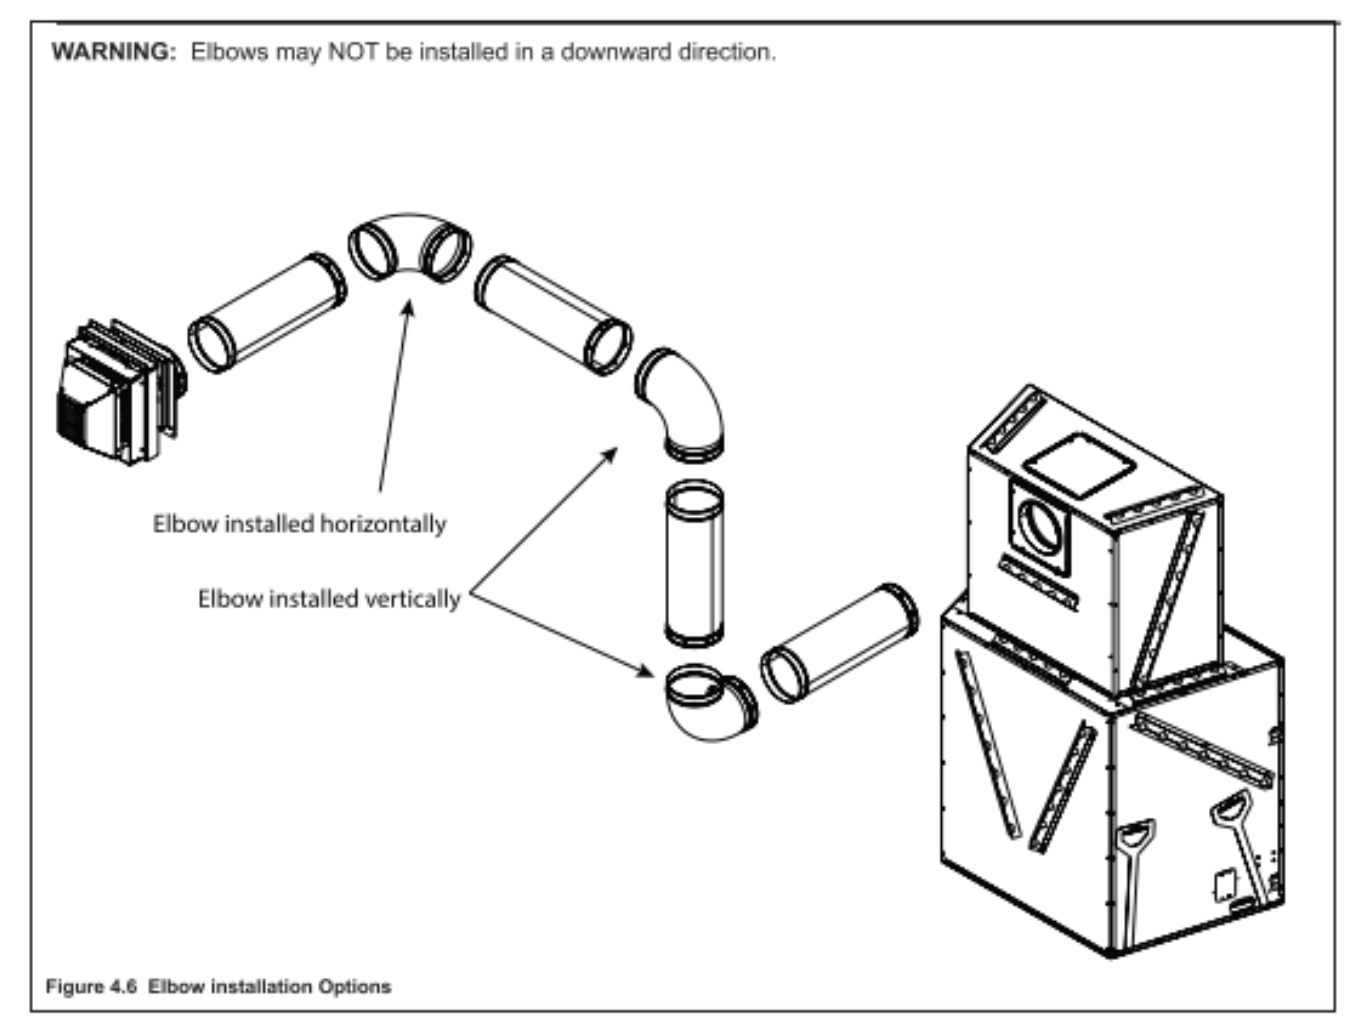


Figure 4.6 Elbow Installation Options






2 Existing Photo

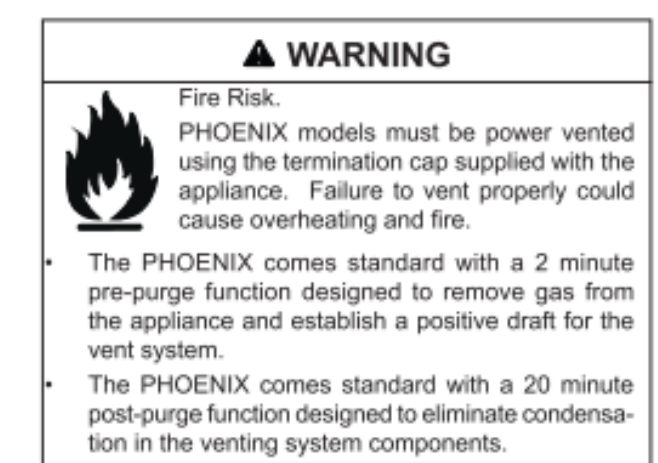

3 Existing Photo



4 Existing Photo

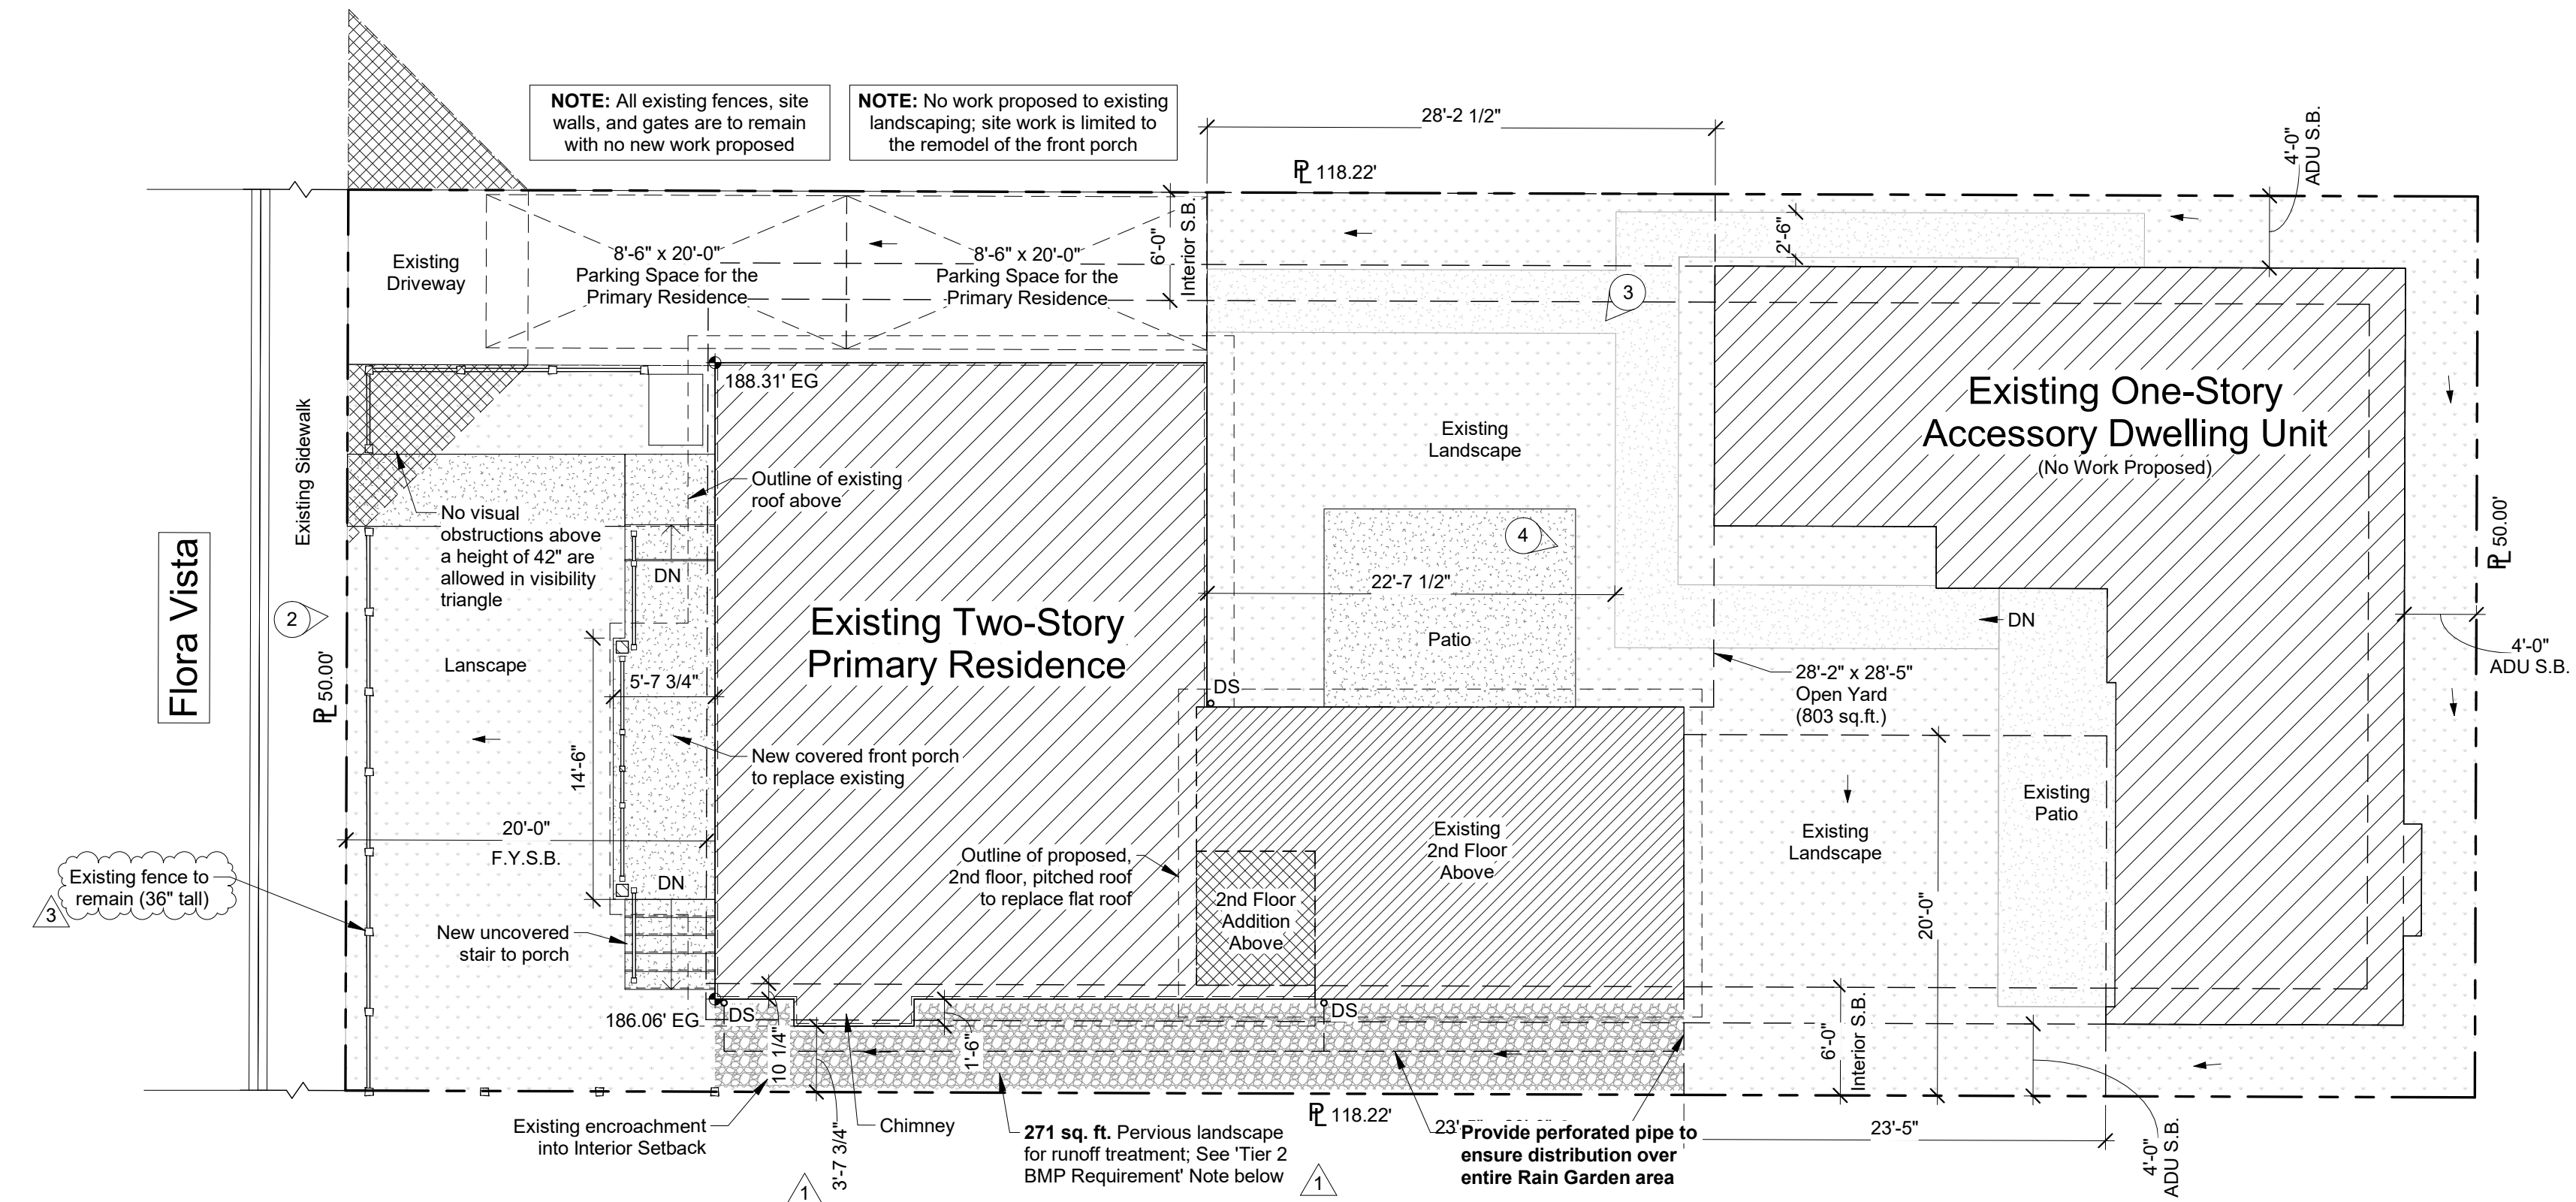

1 Site Plan  
1/8" = 1'-0"

**Mechanical and Other Equipment:**

SBMC 30.140.130:

- A. Attached Equipment.** Equipment attached to the outside wall of a structure, located at least 30 inches above adjacent grade, may encroach a maximum of three feet into any interior setback or open yard, but shall be no closer than two feet to any property line.
- B. Roof-Mounted Equipment.** Roof-mounted equipment shall be hidden from view or screened pursuant to Section 30.15.120, Screening.
- C. Free-Standing Equipment.**
  - 1. Location.** Freestanding equipment, and associated screening or enclosures, may be located within the front yard and may encroach into any setback or open yard, except private open yard, and as follows:
    - a. Residential Uses. On lots developed with residential uses only, freestanding equipment and enclosures shall be no closer than 10 feet to any front lot line, and no closer than five feet to any interior lot line adjacent to property zoned for residential use or developed with residential uses.
    - b. Nonresidential and Mixed-Use. On lots developed with nonresidential uses or mixed-use, freestanding equipment and enclosures shall be no closer than five feet to any front lot line, and no closer than five feet to any interior lot line adjacent to property zoned or developed with residential uses.
    - c. Maximum Area. Freestanding equipment and enclosures in the front yard or open yard is limited to a cumulative total of 50 square feet.
  - 2. Screening.** All freestanding equipment shall be hidden from view or screened, pursuant to Section 30.15.120, Screening.

**Open Yard:**

Area 1 (North of Primary Residence): 803 sq. ft.  
Area 2 (East of Primary Residence): 469 sq. ft.  
**Total: 1,272 sq. ft.**

**Legend**

	Concrete		Existing 1-Story
	Natural Stone Tile		Existing 2-Story
	Landscape		Proposed Addition
	Site Drainage		Rain Garden for runoff treatment

**General Plot Plan Notes:**

- 1) All plan dimensions given are to finish face, U.N.O.
- 2) Yard setbacks are to be measured from the exterior wall finish to the property line and not from the outside of the footing (or face of studs).
- 3) All fence construction, site walls, and gates will be under a separate Building Permit
- 4) Existing drainage to remain. All surface water is to drain away from buildings at a MIN of 5% slope within the first 10 feet (2% for impervious surfaces). Contractor to approve all drainage schemes prior to completion of the project.
- 5) Site grading or drainage system will manage all surface water flows to keep water from entering buildings (swales, water collection, French drains, etc.). CGC 4.106.3 Exception: Additions not altering the drainage path.
- 6) Automatic irrigation system controllers shall comply with the CGC Section 4.304.2 as follows: A. Controllers shall be weather or soil moisture based that automatically adjust irrigation in response to changes in needs as weather conditions change. B. Weather based controllers shall have separate wired or wireless rain sensor which connects or communicates with the controller(s). Soil moisture based controllers are not required to have rain sensors.
- 7) See specifications for general construction requirements

**Tier 2 BMP Requirement - Runoff Treatment Area:**

Per City of Santa Barbara Storm Water BMP Guidance Manual (page 61):  
"One simple and inexpensive way to comply with Tier 2 requirements involves providing natural/vegetated/mulched area totaling at least 25% of tributary impervious surface area. Runoff shall be able to "access" the entire 25% treatment area to ensure maximum infiltration. The proposed permeable treatment area must have a slope less than 7%, and be at least 18" wide."

**Proposed Redeveloped Impervious Area: 683 sq. ft.**  
2nd Floor Roof: 548 sq. ft. (see roof plan 4/A3)  
Entry Porch Roof: 135 sq. ft. (see plan 1/A3)

683 sq. ft. x 0.25 = 170.75 sq. ft. Pervious Treatment Area Required

**Pervious Treatment Area Provided: 271 sq. ft. (see southern side yard on Site Plan 1/A1)**

**NOTE:** See plans 4/A3 and 1/A3 for downspout locations. Runoff from downspouts to sheet flow over pervious landscape area, where sheet flow does not occur naturally, utilize a flow spreader such as a level spreader or disperser.

DESIGNER:

*Signature*

Drawn By:  
NN

Drawing Date:  
October 10, 2023

Revisions:

revision	date	notes
1	12/13/23	Plan Check
3	05/04/24	Plan Check

**Evans Remodel**  
412 Flora Vista, Santa Barbara, CA

PROJECT:

Site Plan

A1

DRAWING NUMBER:



### Door Schedule:

No.	Size		Type	Operati on	Glass	U-Factor	SHGC	Description
	Width	Height						
1	3'-0"	6'-8"	A	sw	Temp	0.3	0.22	
2	2'-6"	6'-8"	C	pkt				
3	4'-8"	6'-8"	E	sw				Dbi. Dr. w/ magnetic catch
4	3'-6"	7'-0"	D	sl				
5	2'-0"	6'-8"	C	sw				
6	6'-0"	7'-0"	B	sw	Temp	0.3	0.22	w/ 1'-6" sidelites
7	2'-8"	6'-8"	F	sw				
8	2'-6"	7'-0"	C	sw				
9	2'-6"	6'-8"	C	pkt				
10	2'-6"	7'-0"	C	sw				
E1	2'-6"	6'-8"	C	sw				Existing, confirm w/ Owner
E2	6'-0"	6'-8"	C	sw				Existing, confirm w/ Owner
E3	2'-0"	6'-8"	C	sw				Existing, confirm w/ Owner

### Door Legend:

<b>Type:</b>	<b>Operation:</b>
A Custom Wood Dutch Door	sw Swing
B Aluminum-Clad, Wood, French Doors by Lincoln Windows	sl Slide
C Interior Door: 1 3/4" Thickness	pkt Pocket
D Barn Door: BD 02 White Oak Whitewash by Urban Doors	fld Fold
E Louvered Doors: 1 3/4" Thickness, MIN 100 sq. in. of free area opening	pvt Pivot
F Fiberglass Exterior Door	byp Bypass
	oh Overhead

Note: Door Hardware TBD

**Note:**  
Contractor to submit door and window quotes for designer's review prior to order

### Window Schedule:

No.	Size		Type	Class	U-Factor	SHGC	Comments
	Width	Height					
1	3'-0"	4'-0"	Casement	Temp	0.3	0.22	
2	3'-0"	4'-0"	Casement	Temp	0.3	0.22	
3	2'-0"	4'-0"	Fixed		0.3	0.22	
4	2'-0"	4'-0"	Casement		0.3	0.22	
5	3'-0"	4'-0"	Casement		0.3	0.22	
6	3'-0"	4'-0"	Casement		0.3	0.22	
7	3'-0"	4'-0"	Casement		0.3	0.22	
8	2'-0"	3'-0"	Casement		0.3	0.22	
9	3'-0"	3'-0"	Fixed		0.3	0.22	
10	2'-0"	3'-0"	Casement		0.3	0.22	
11	2'-0"	4'-0"	Fixed		0.3	0.22	
12	2'-0"	4'-0"	Fixed		0.3	0.22	
13	2'-0"	4'-0"	Casement	Temp	0.3	0.22	
14	2'-0"	4'-0"	Casement	Temp	0.3	0.22	
15	3'-0"	4'-0"	Casement		0.3	0.22	
16	3'-0"	2'-0"	Awning		0.3	0.22	
17	3'-0"	2'-0"	Awning		0.3	0.22	
18	6'-0"	4'-0"	French Casmt		0.3	0.22	
19	4'-0"	4'-0"	French Casmt	Temp	0.3	0.22	
E1	6'-0"	4'-0"	Sliding		0.3	0.22	Existing Size, Confirm w/ Owner
E2	3'-0"	4'-0"	Casement		0.3	0.22	Existing Size, Confirm w/ Owner
E3	3'-0"	4'-0"	Casement	Temp	0.3	0.22	Existing Size, Confirm w/ Owner
E4	6'-0"	3'-0"	French Casmt		0.3	0.22	Existing Size, Confirm w/ Owner
E5	2'-6"	2'-6"	Casement		0.3	0.22	Existing Size, Confirm w/ Owner

### Window Notes:

- See Specification DIVISION 8 for additional information pertaining to windows
- Provide Min. clear egress opening dimensions at each window marked for egress at room locations
- Windows to be installed per detail 1/A5
- See elevations for specific mullion design
- Sash profiles of fixed windows to match adjacent operable windows

NOTE: The NFRC thermal performance labels shall remain on the windows and/or doors until final inspection

### Finish Schedule:

Name	Floor	Floor Finish	Wall	Wall Finish	Ceiling	Ceiling Finish
Dining	Wood	Clear	Gyp.	Paint	Gyp.	Paint
Kitchen	Wood	Clear	Gyp.	Paint	Gyp.	Paint
Living	Wood	Clear	Gyp.	Paint	Gyp.	Paint
Primary Bath	Tile	--	Gyp.	Paint	Gyp.	Paint
Primary Bedroom	Wood	Clear	Gyp.	Paint	Gyp.	Paint
Primary Closet	Carpet	--	Gyp.	Paint	Gyp.	Paint

### Finish Notes:

- All finishes selected by Owner
- Finish items to be installed per manufacturer's approved procedures, methods, an applicable industry standards
- See specifications for additional information
- Gypsum board walls and ceilings finish to be lightest hand trowel finish
- Contractor is to install closet shelves and clothing rods as noted in plans or as specified by owner prior to completion of construction
- Countertops in all kitchens, laundry rooms, and bathrooms to be stone or solid surface cultured stone. Specific material TBD


### Under-Floor Ventilation Calc's:

9.29 sq. ft. REQUIRED (1,394 sq. ft./150 = 9.29 sq. ft.)

63.2 sq. ft. PROVIDED

20 Under-floor Vents (UFV) x 3.16 sq. ft. = 63.2 sq. ft.  
Under-floor Vents: 16" W x 8" H (38 sq. in. NFVA Airflow)

- Notes:
- Openings located within 3' of each corner of building
  - All Foundation Vents to be Fire-Rated 16" x 8" FV2021-PG by BrandGuard; See Specifications
  - See detail for 5/A5 under-floor vents

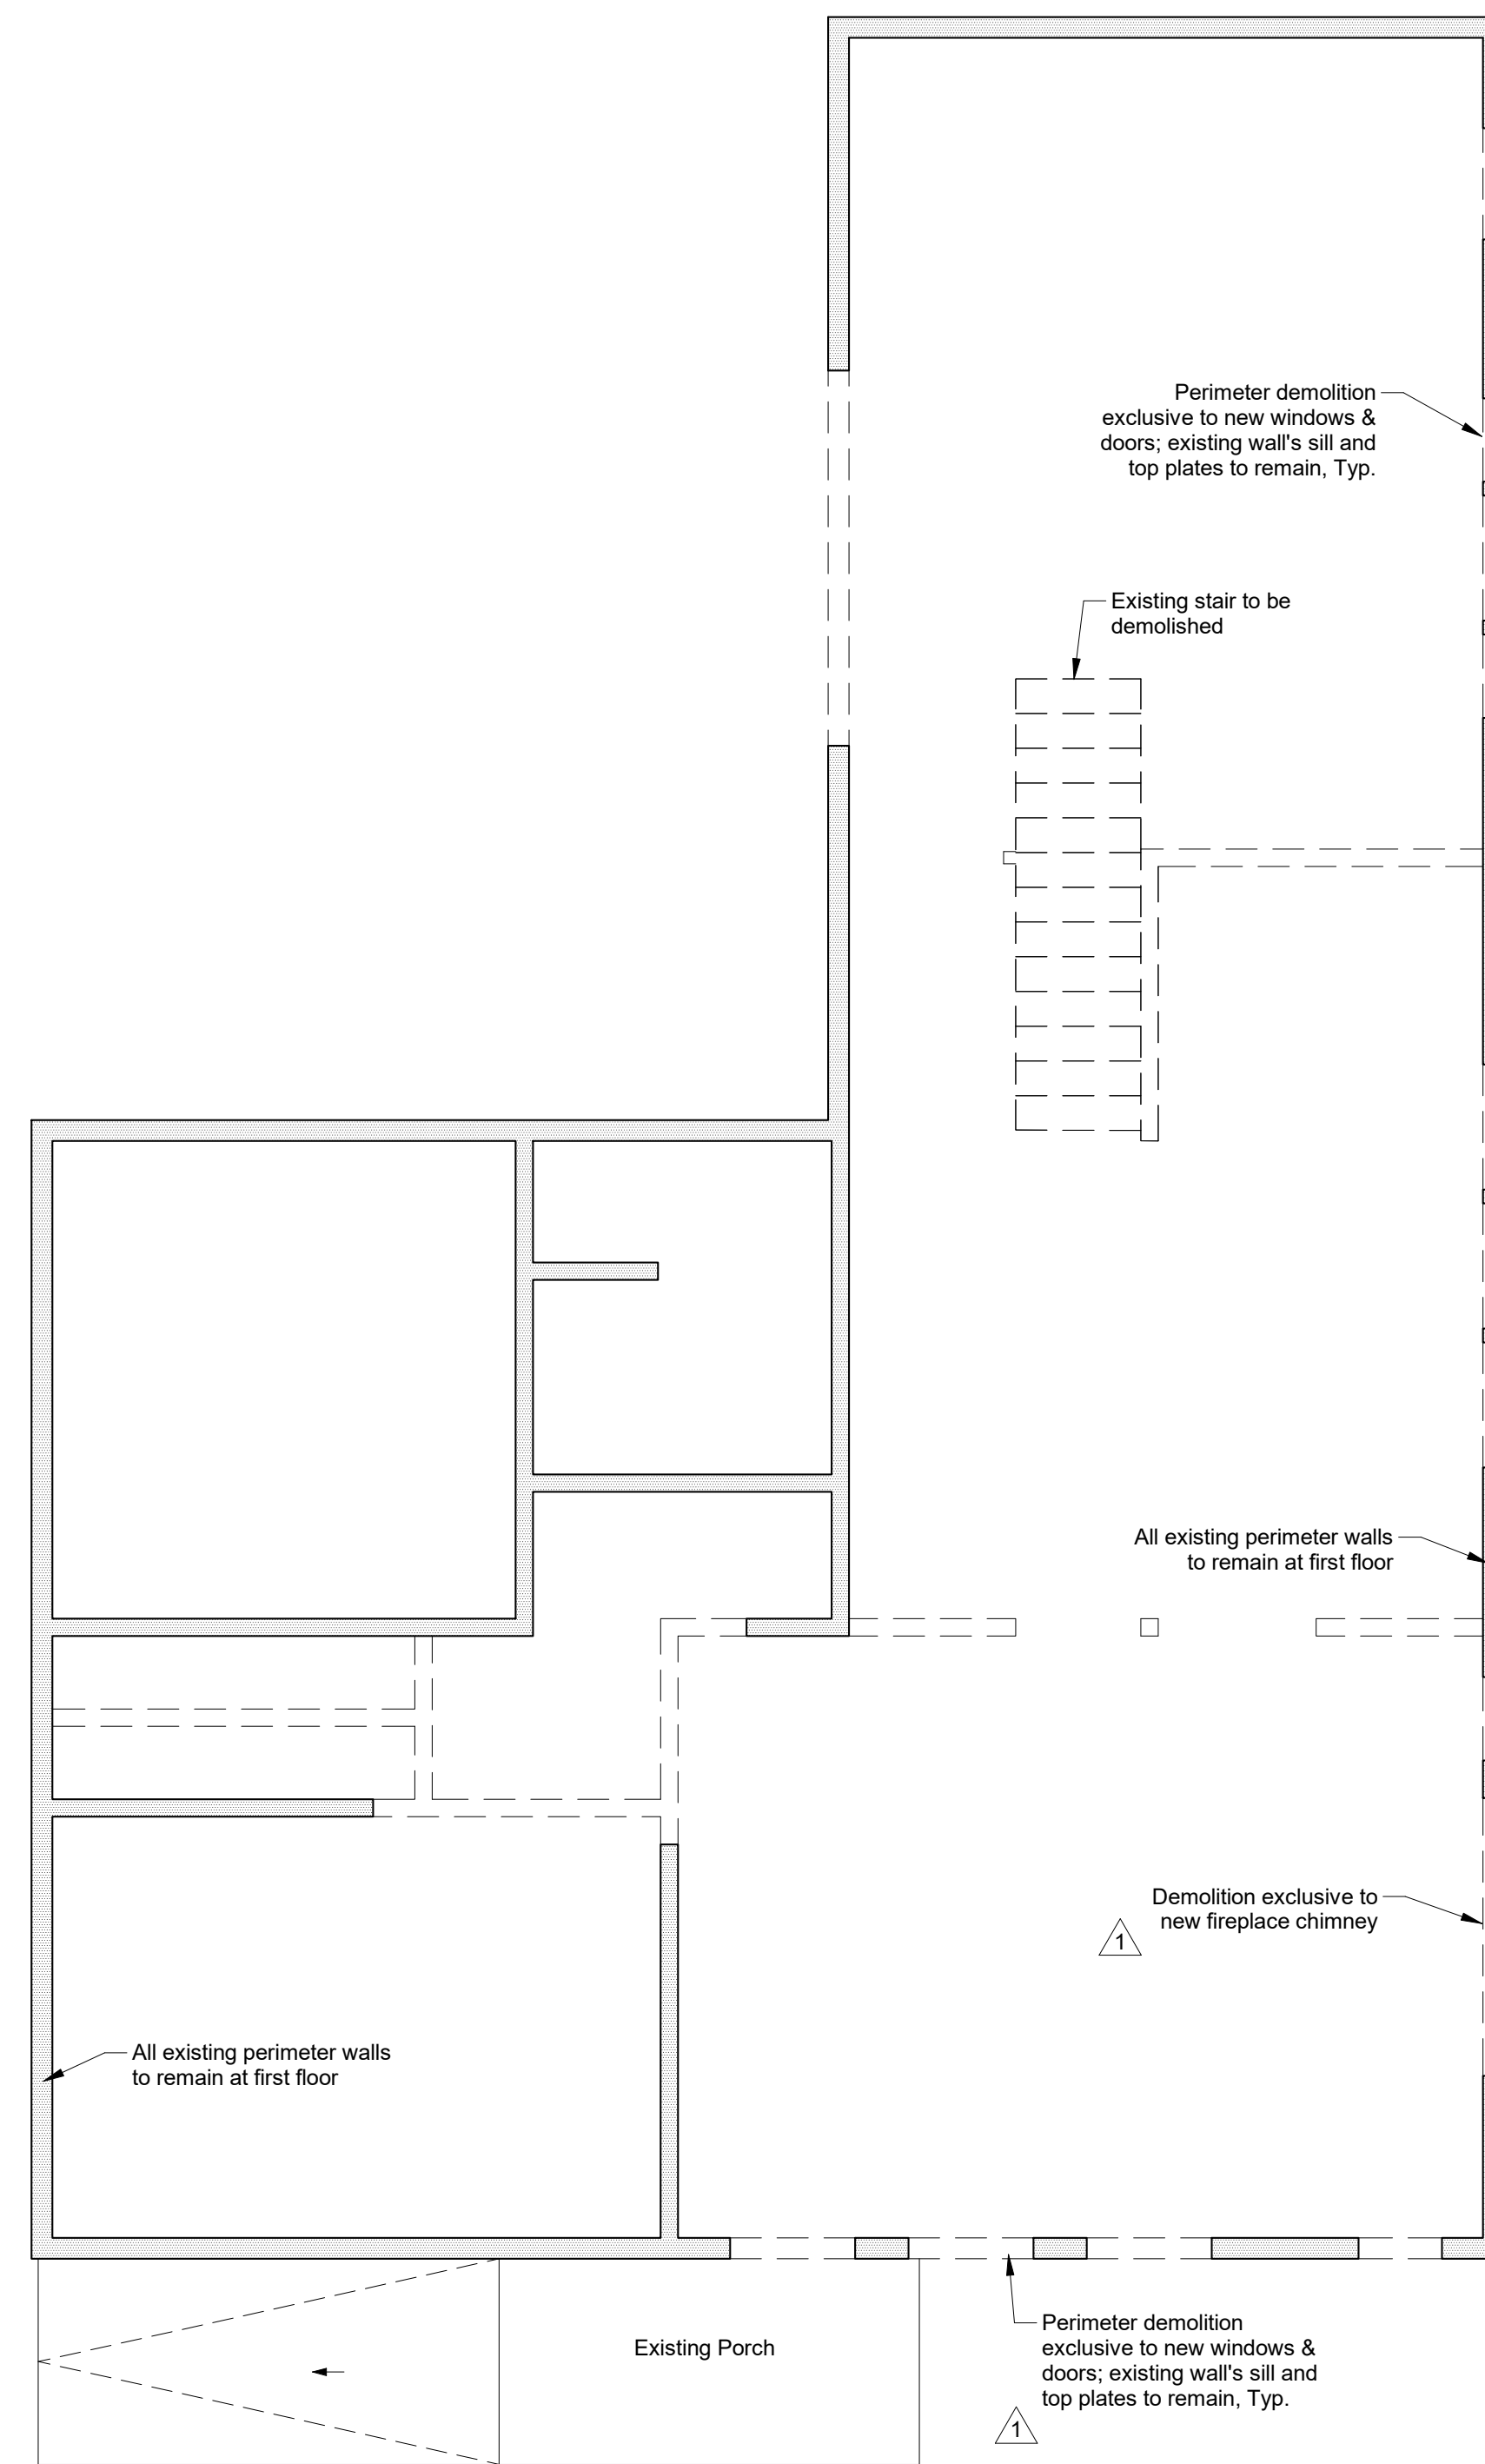


2 Demolition Plan - First Floor  
1/4" = 1'-0"

### Legend

- Existing to remain
- Demolished

1 First Floor Plan  
1/4" = 1'-0"

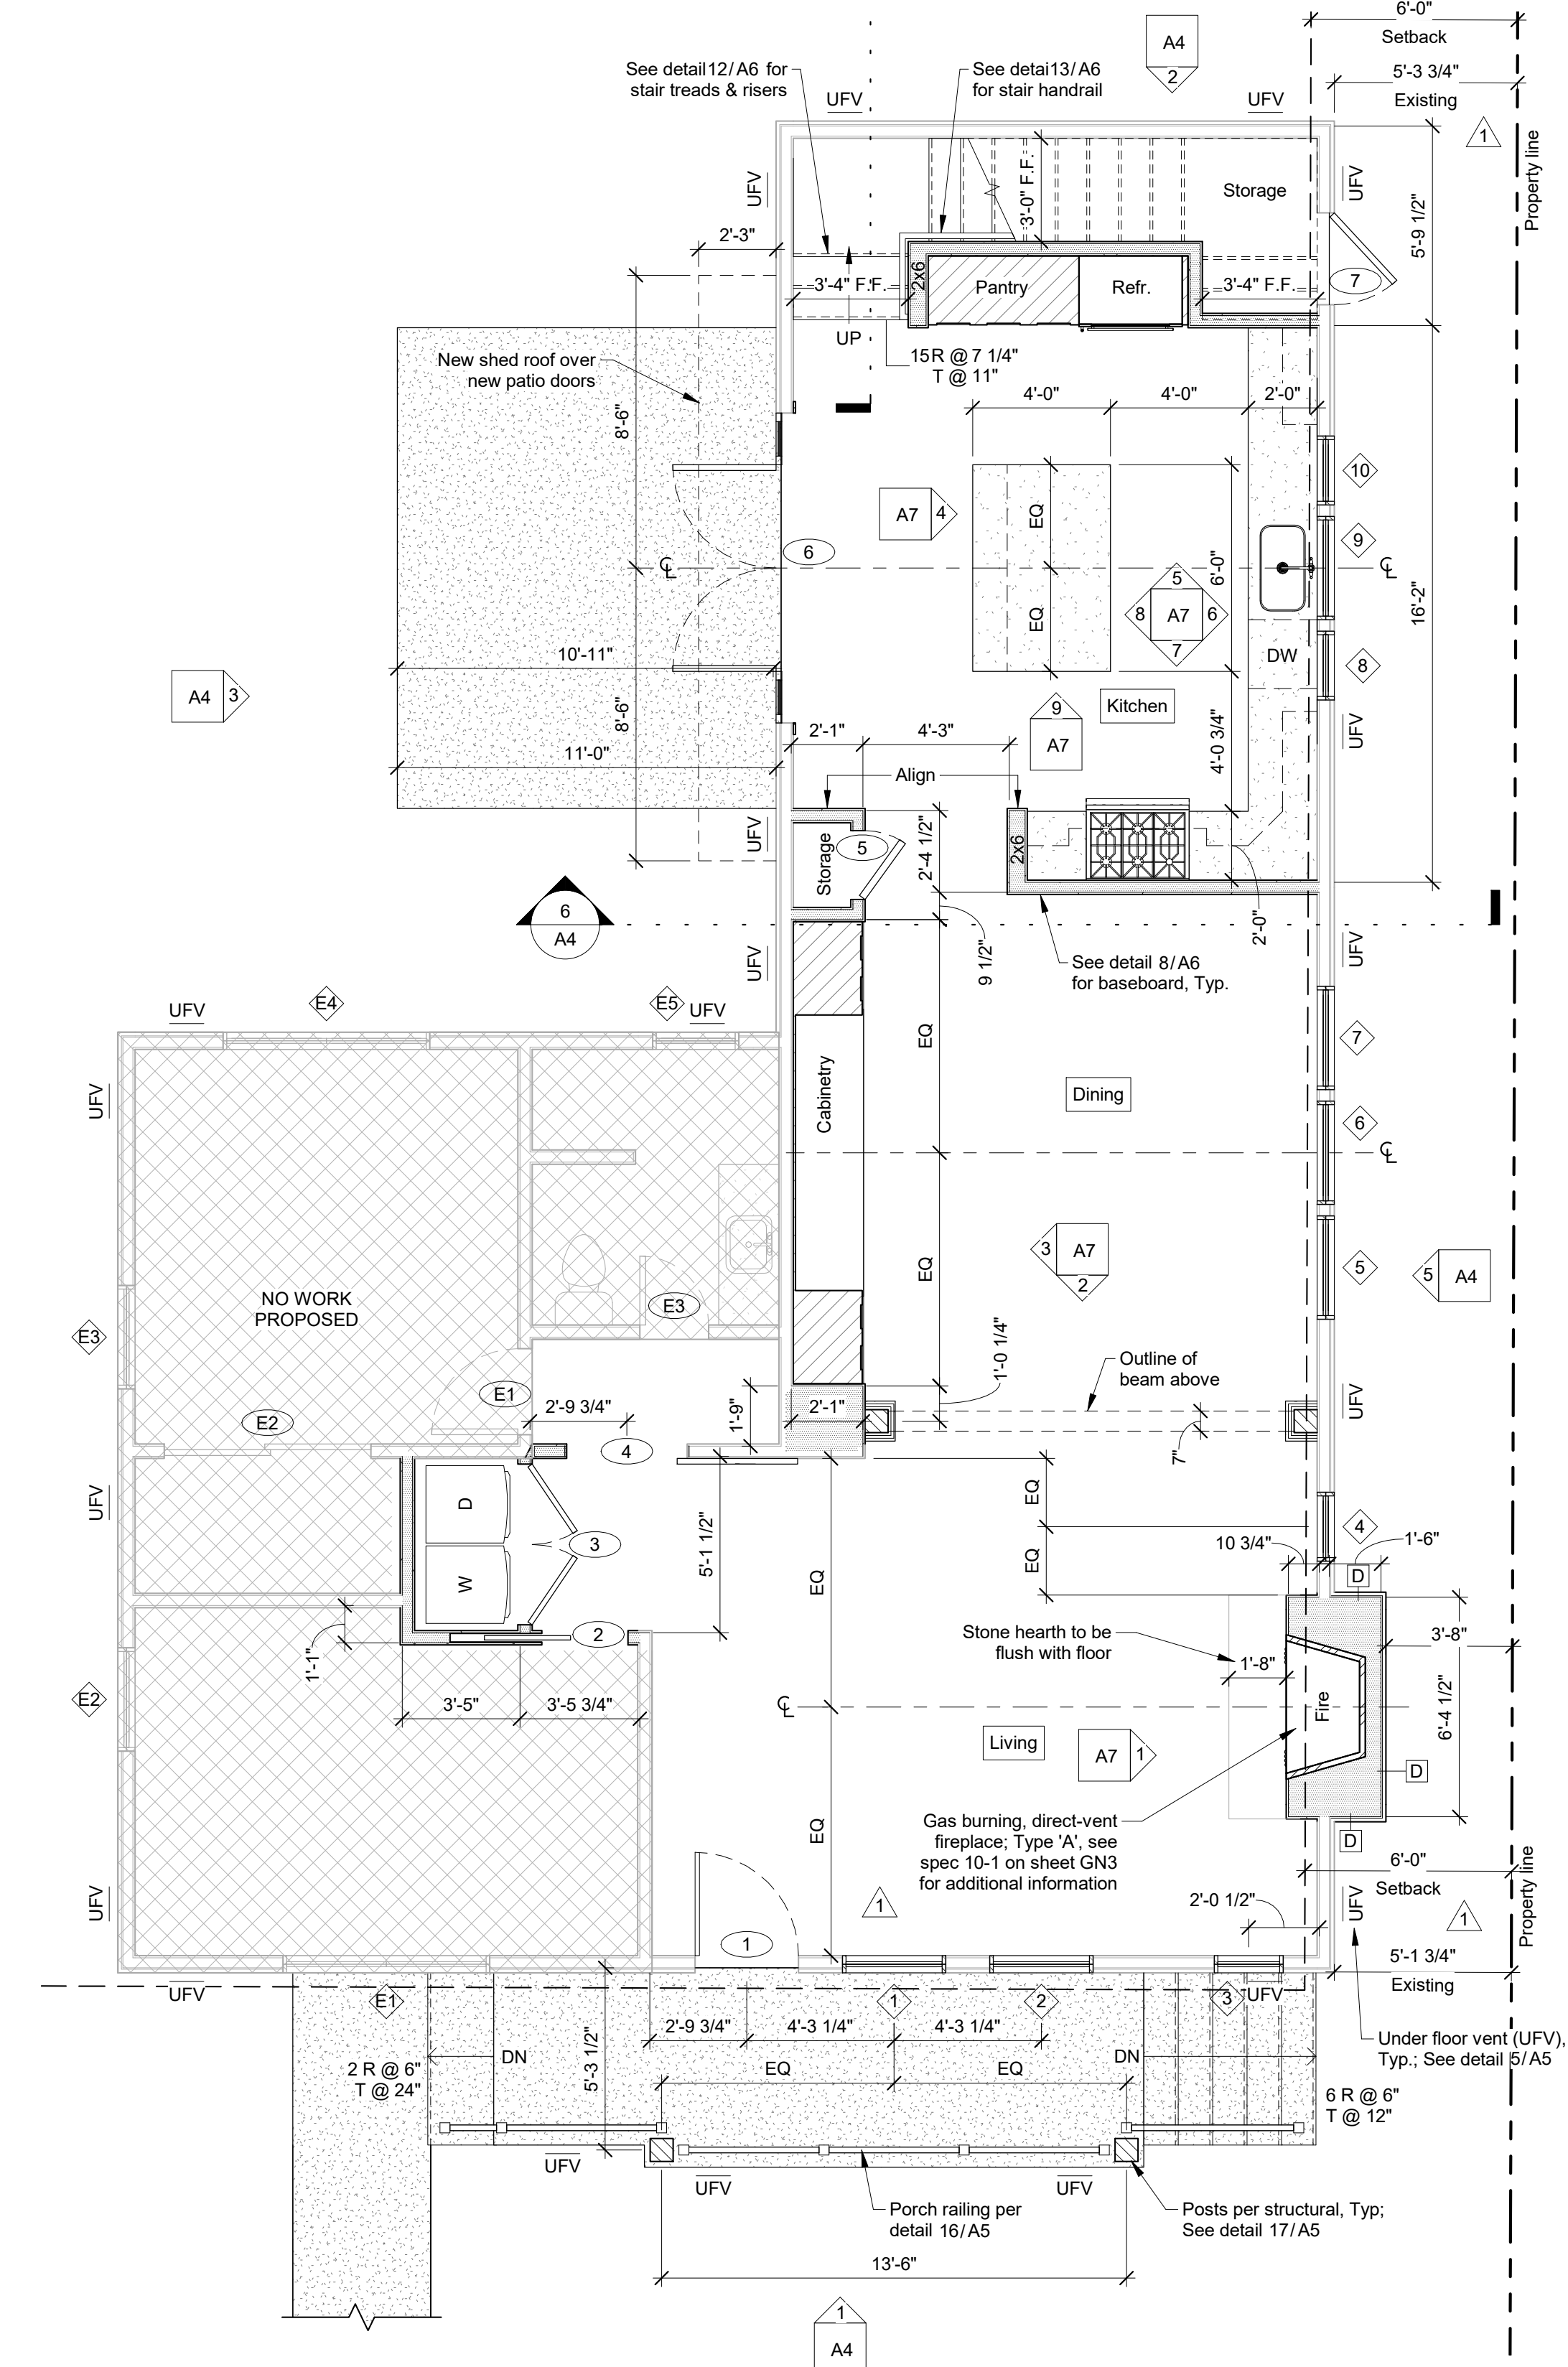

### General Plan Notes

- All plan dimensions given are to face of stud or masonry, U.N.O.
- All interior walls are Type 'B' U.N.O., refer to structural drawings for framing information.
- Contractor is to install MDF closet shelves and stainless steel clothing rods in each closet prior to completion of construction, unless directed by owner otherwise
- See finish schedule on A2 for floor material at all locations
- See window schedule on A2 for windows with tempered safety glazing
- All glass shower enclosures are to be tempered safety glass

### Wall Types

- See detail 1/A5
- See detail 2/A5
- See detail 2/A5
- See detail 16/A6

**NICODEMUS DESIGN**  
8861 Villa La Jolla Dr.,  
P.O. Box # 13367,  
La Jolla, CA 92037  
Phone: (760) 473-1041

DESIGNER:

Drawn By:  
NN

Drawing Date:  
October 10, 2023

Revisions:

revision	date	notes
1	12/13/23	Plan Check
3	05/04/24	Plan Check

Evans Remodel  
412 Flora Vista, Santa Barbara, CA

First Floor Plan

A2


PROJECT:

SHEET TITLE:  
DRAWING NUMBER:




Revisions:

revision	date	notes
1	12/13/23	Plan Check

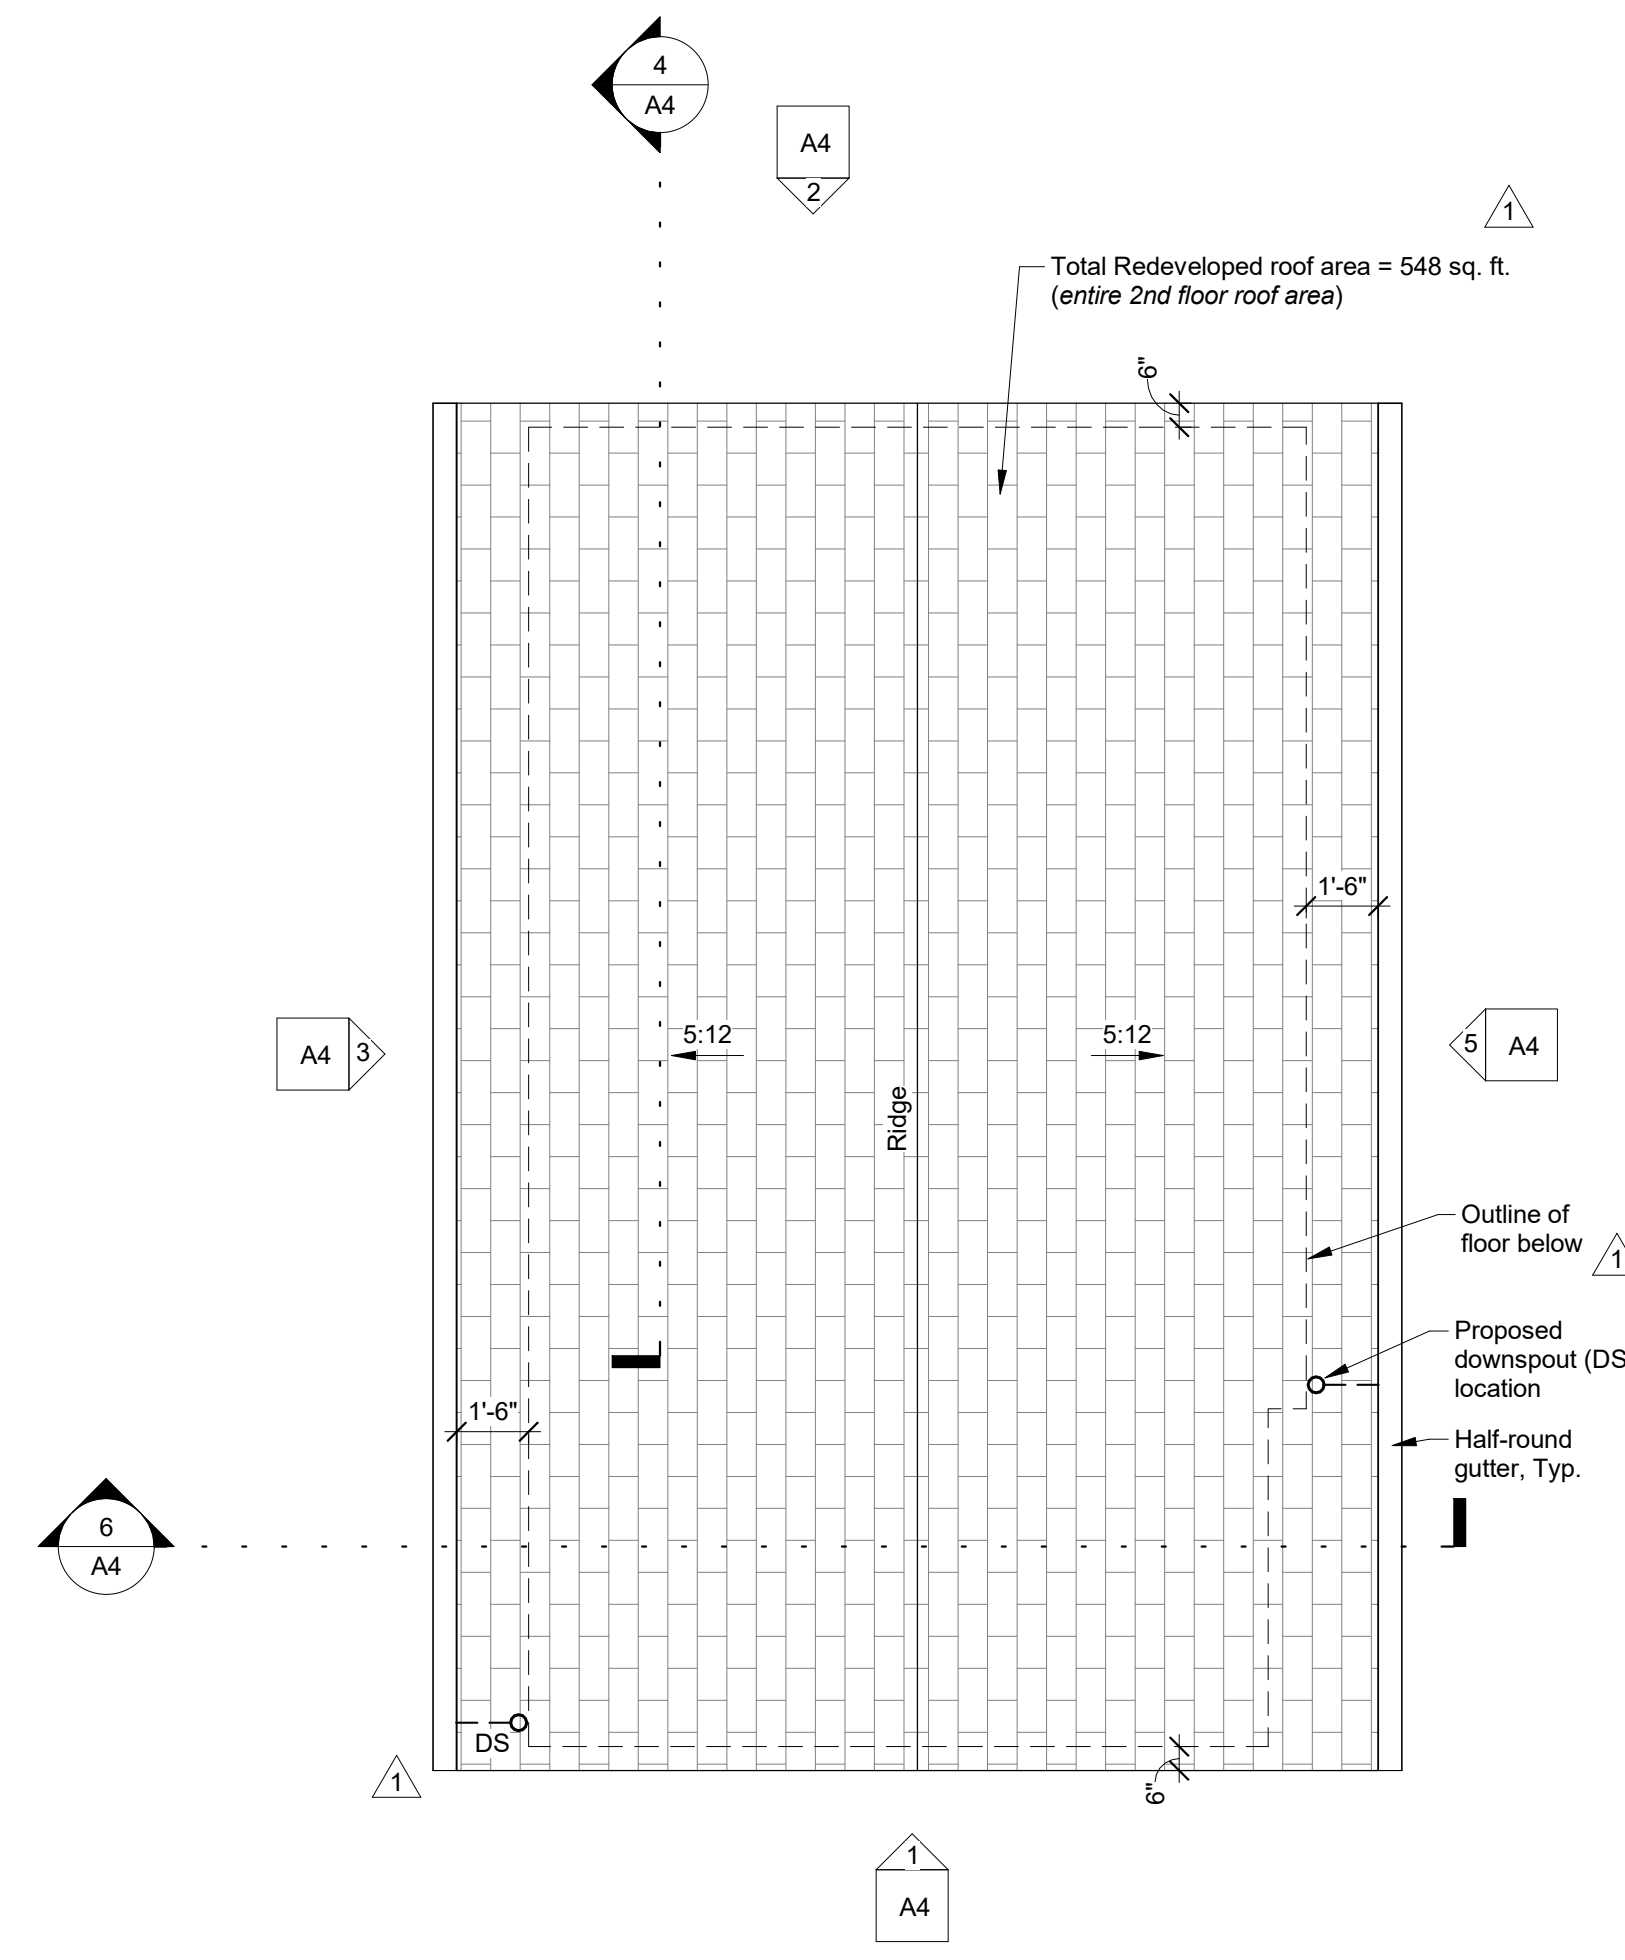


**4 Roof Plan**  
 1/4" = 1'-0"

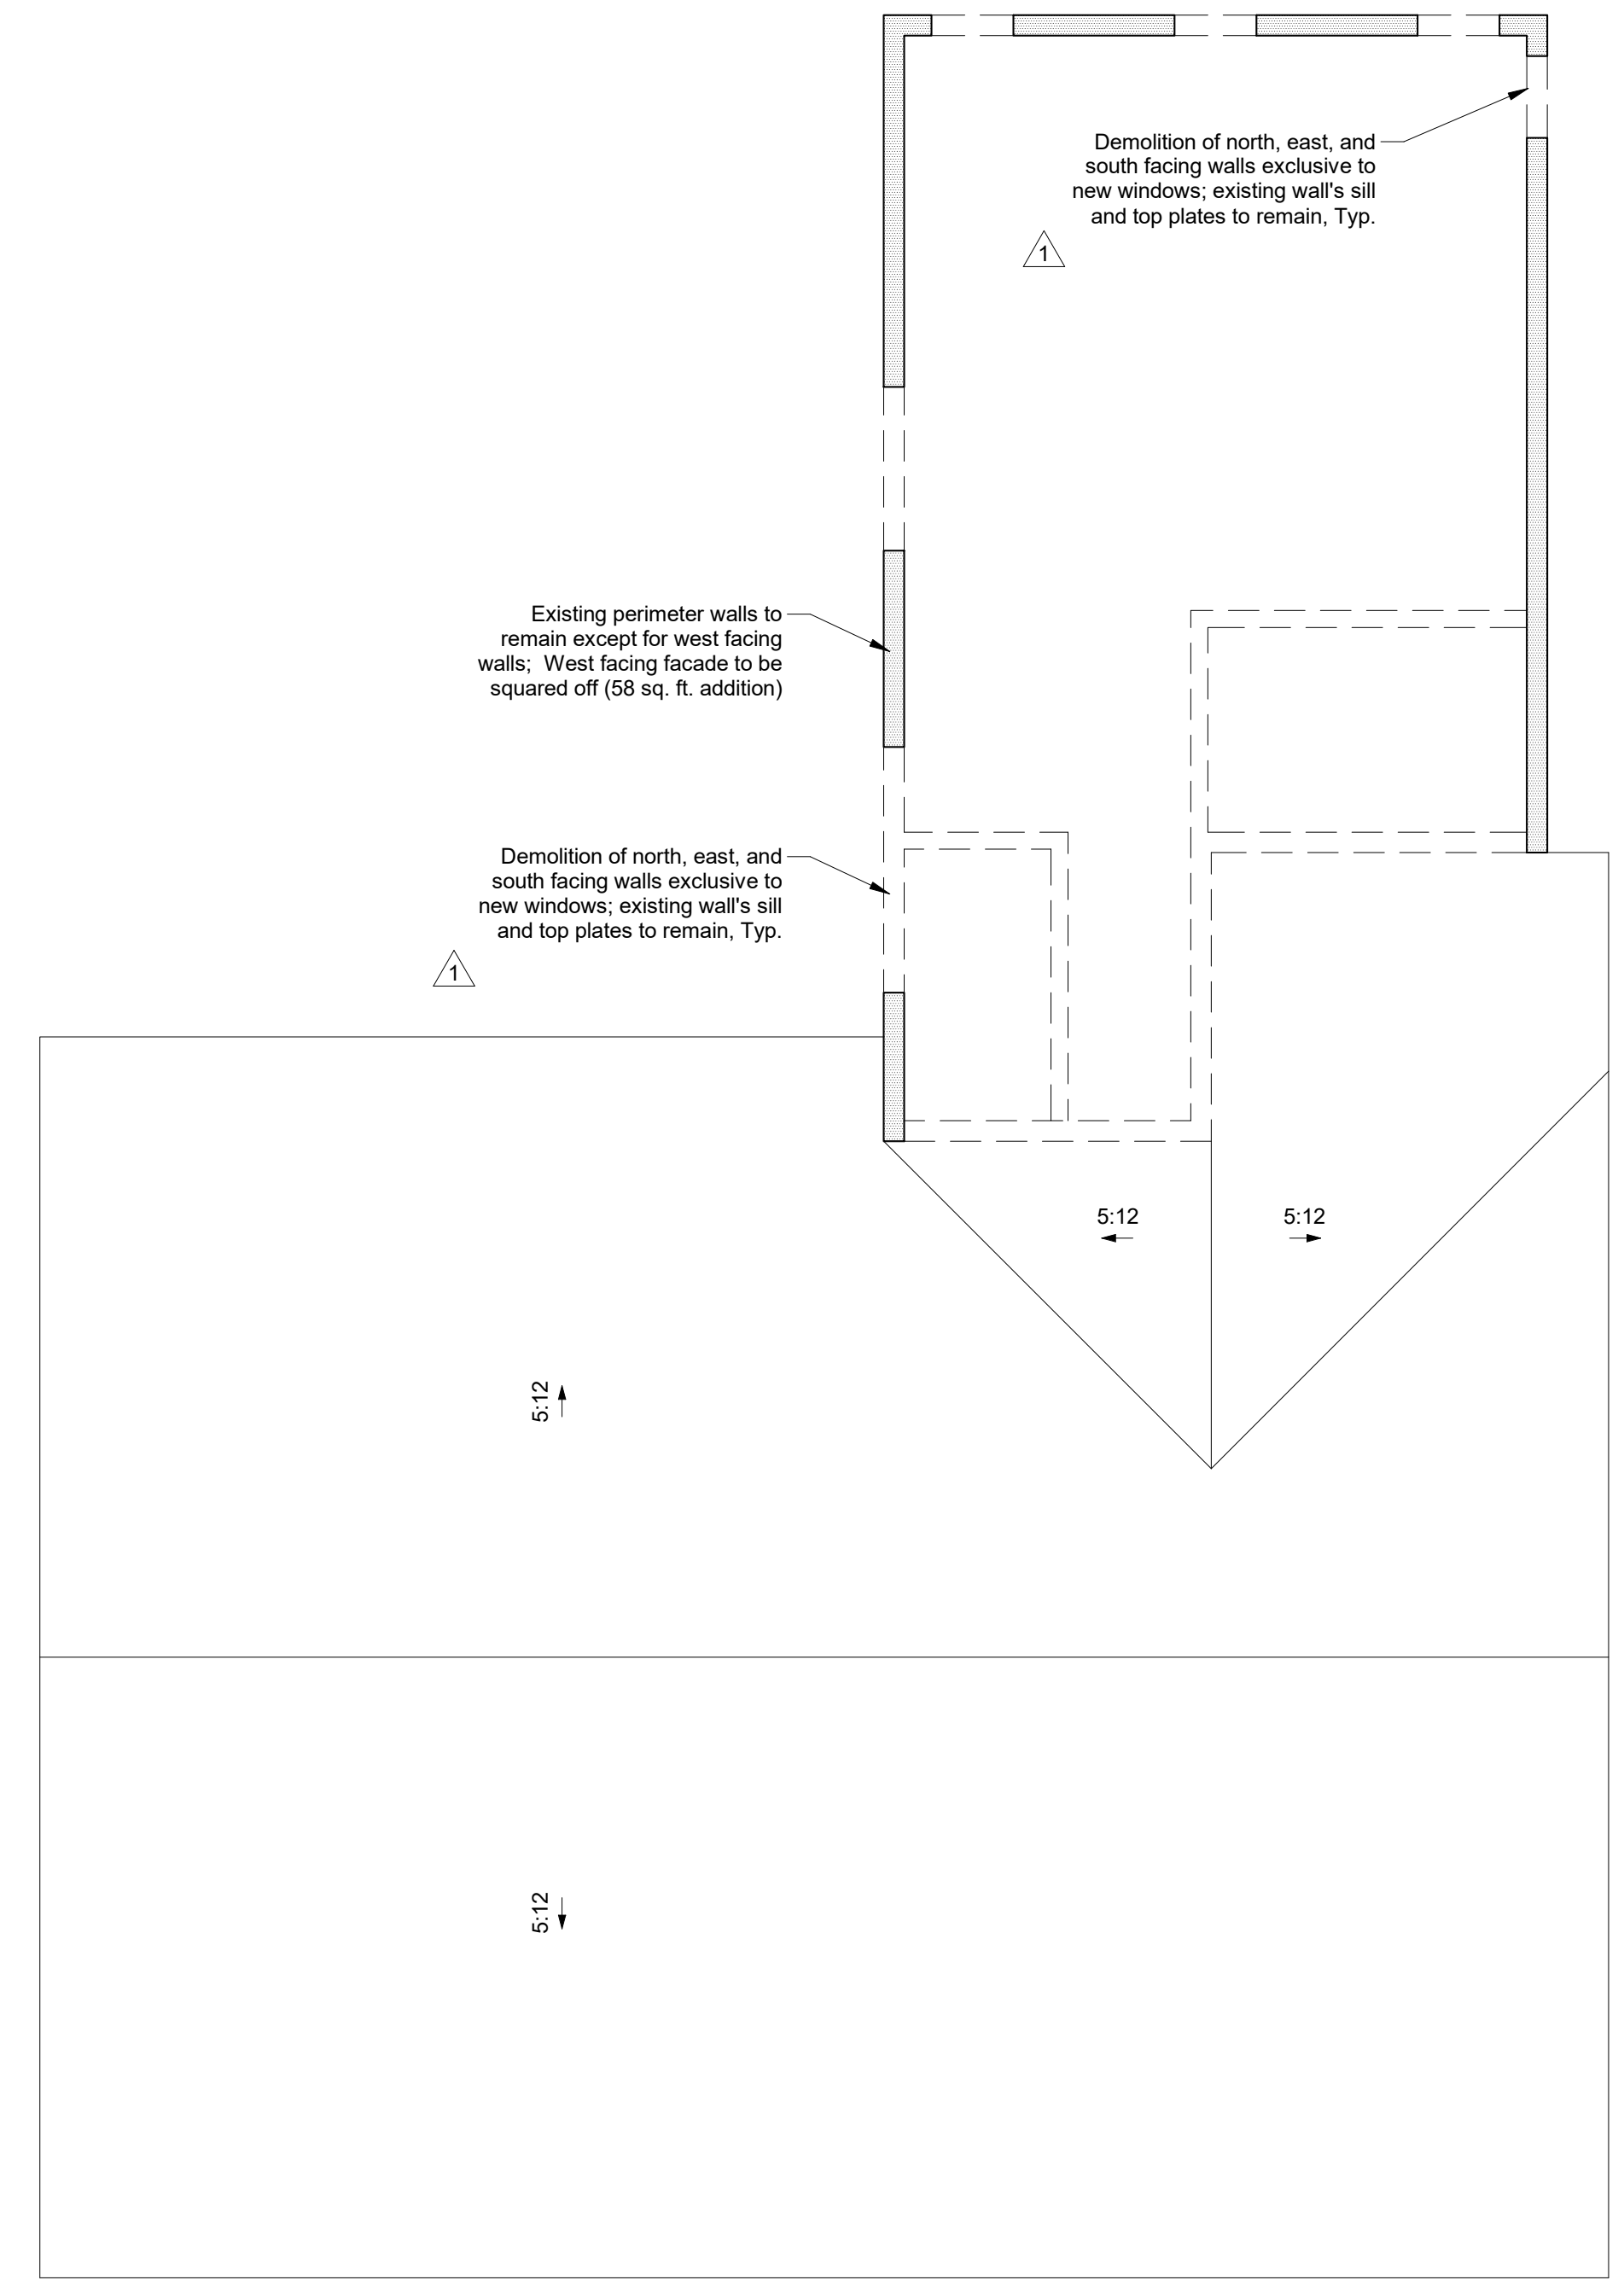

**2 Demolition Plan - Second Floor**  
 1/4" = 1'-0"

**Legend**

	Existing to remain
	Demolished

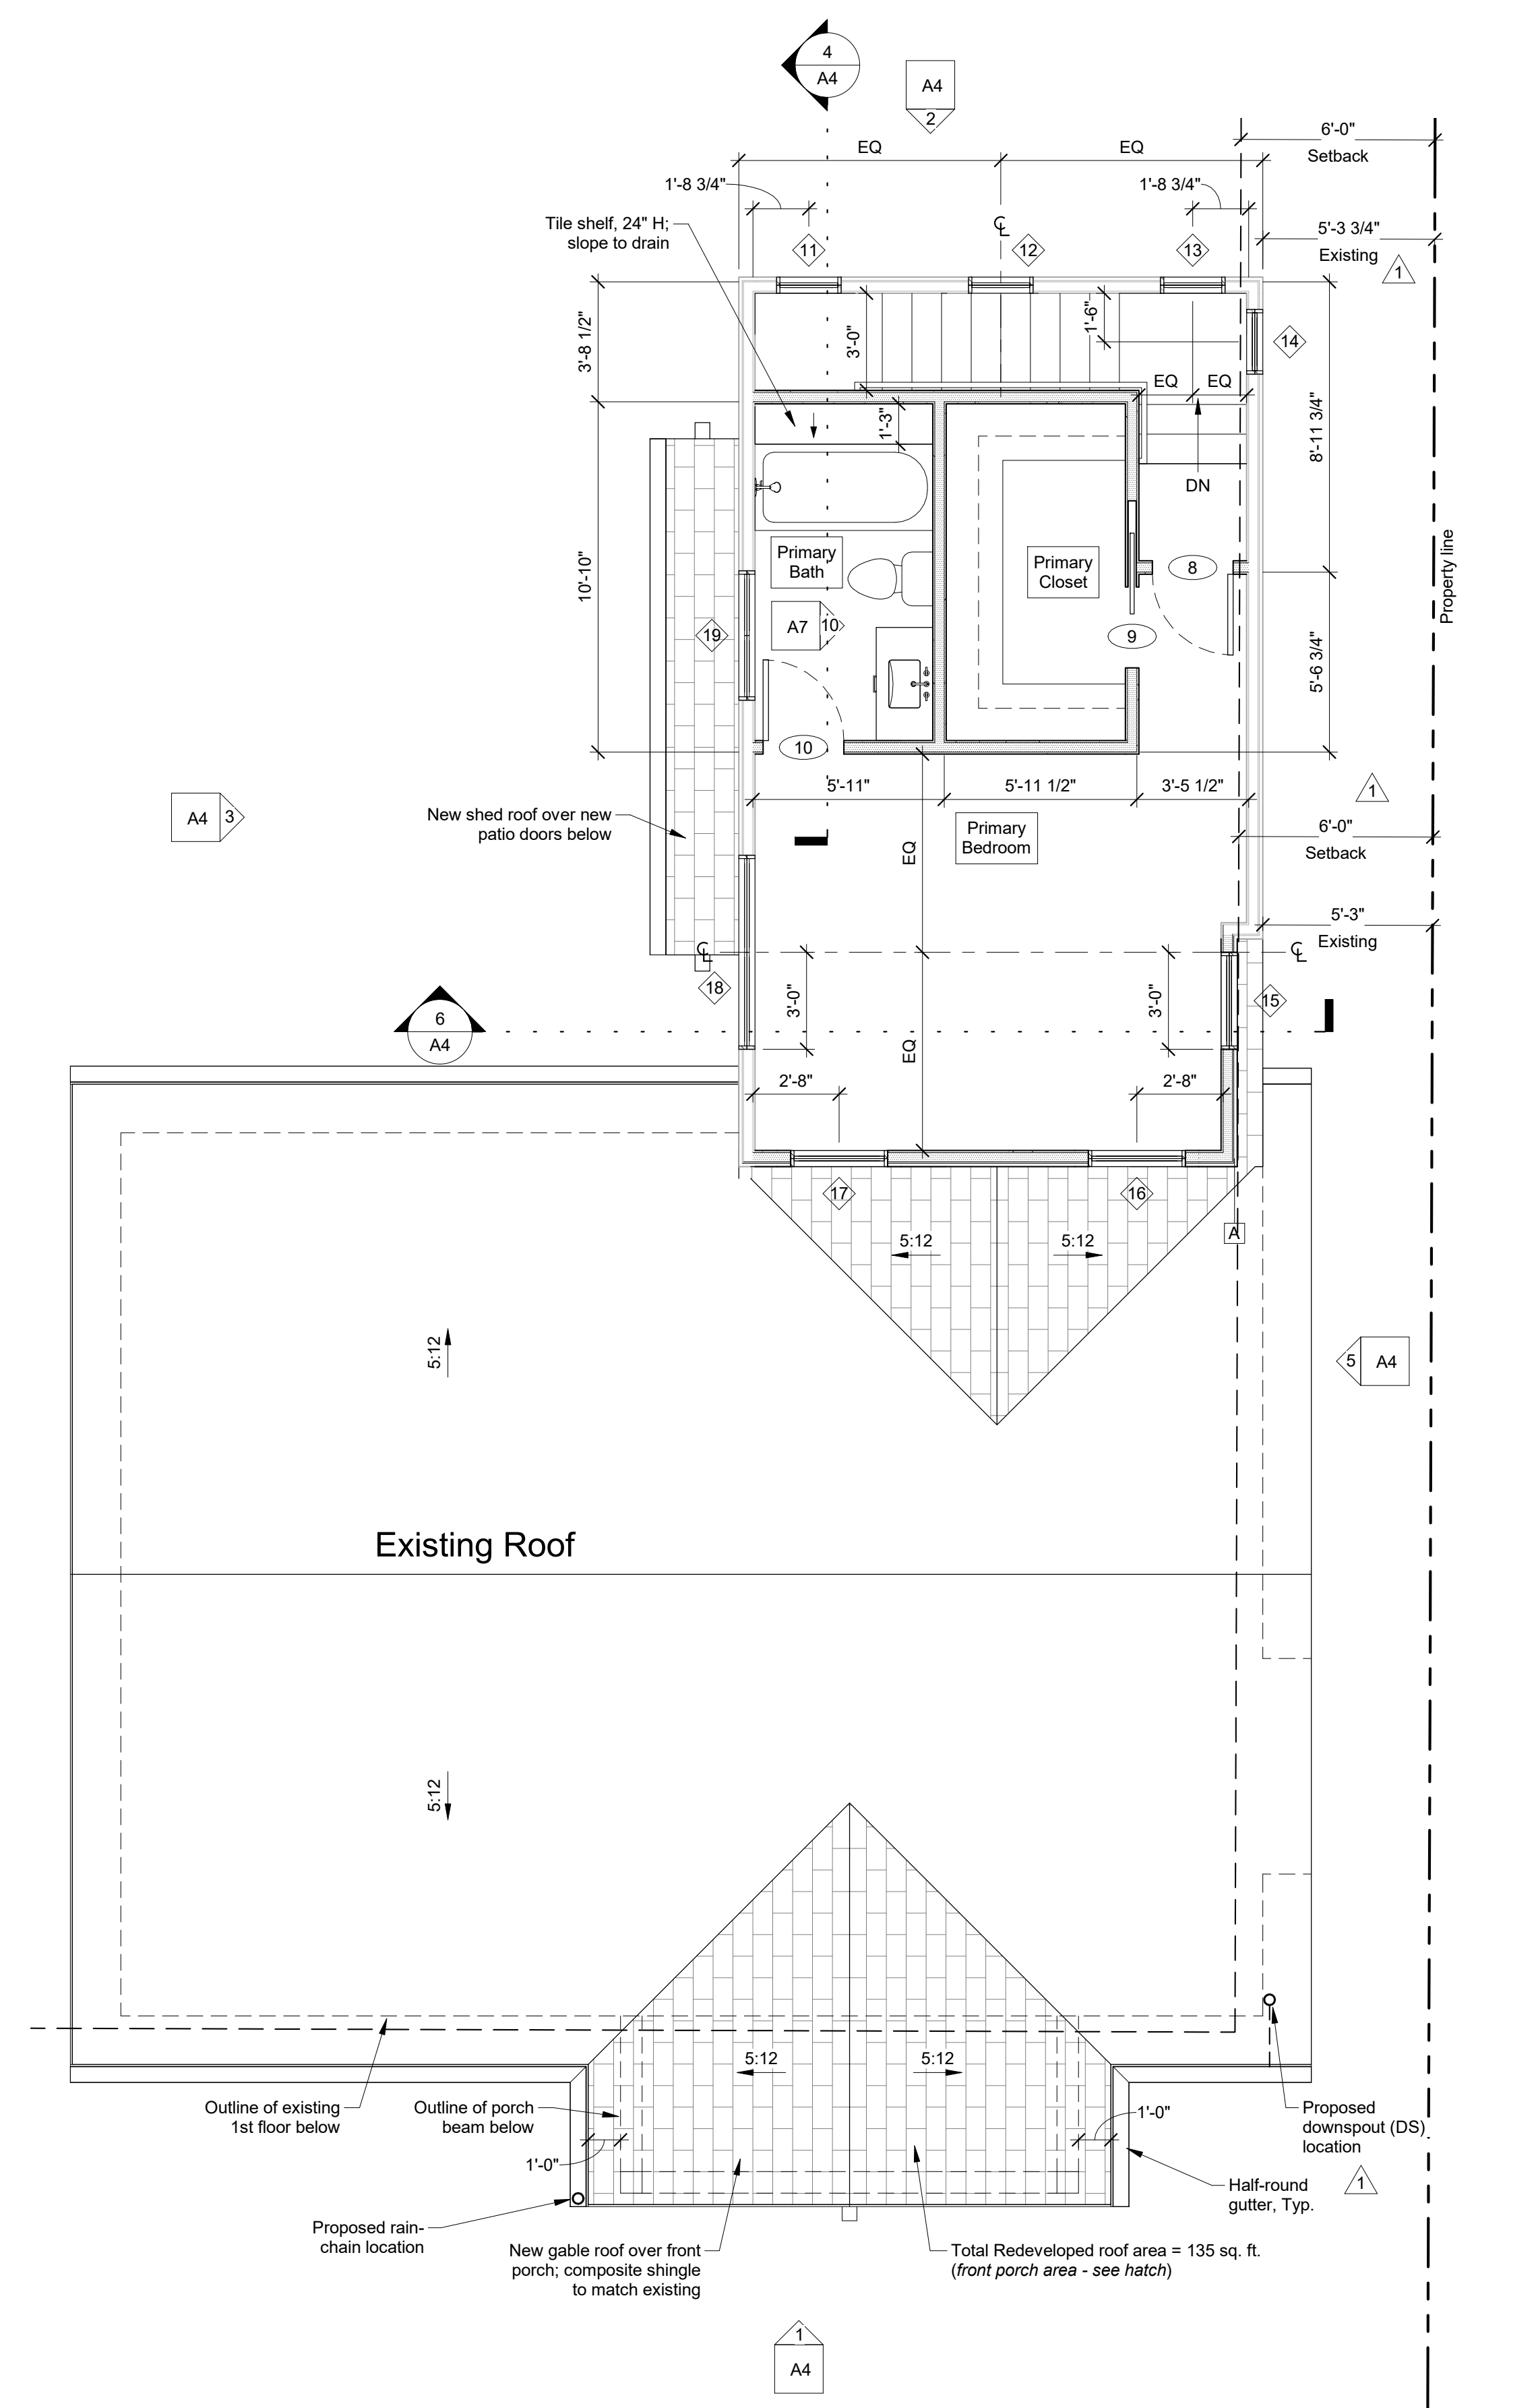


**1 Second Floor Plan**  
 1/4" = 1'-0"




Revisions:


revision	date	notes
1	12/13/23	Plan Check
3	05/04/24	Plan Check

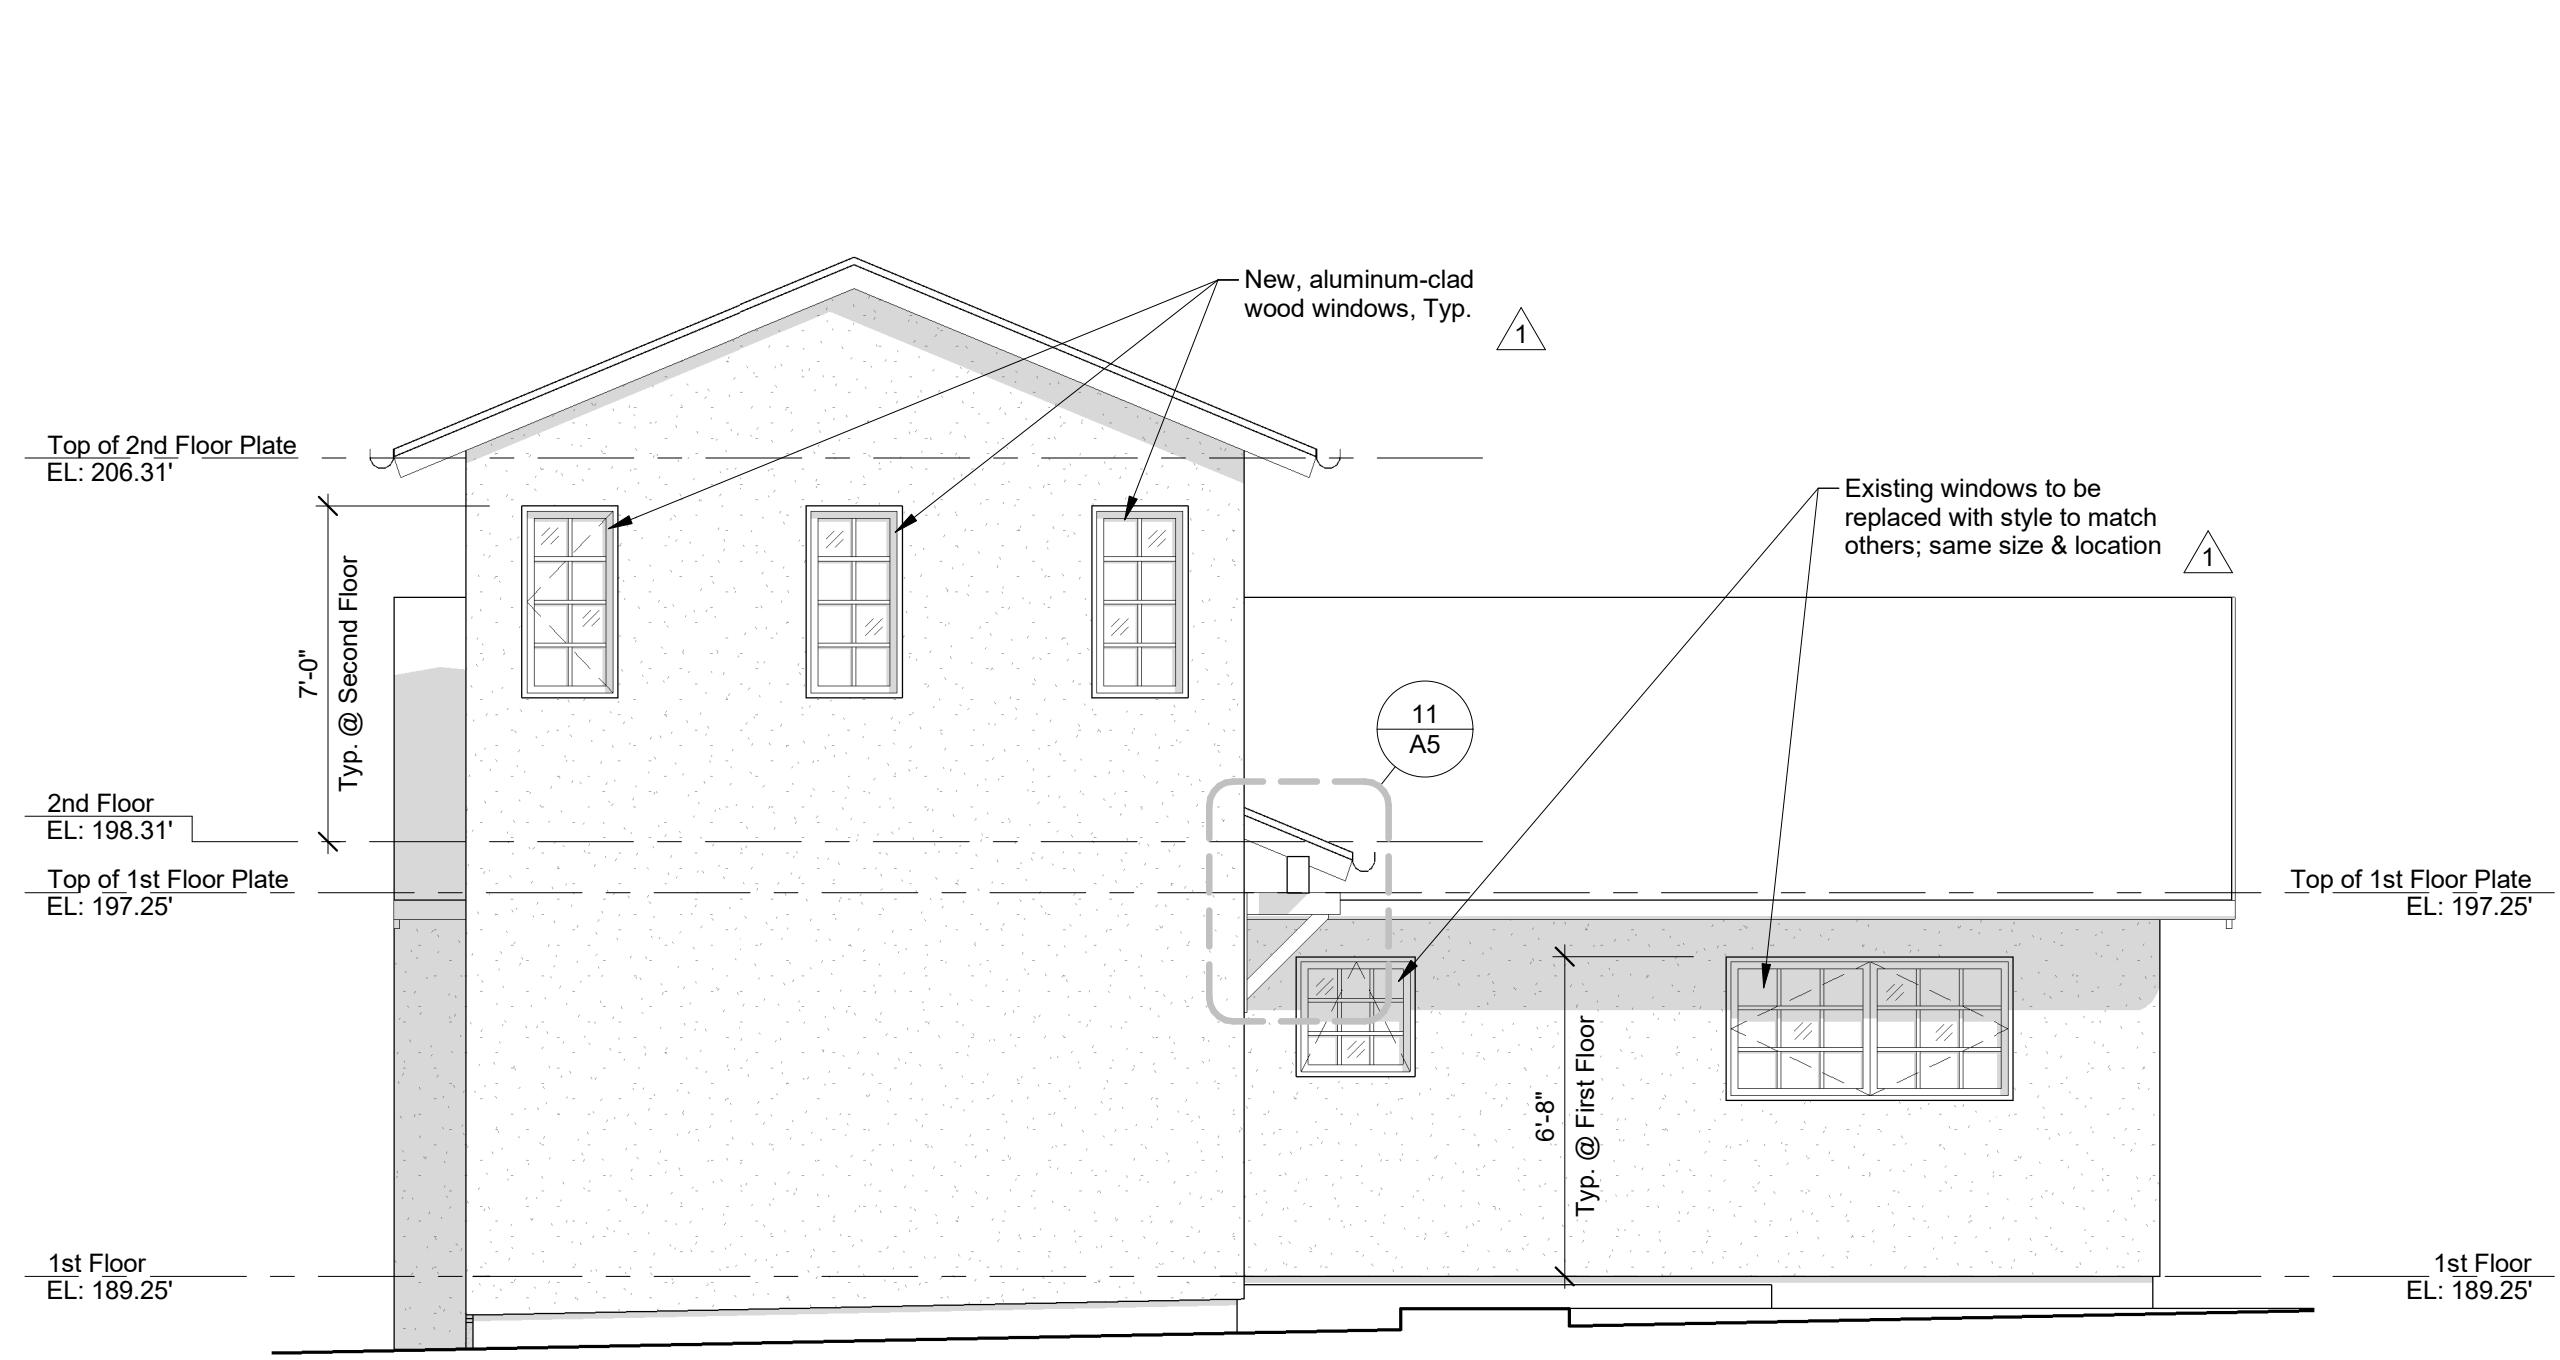


**2** Elevation - Rear (East)  
 1/4" = 1'-0"

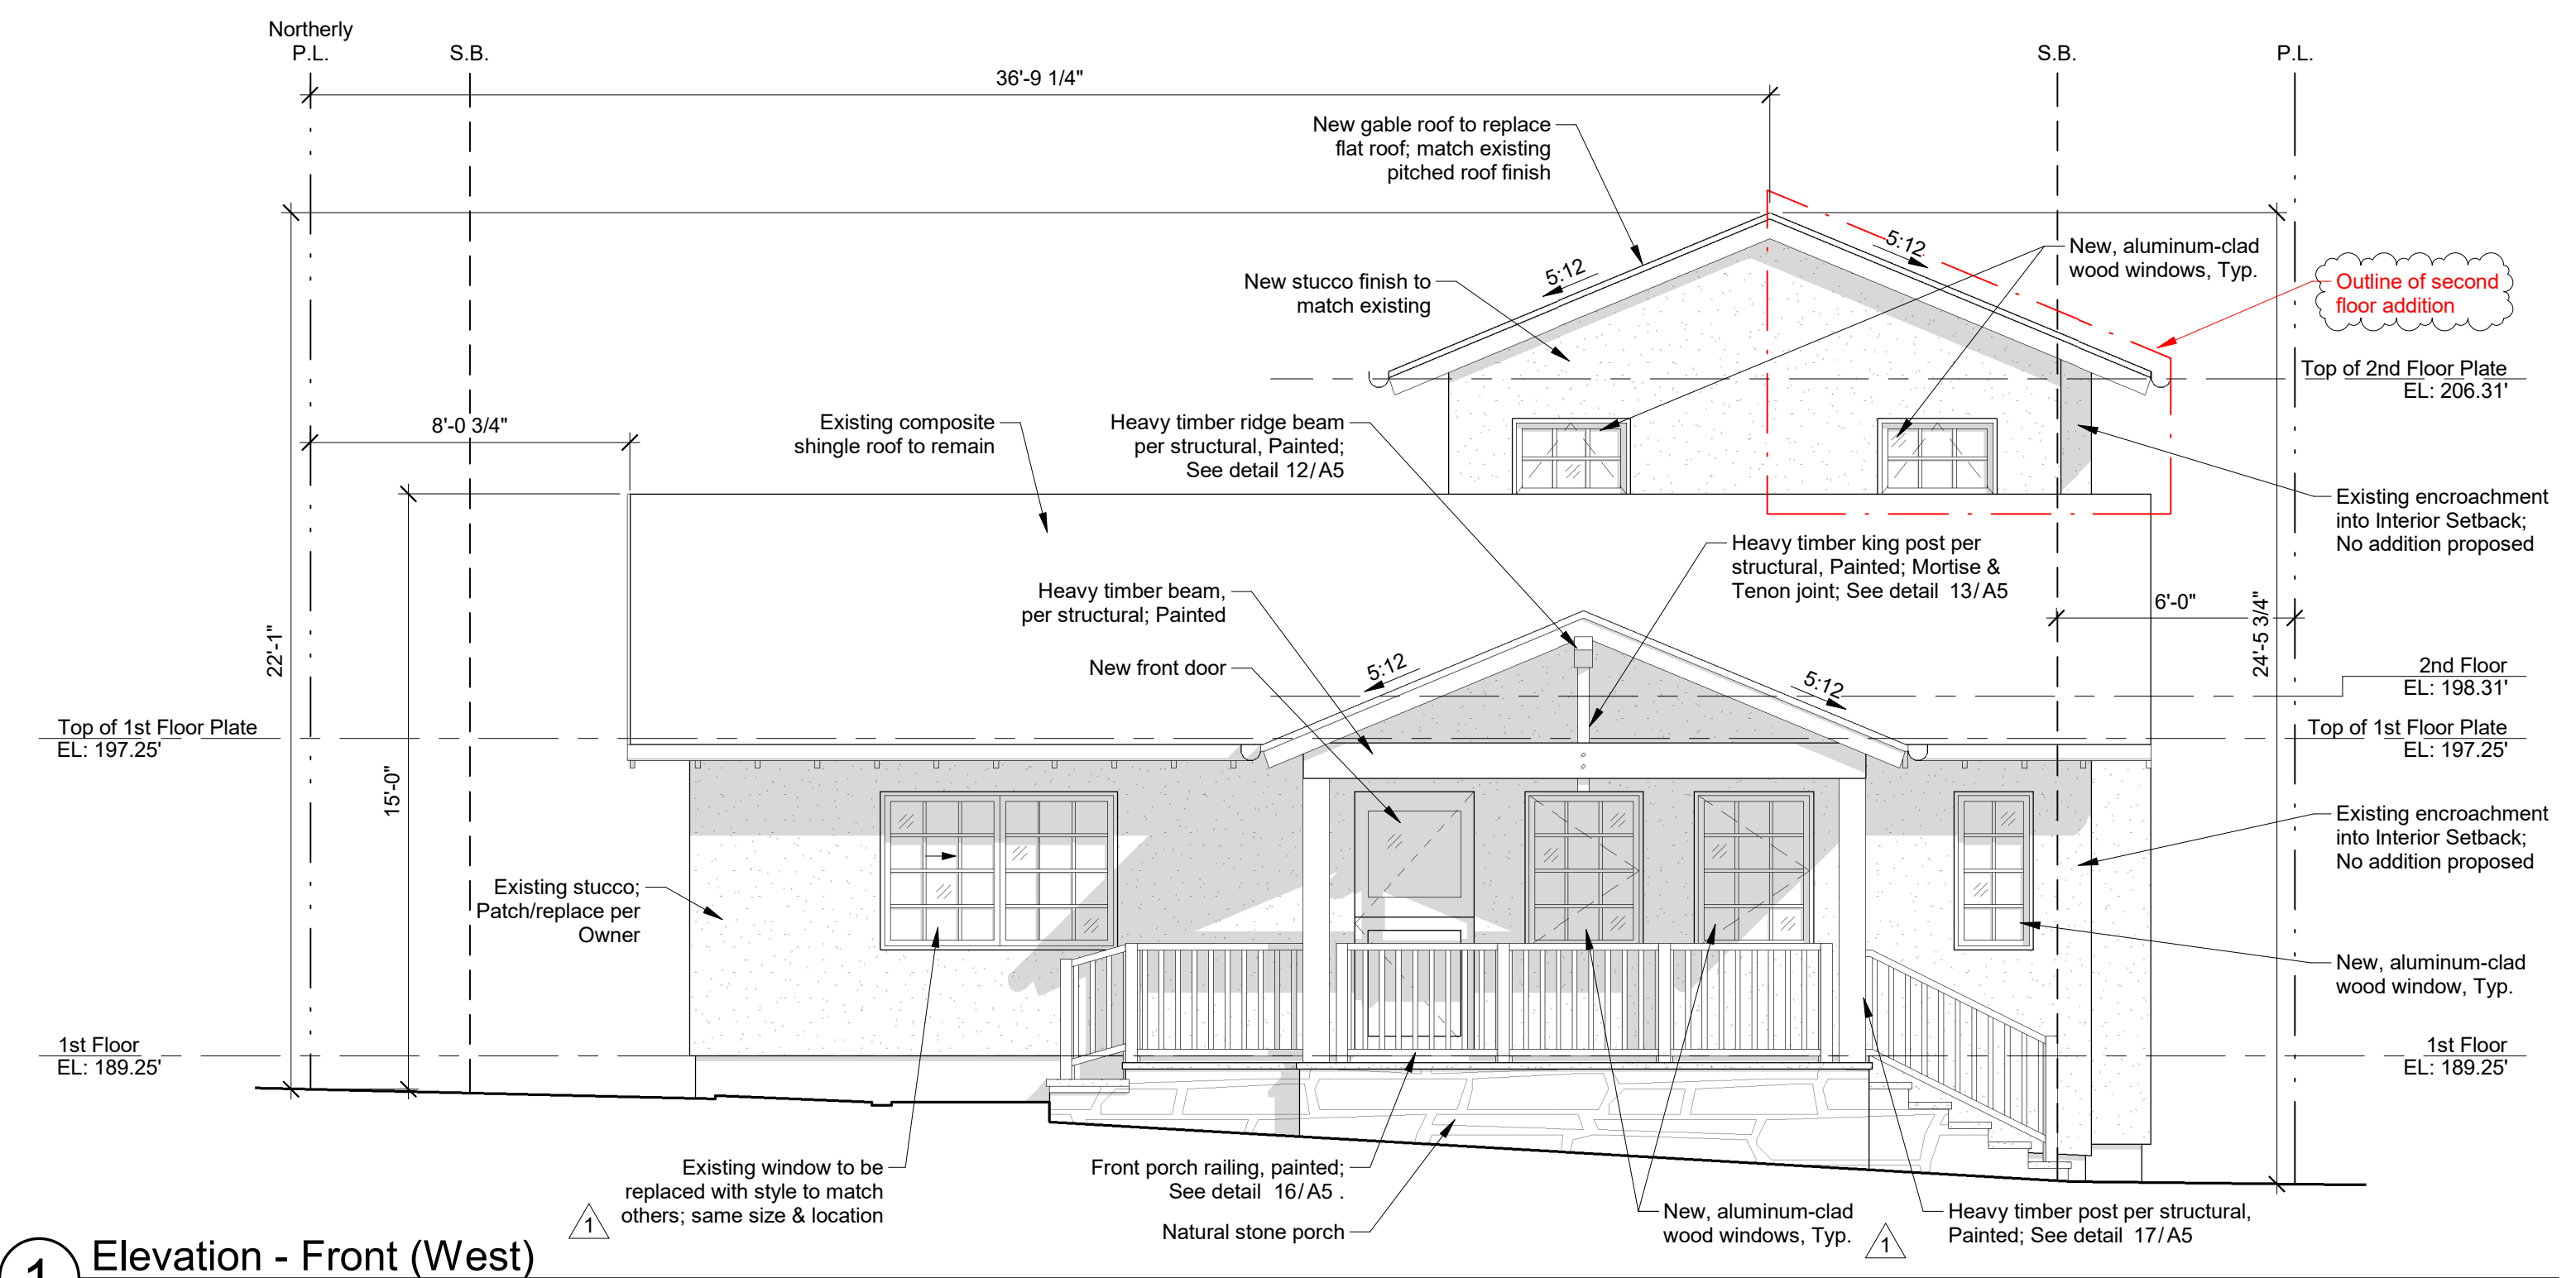


**1** Elevation - Front (West)  
 1/4" = 1'-0"

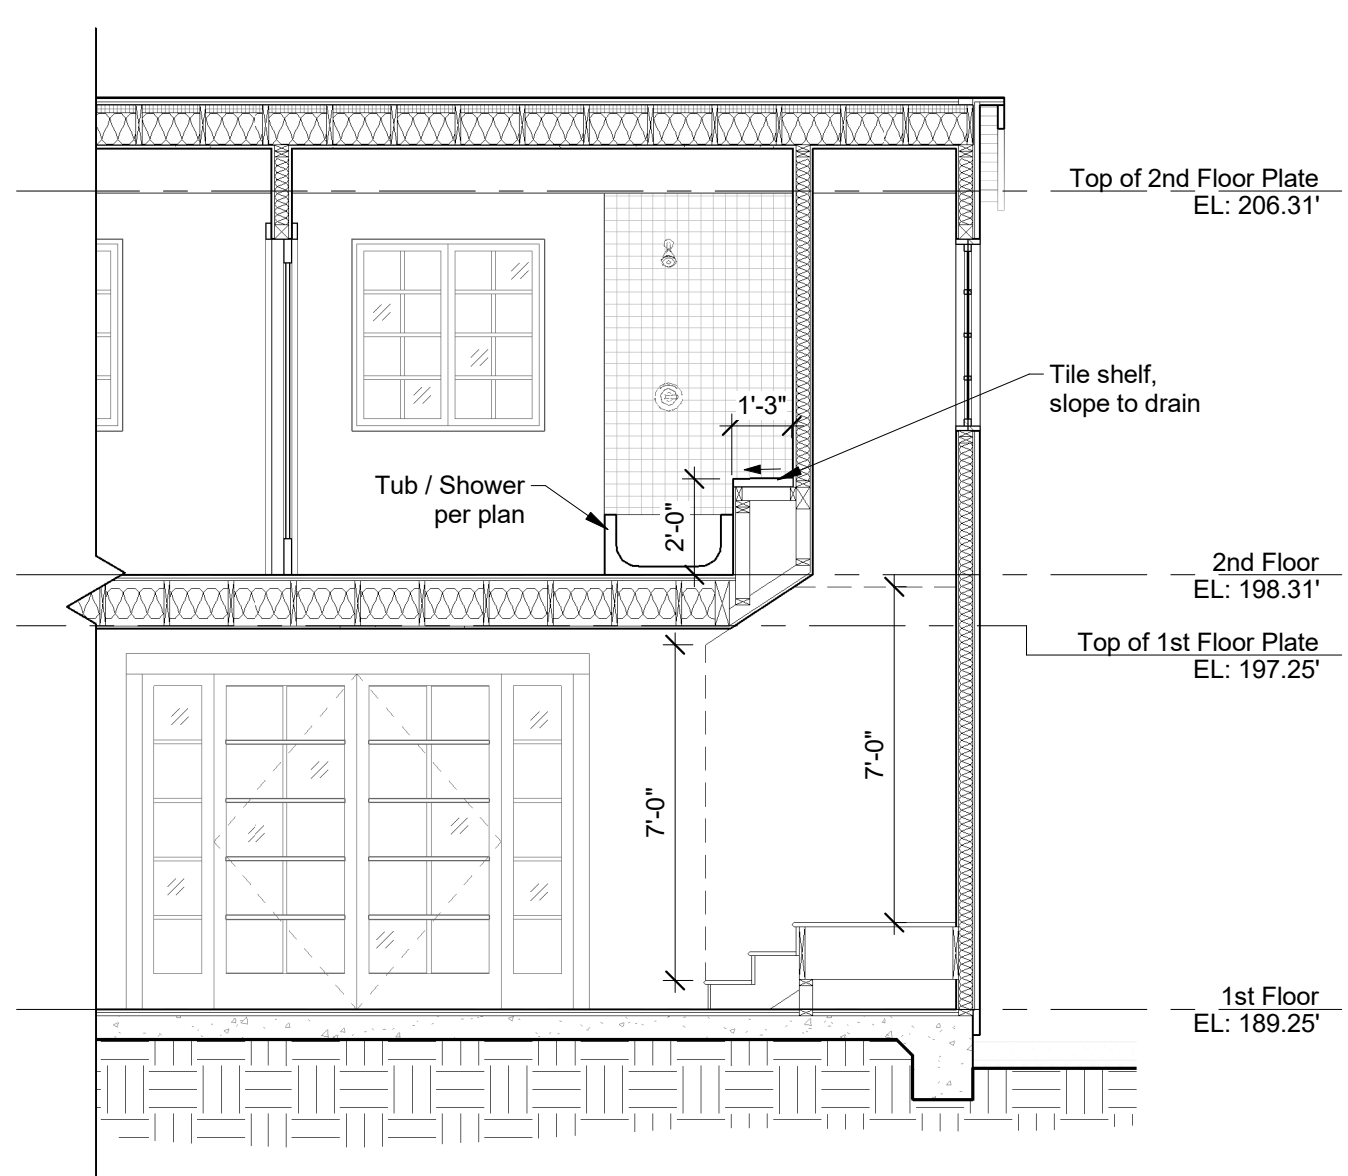


**4** Building Section  
 1/4" = 1'-0"

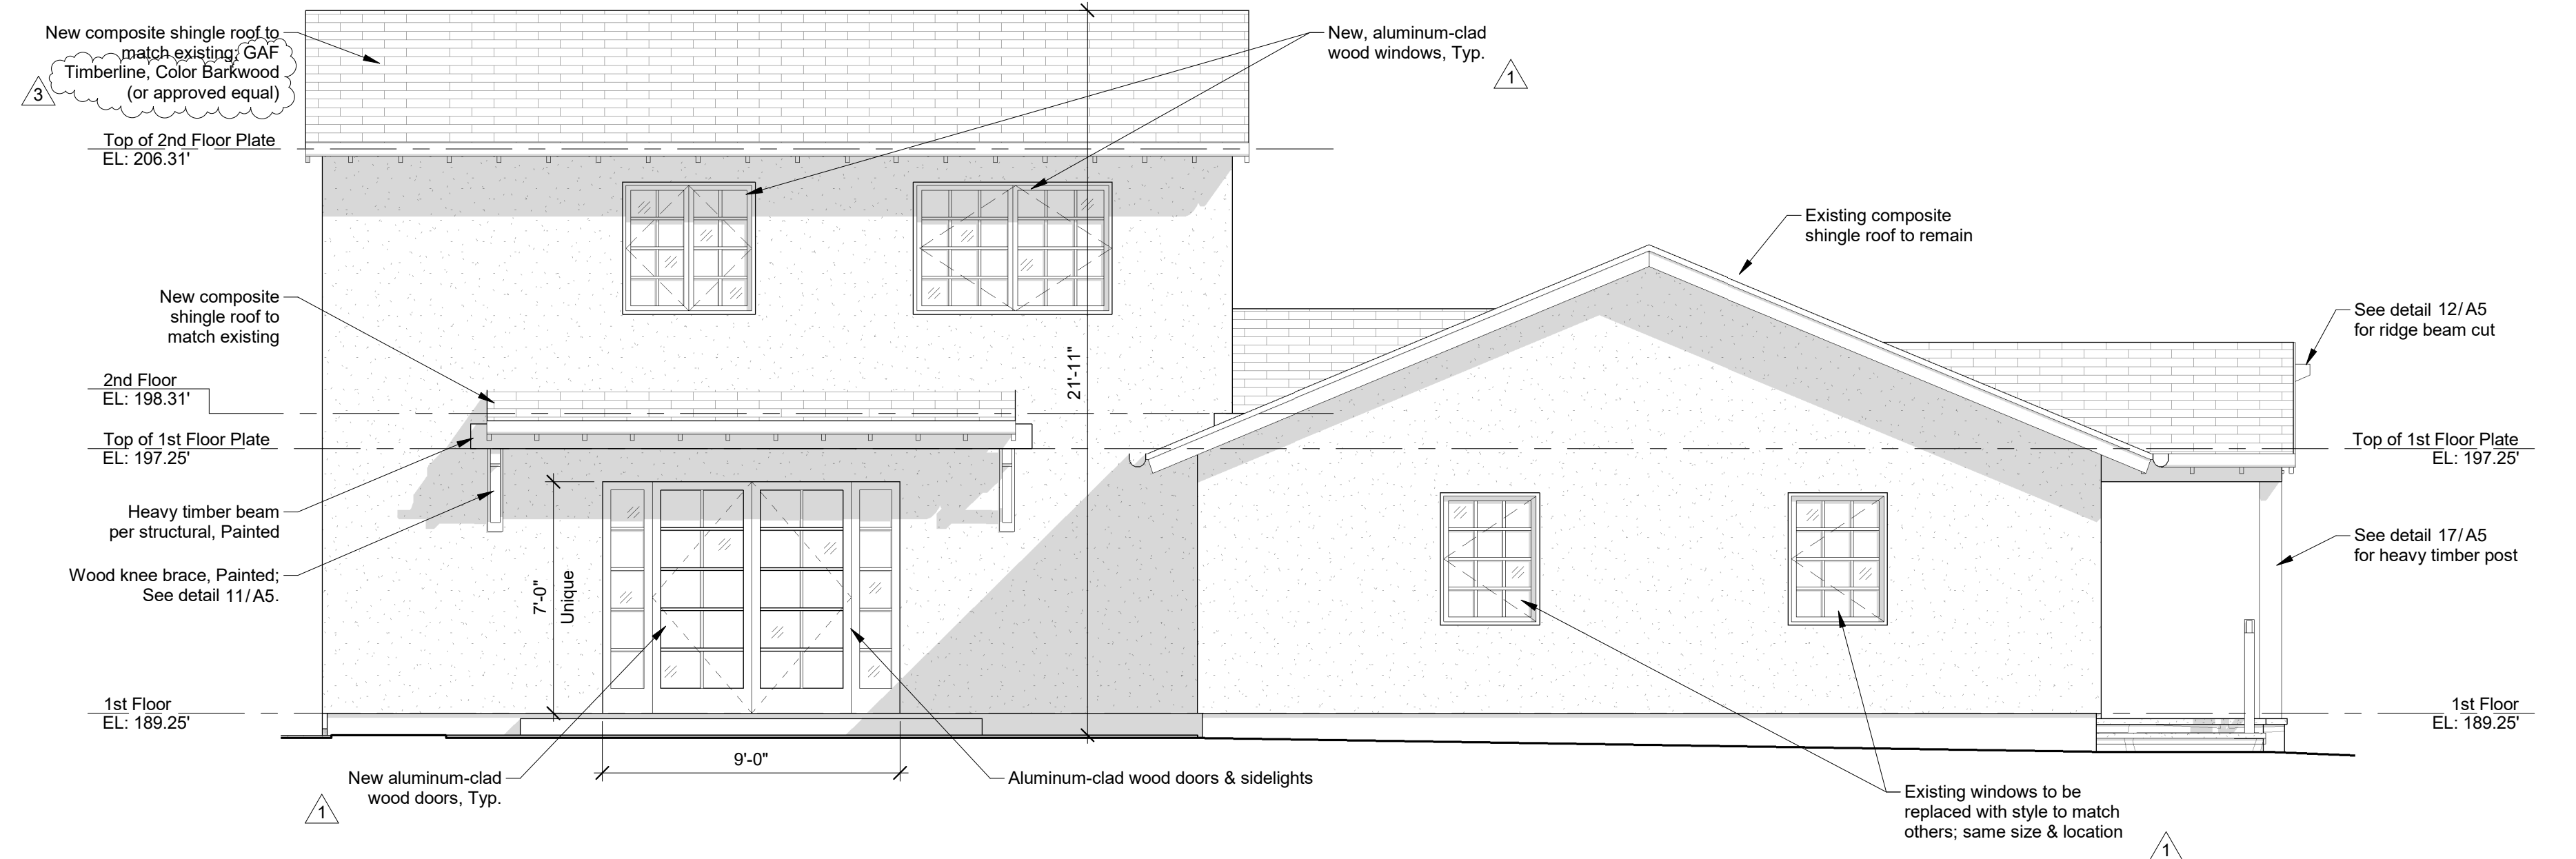

**3** Elevation - Side (North)  
 1/4" = 1'-0"

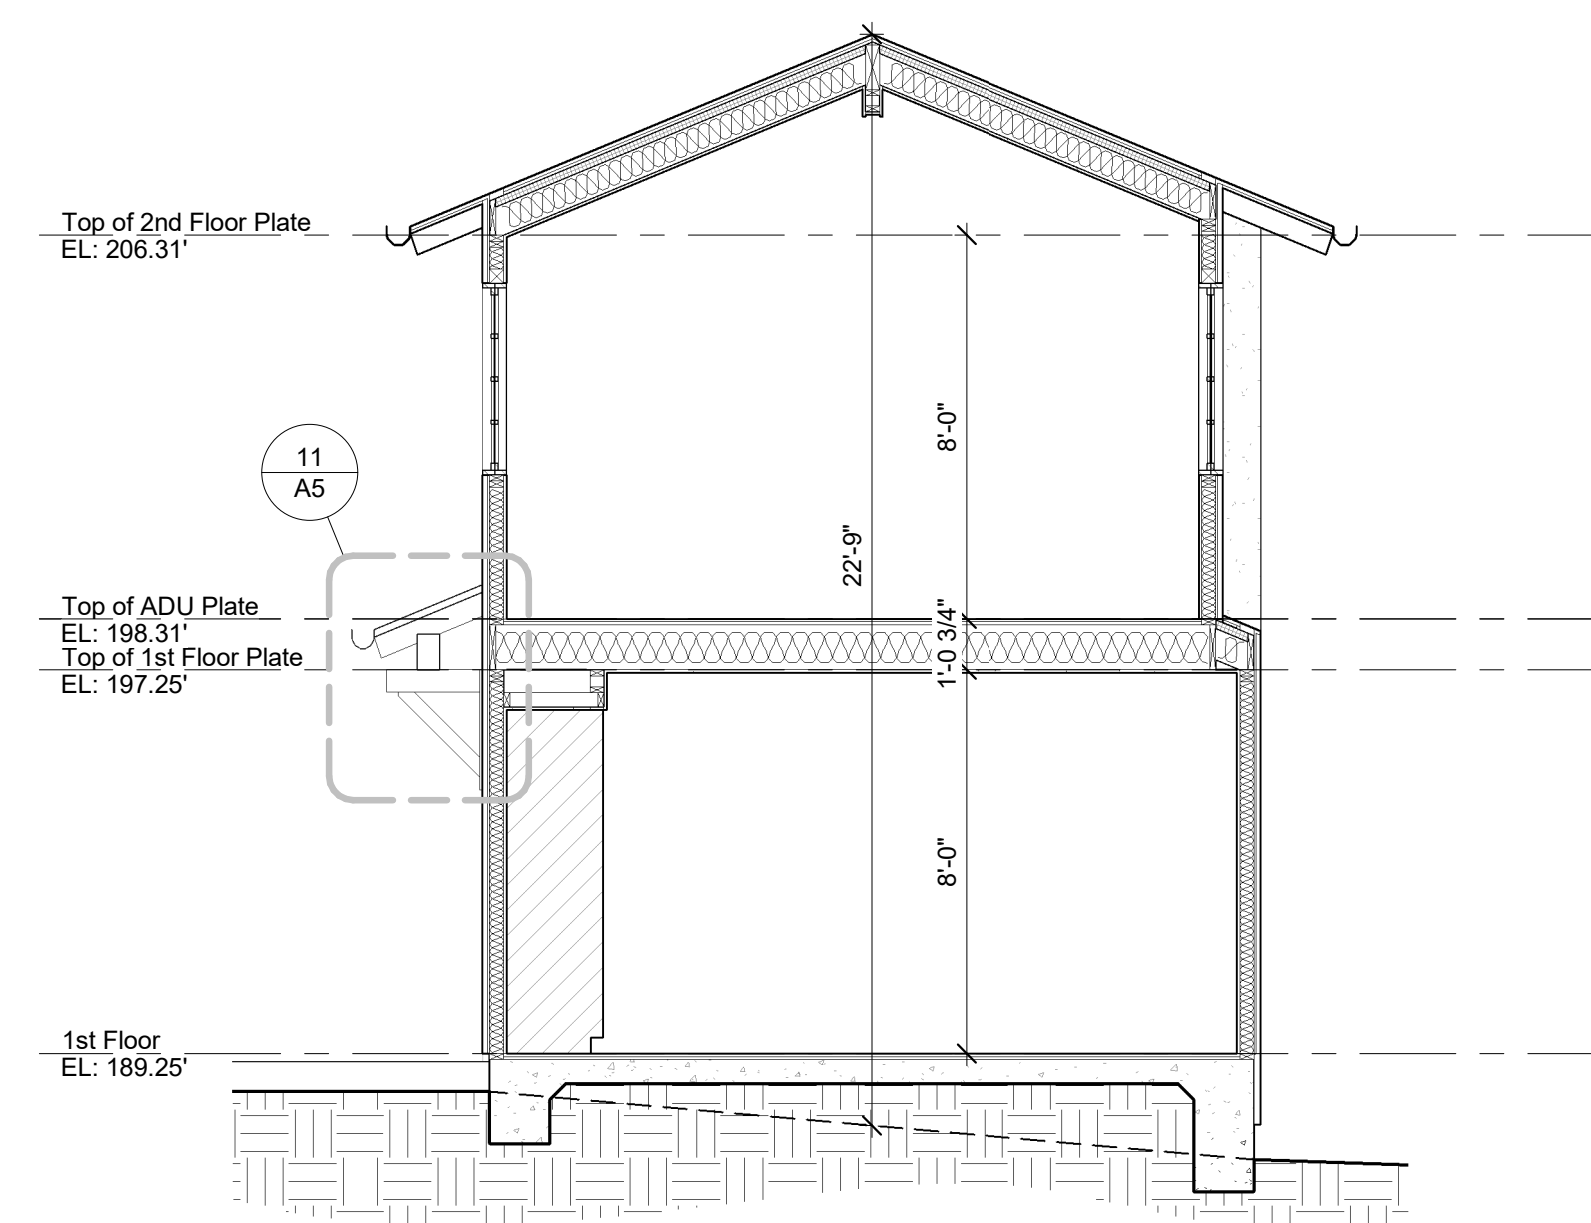

**6** Building Section  
 1/4" = 1'-0"

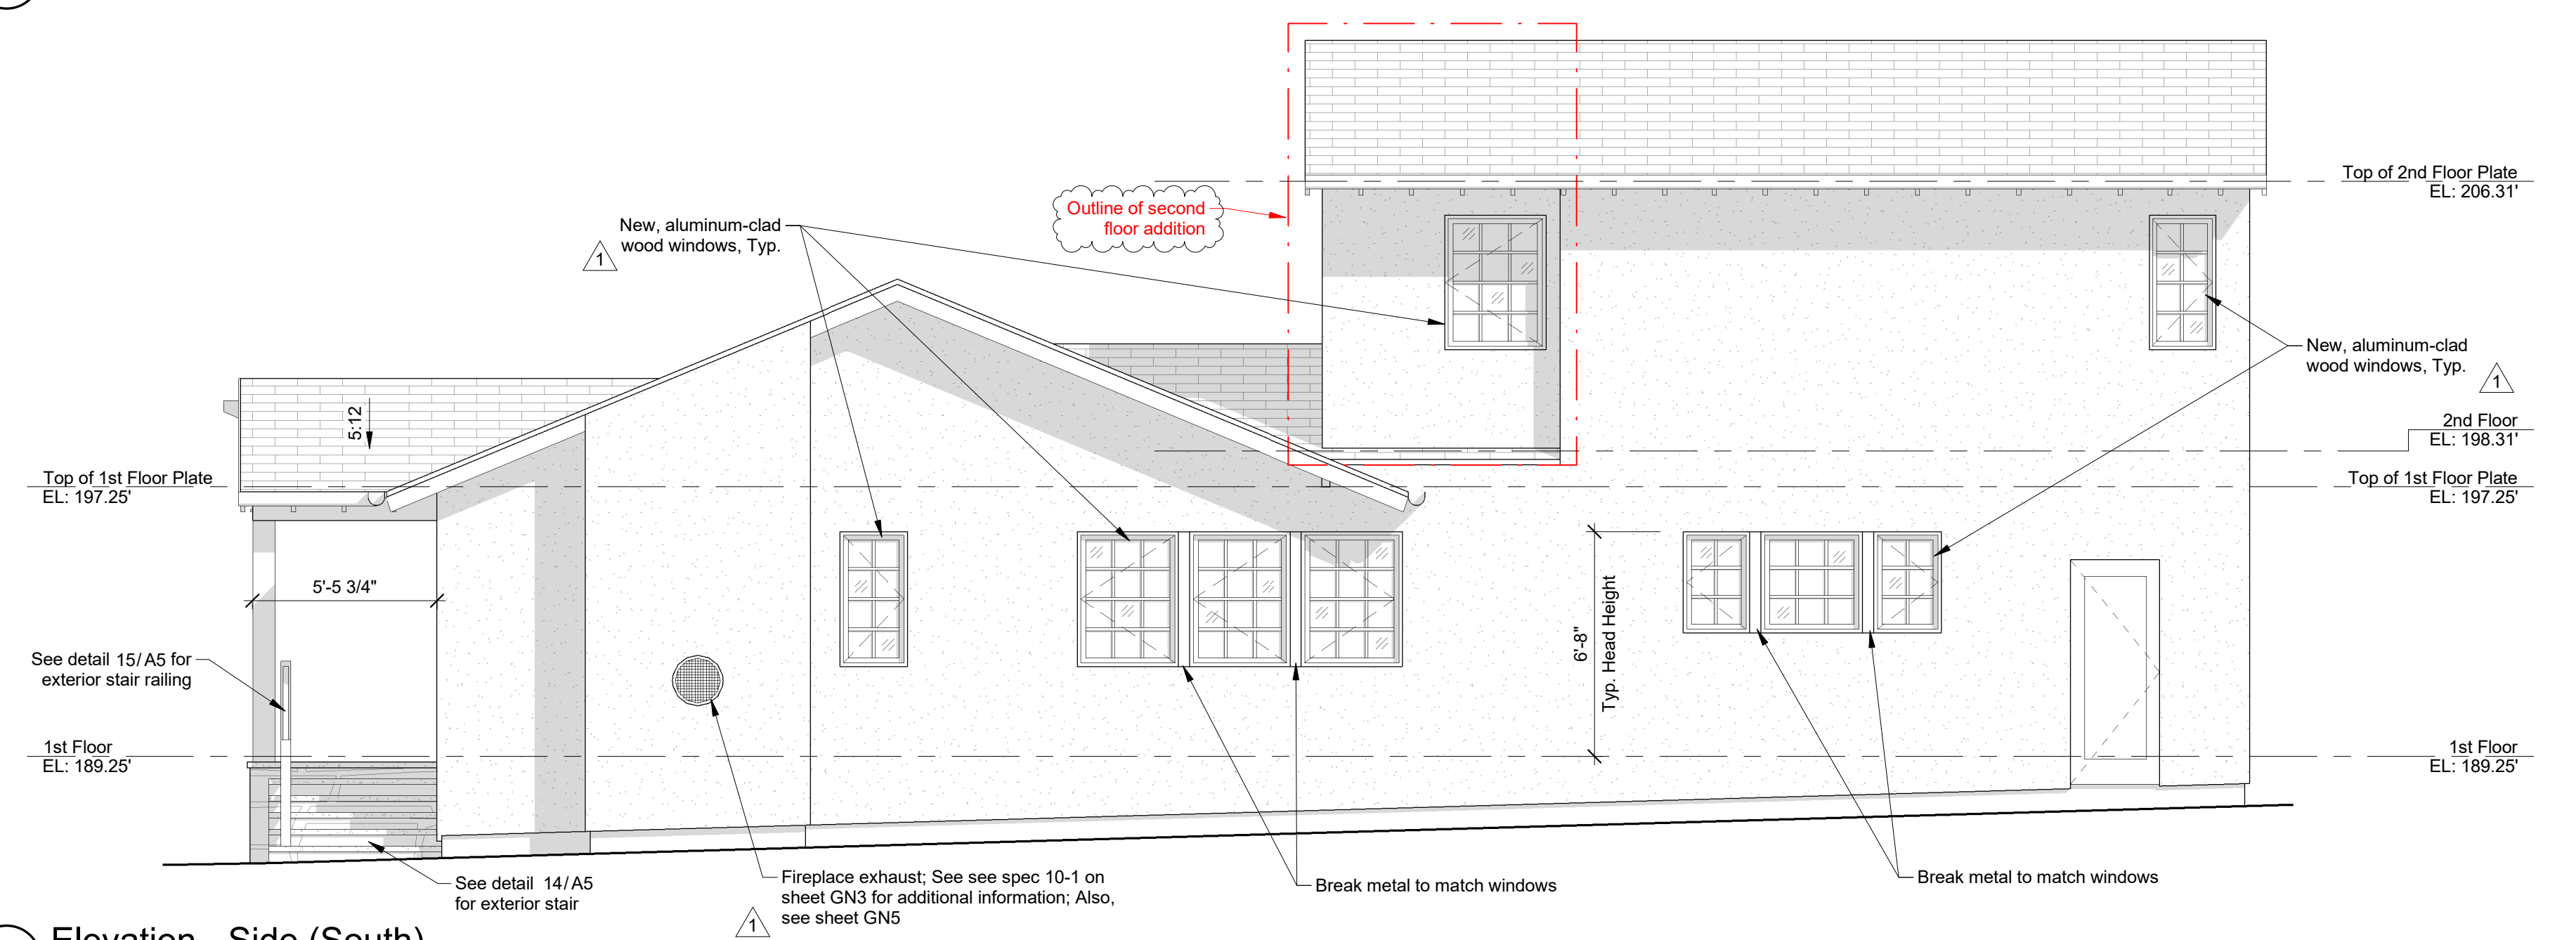


**5** Elevation - Side (South)  
 1/4" = 1'-0"




Revisions:


revision	date	notes

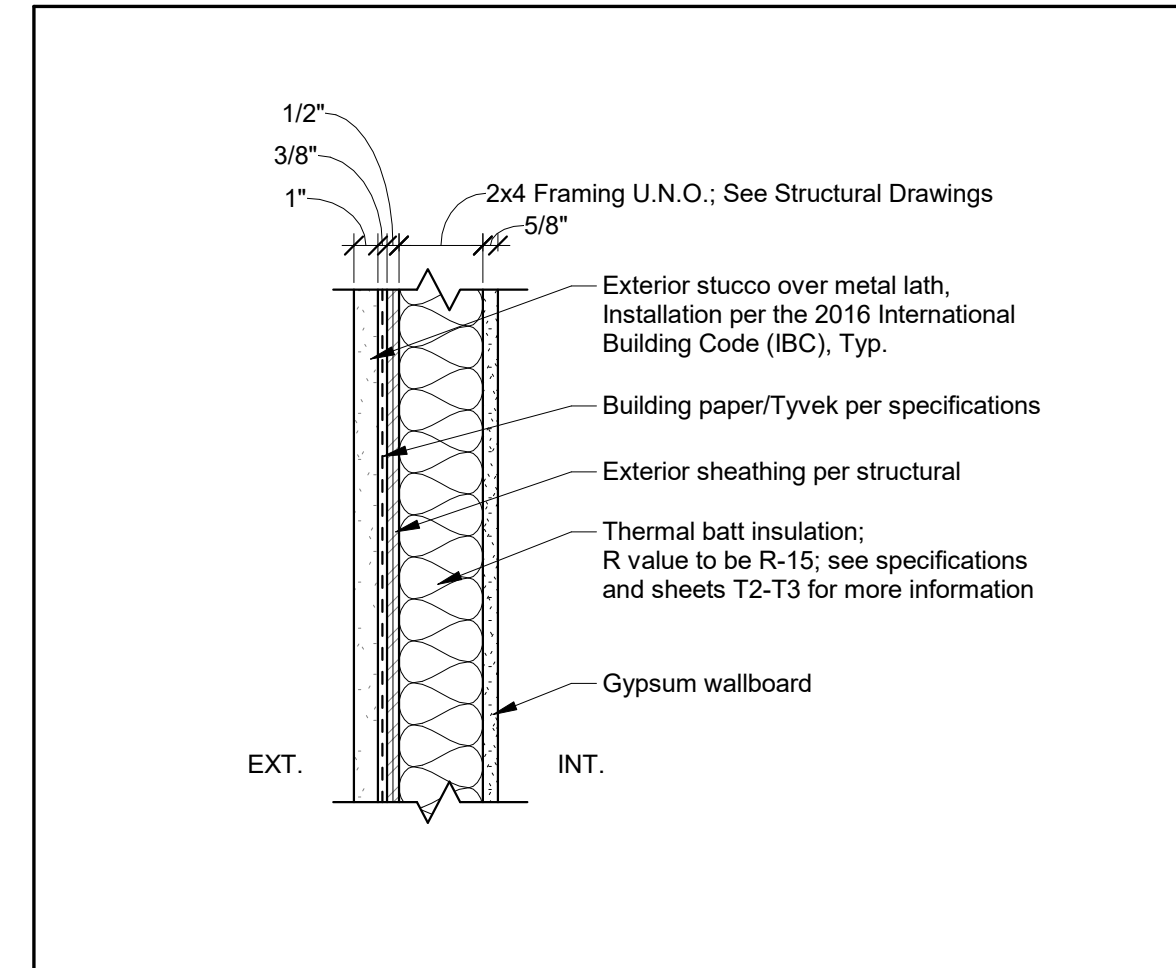


**1 Wall Type A - Exterior Wall**  
 1 1/2" = 1'-0"

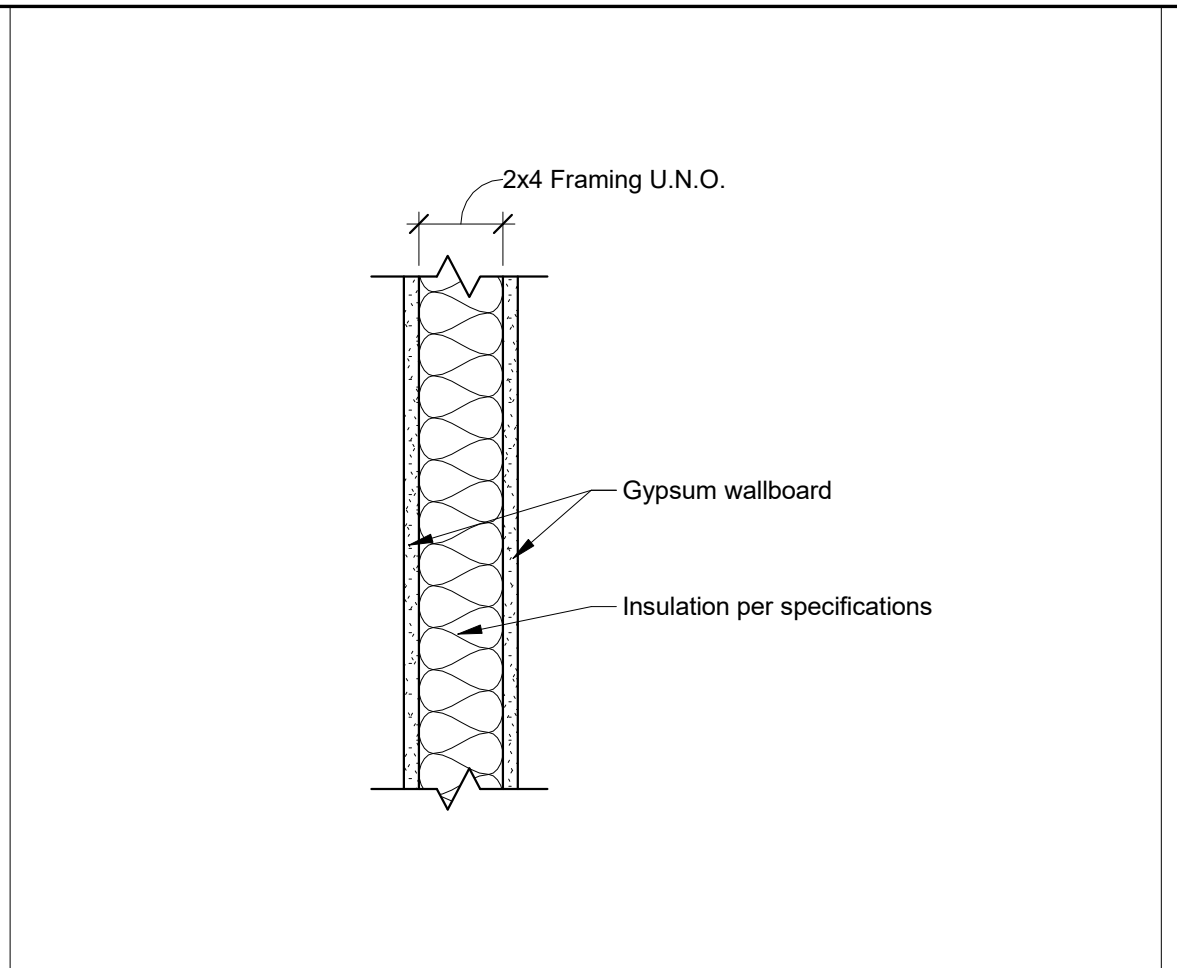


**2 Wall Type B - Interior Wall**  
 1 1/2" = 1'-0"

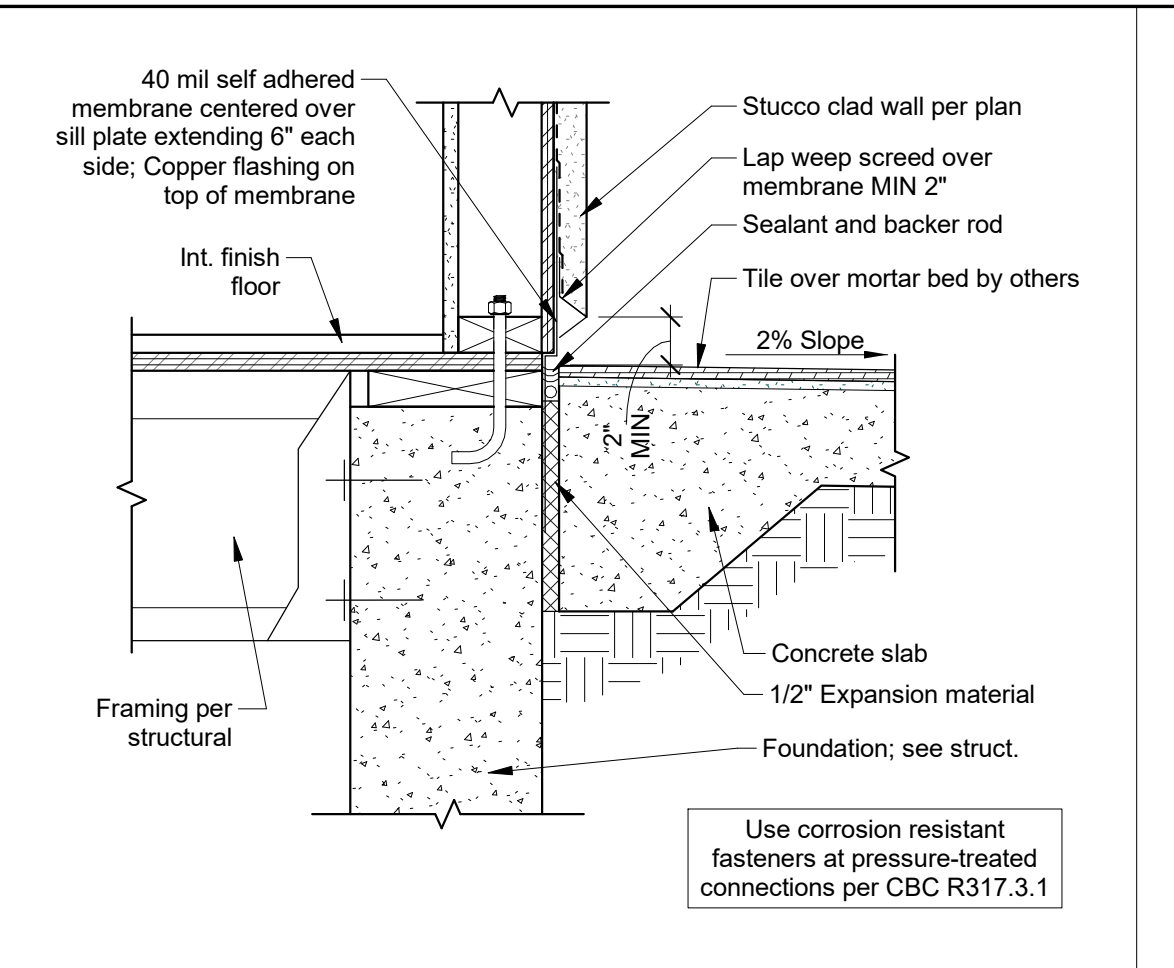


**3 Section Detail - Foundation at Patio**  
 1 1/2" = 1'-0"

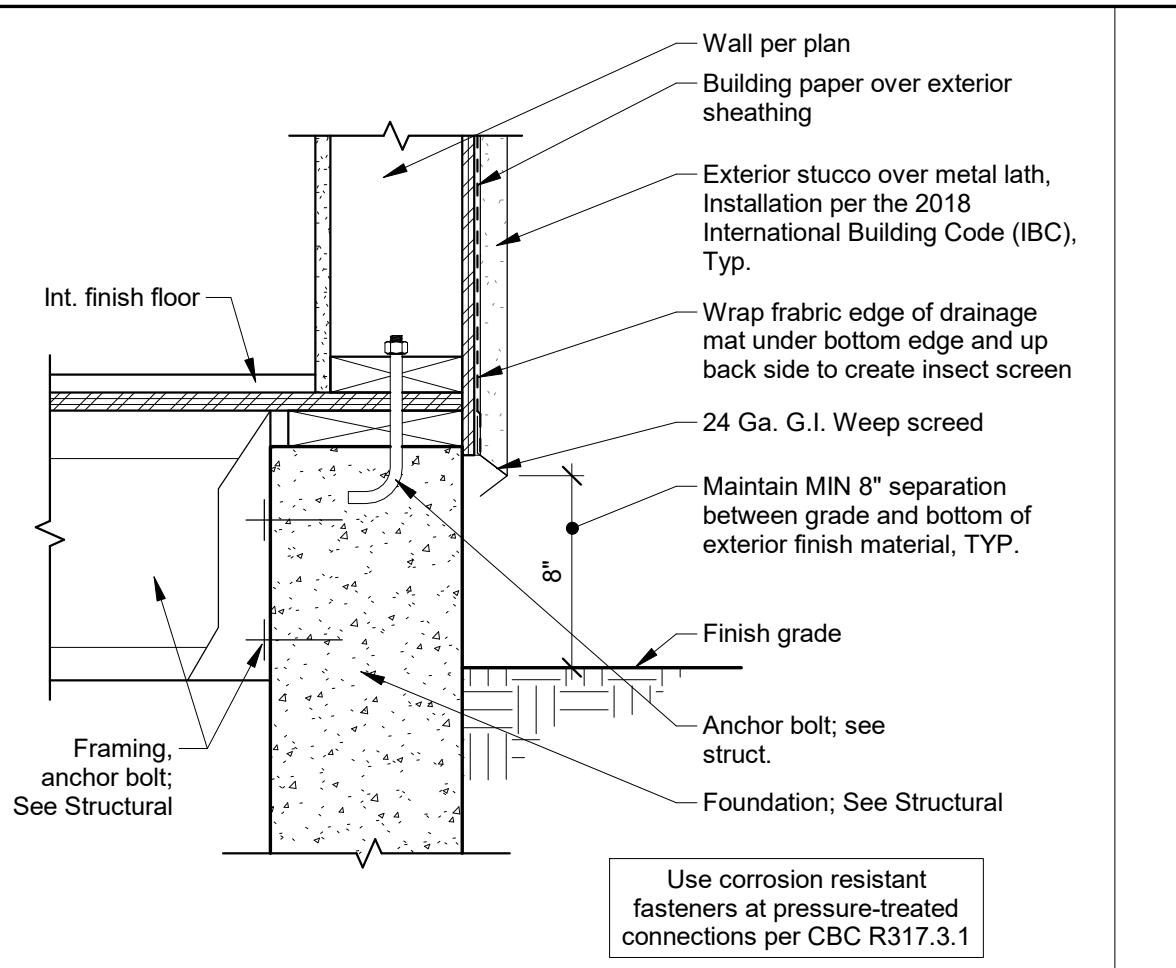


**4 Section Detail - Typ. Foundation**  
 1 1/2" = 1'-0"

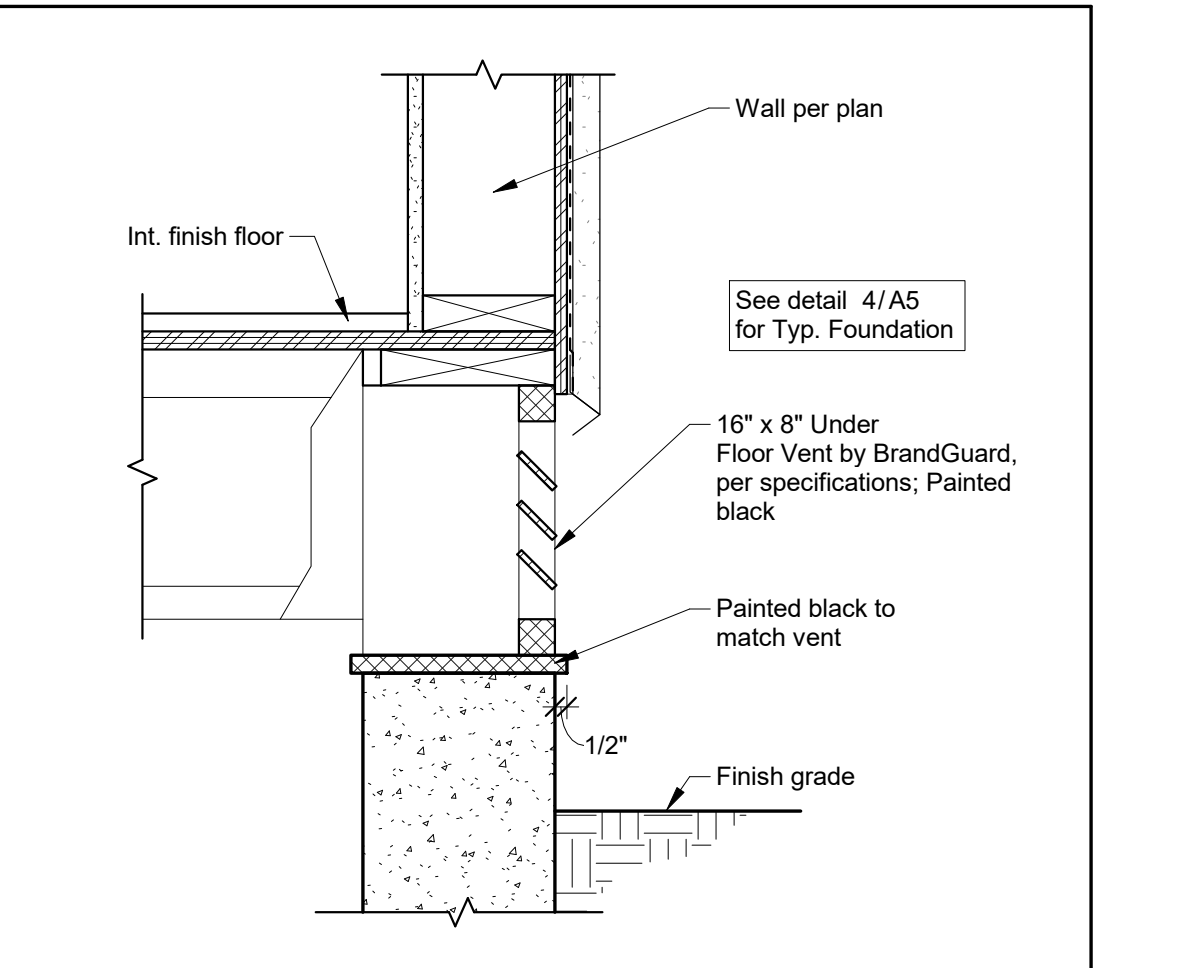


**5 Section Detail - Under Floor Vent**  
 1 1/2" = 1'-0"

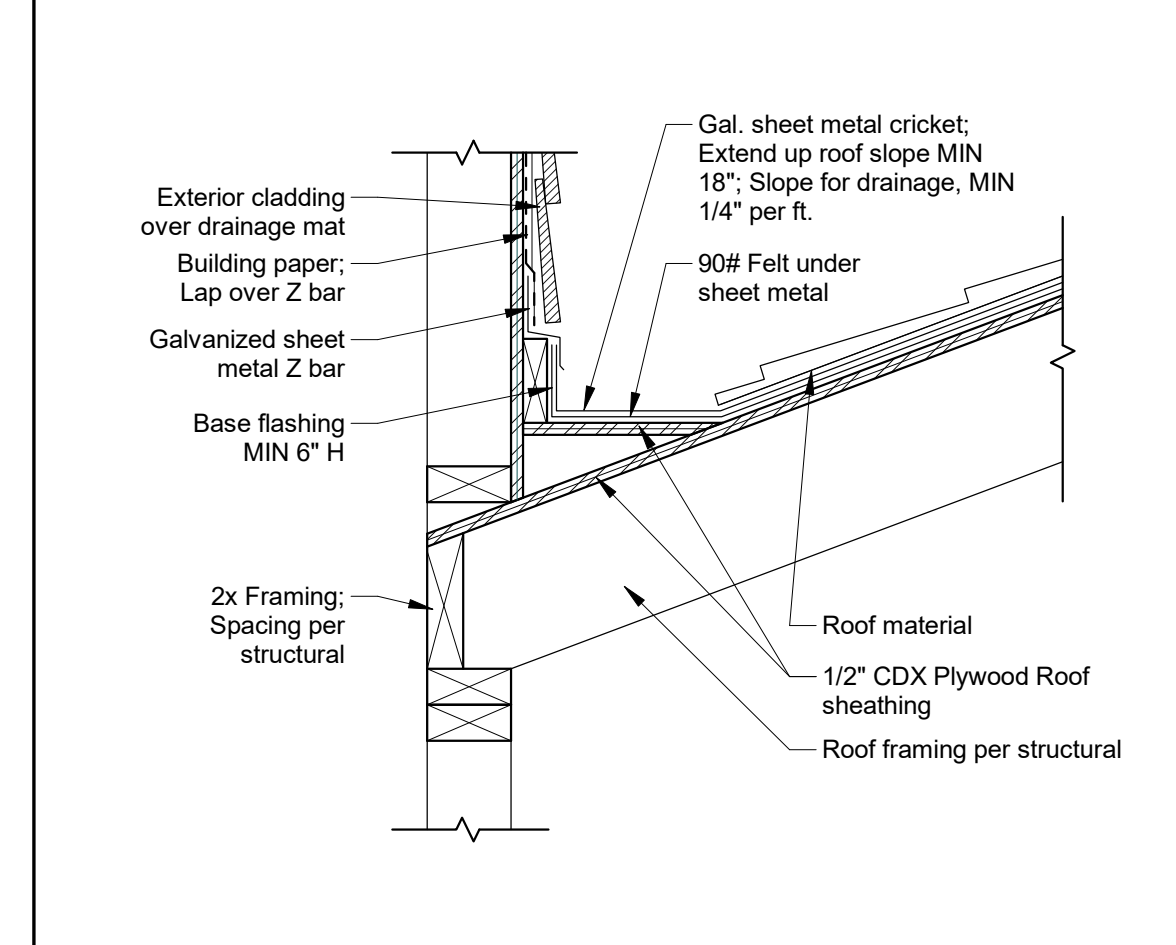


**6 Section Detail - Typ. Valley**  
 1 1/2" = 1'-0"

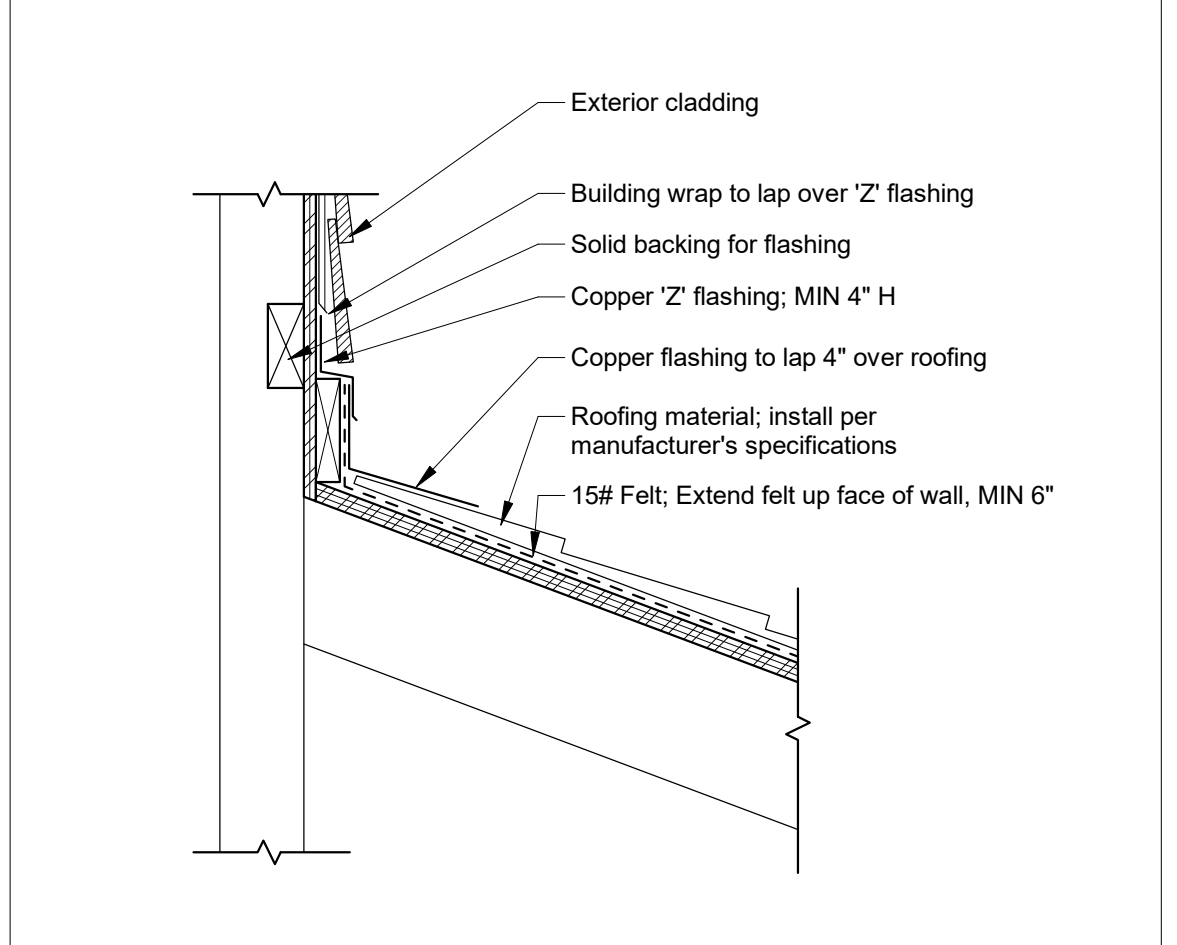


**7 Section Detail - Roof at Wall**  
 1 1/2" = 1'-0"

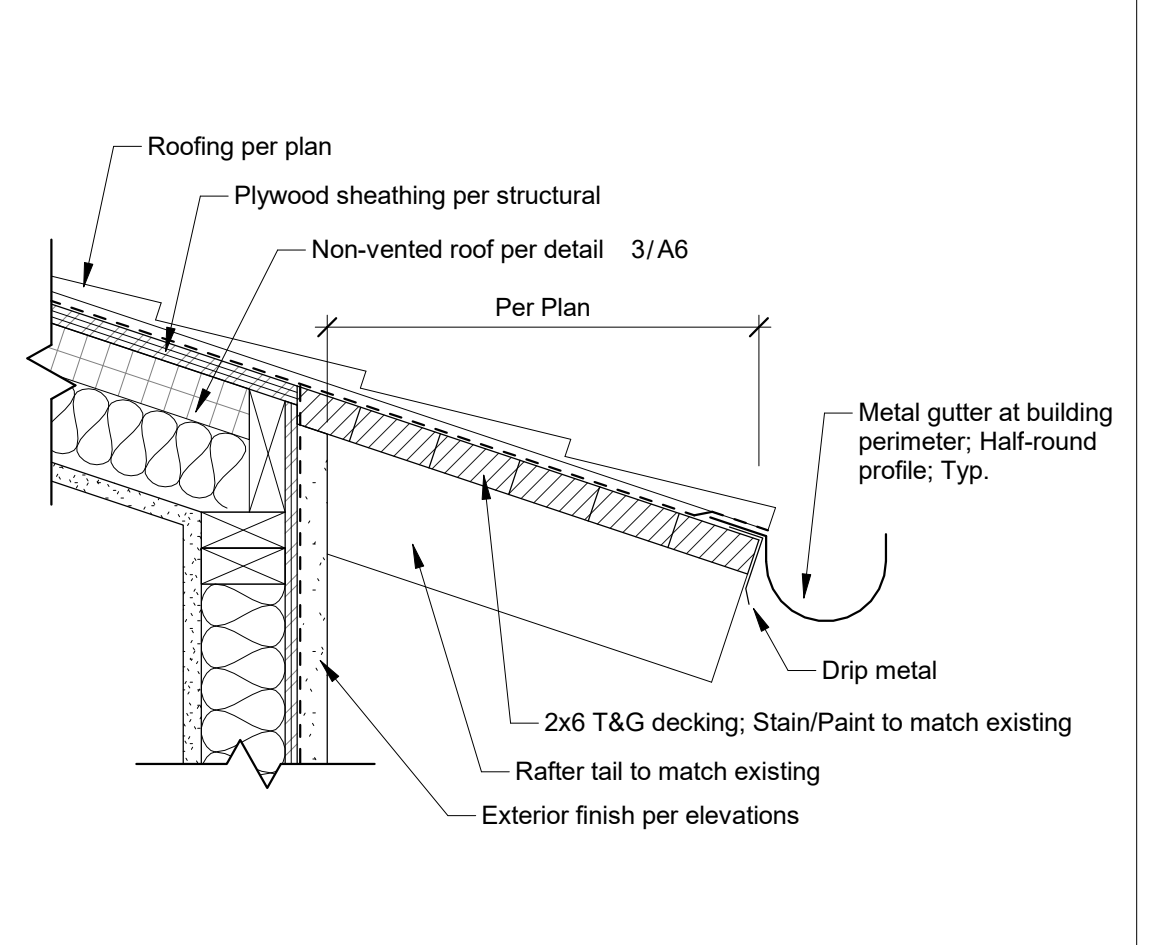


**8 Section Detail - Typ. Roof Eave**  
 1 1/2" = 1'-0"

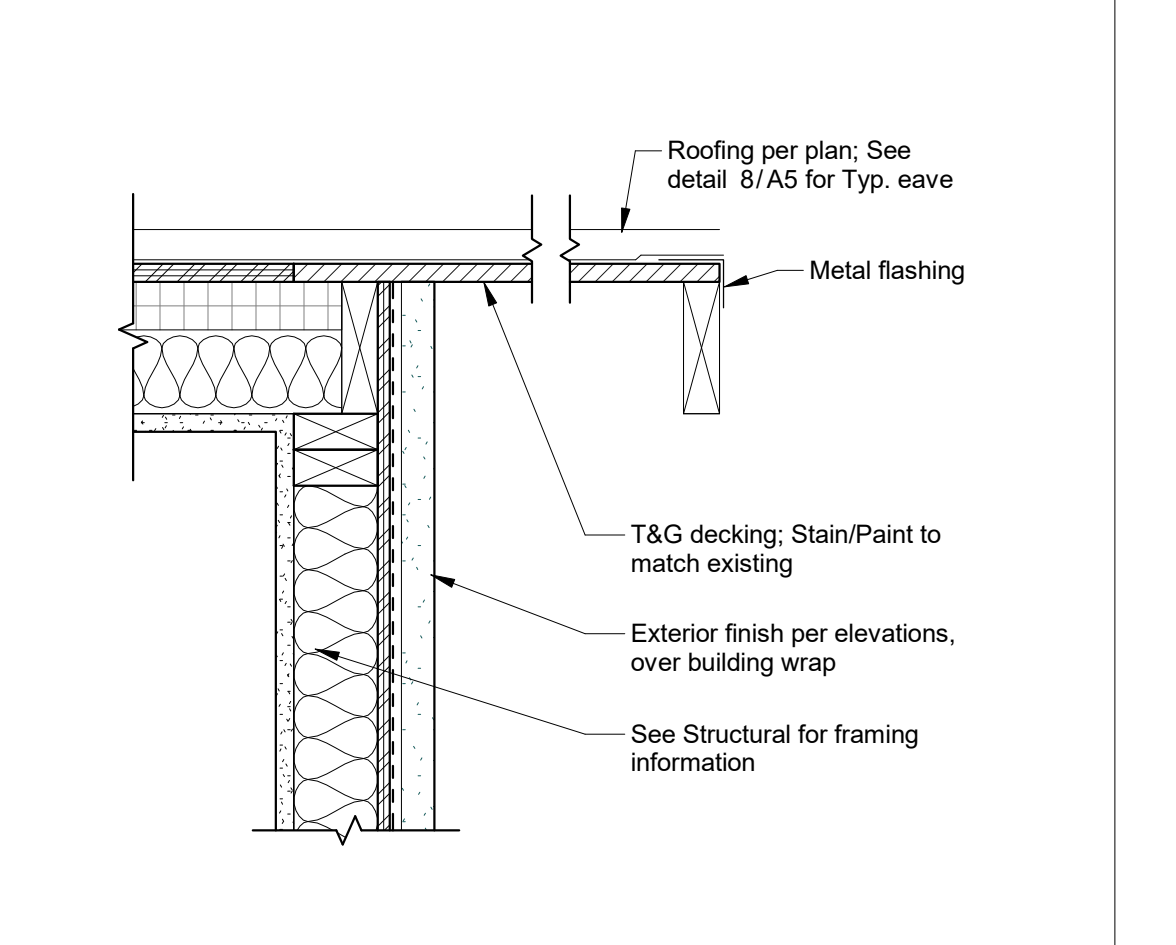


**9 Section Detail - Typ. Gable End**  
 1 1/2" = 1'-0"

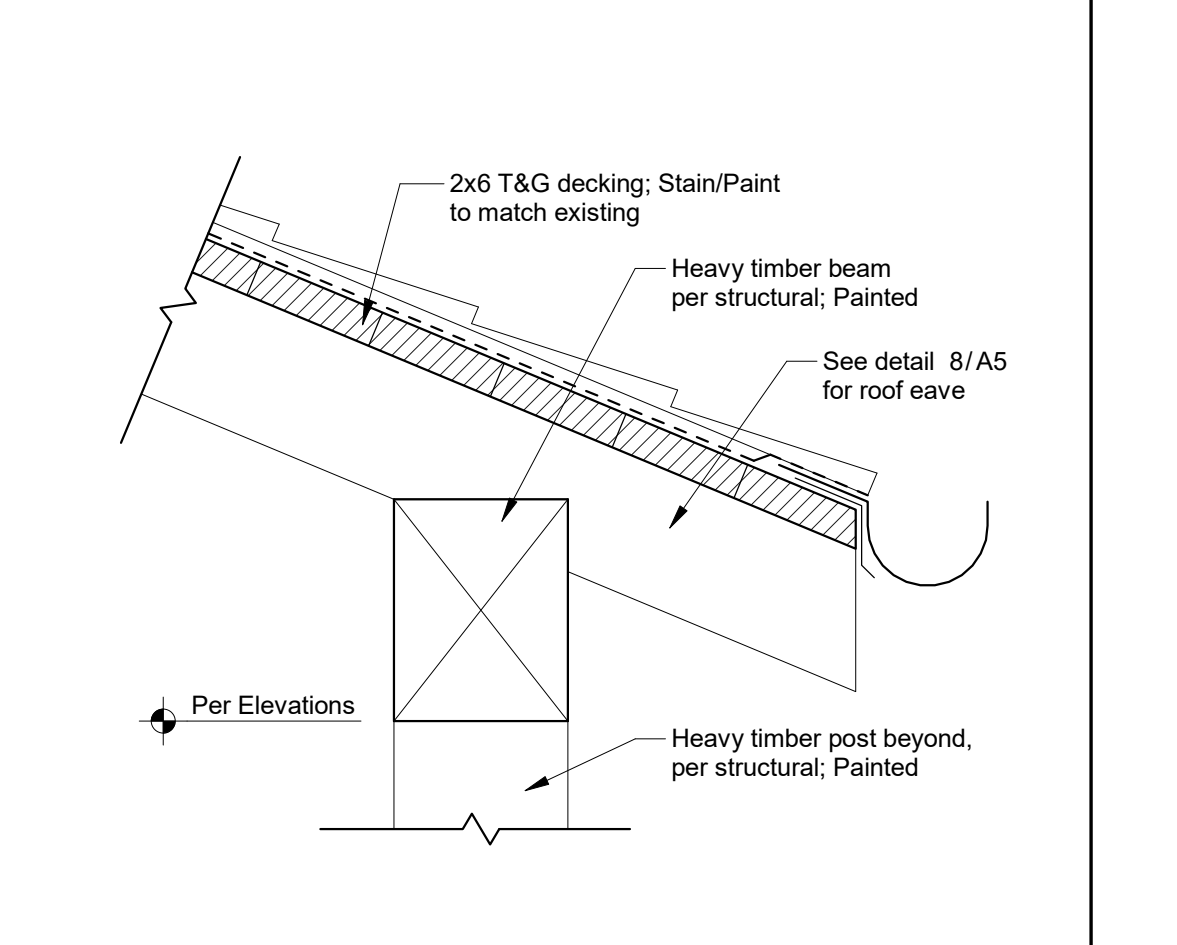


**10 Section Detail - Eave at Patio**  
 1 1/2" = 1'-0"

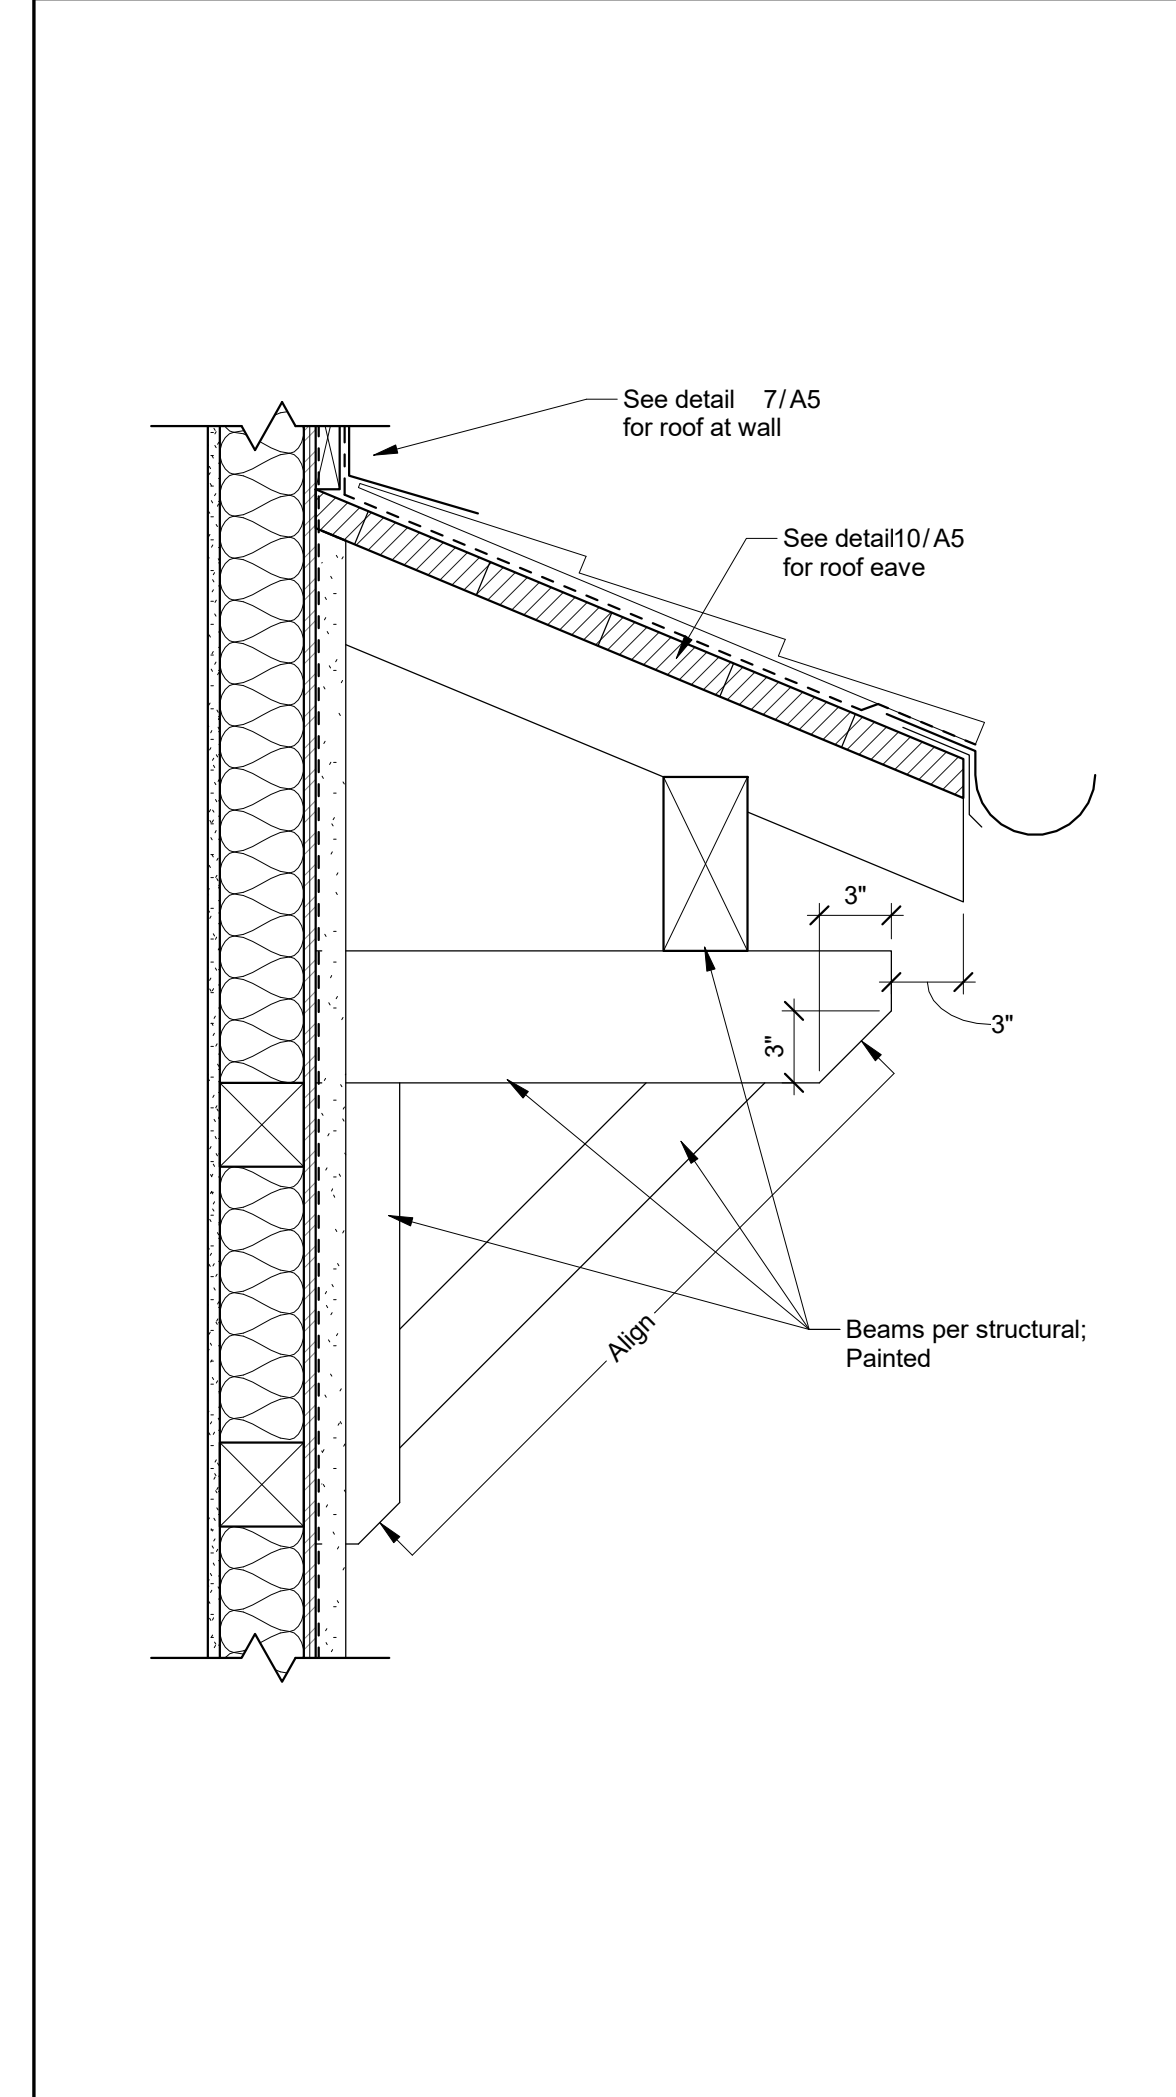


**11 Section Detail - Knee Brace**  
 1 1/2" = 1'-0"

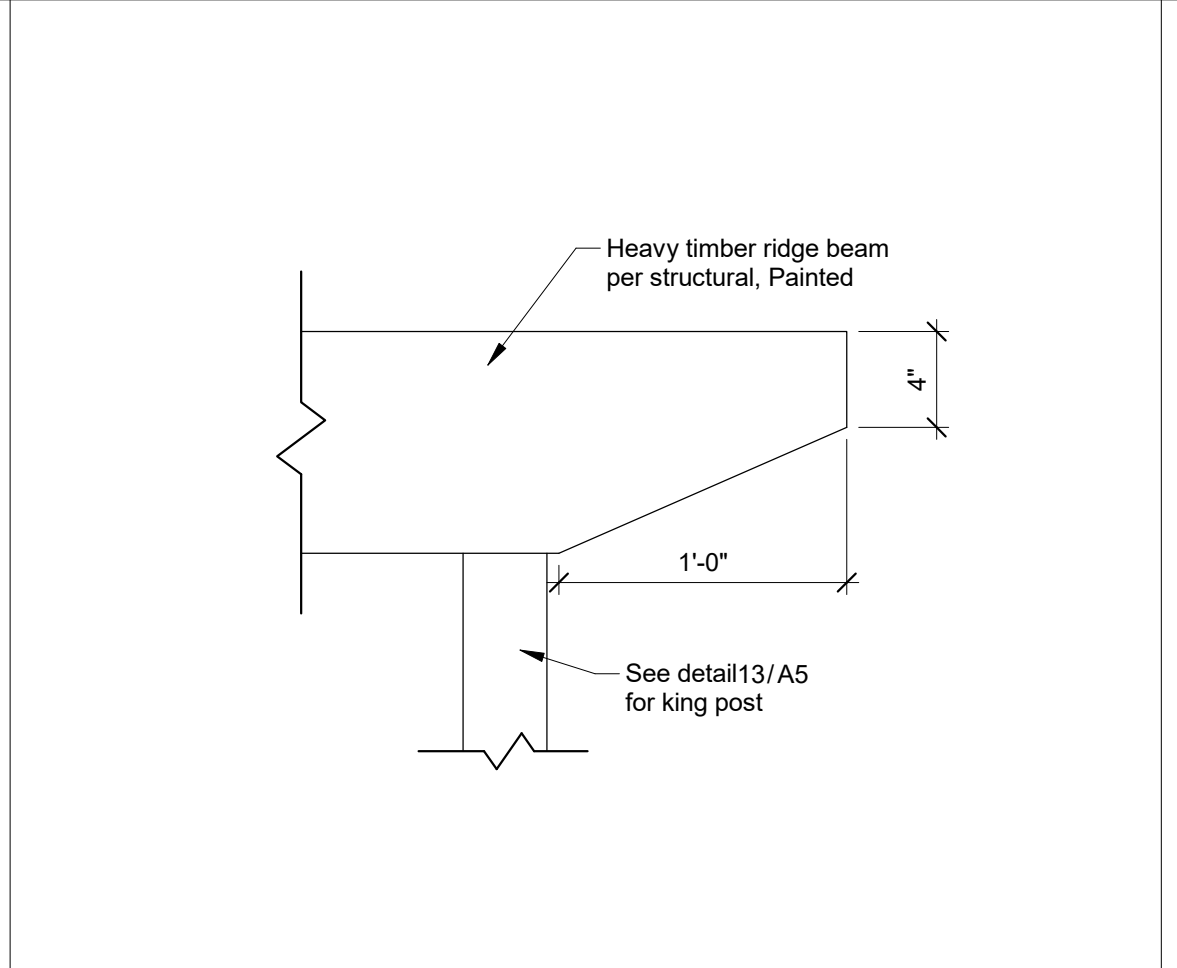


**12 Elevation Detail - Ridge Beam Cut**  
 1 1/2" = 1'-0"

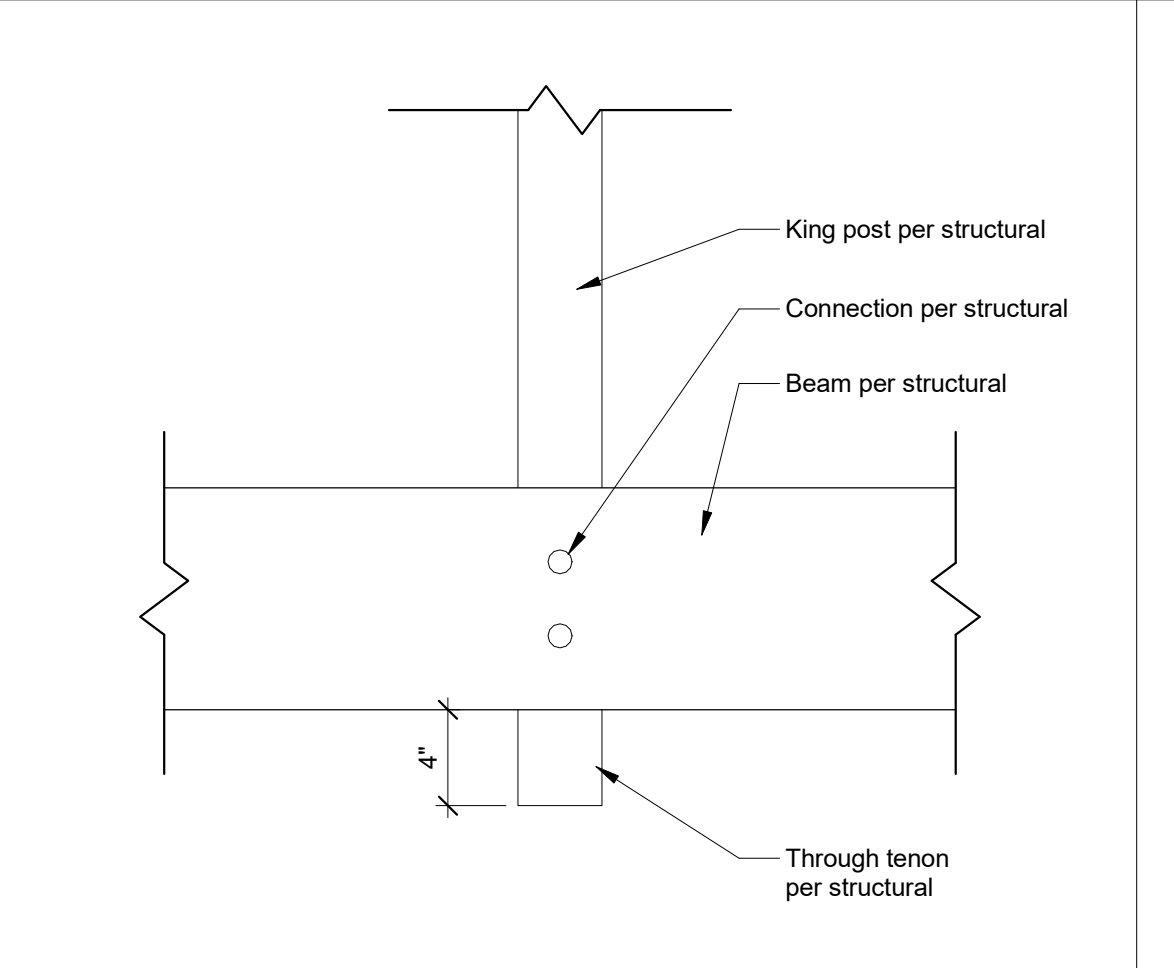


**13 Elevation Detail - King Post**  
 1 1/2" = 1'-0"

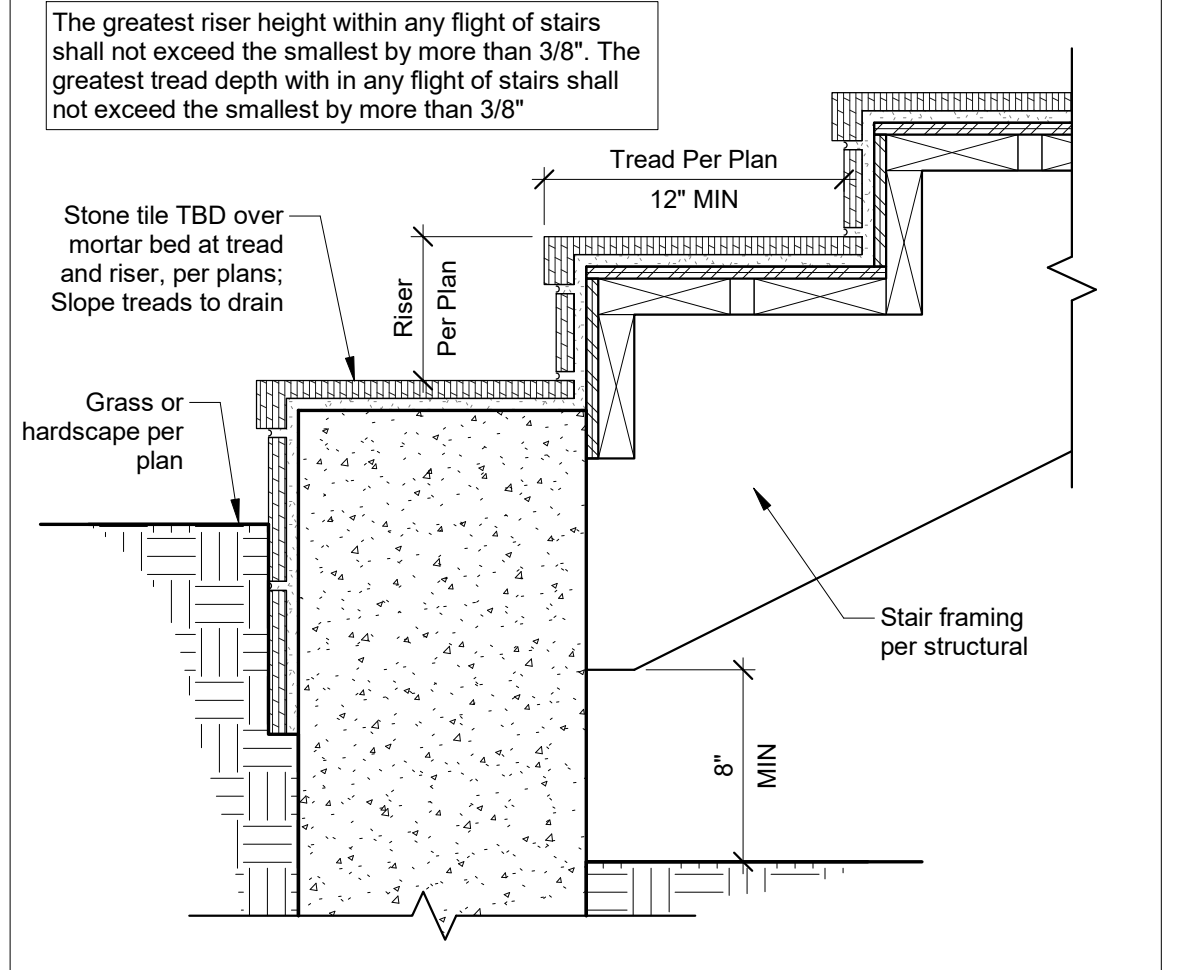


**14 Section Detail - Exterior Stair**  
 1 1/2" = 1'-0"

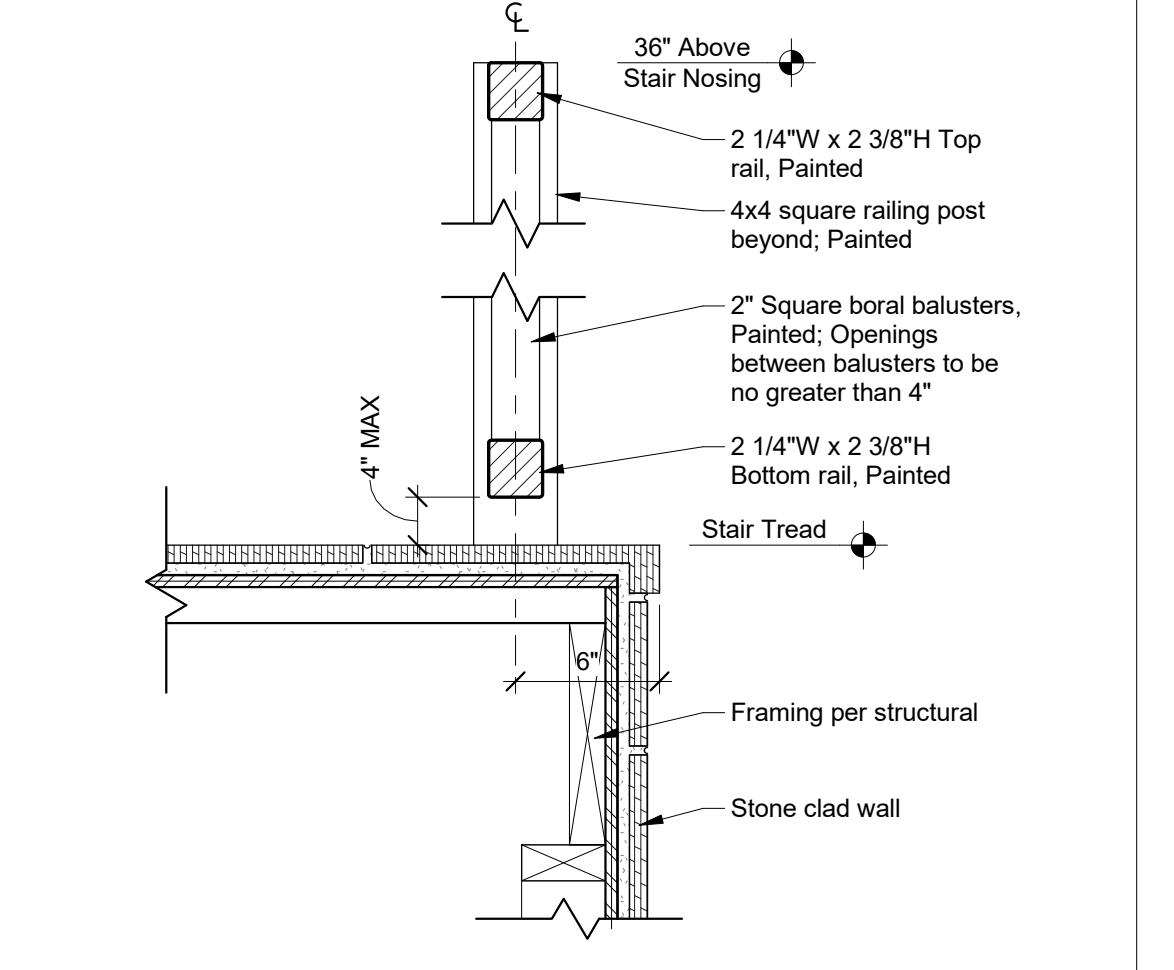

**15 Section Detail - Exterior Stair Railing**  
 1 1/2" = 1'-0"

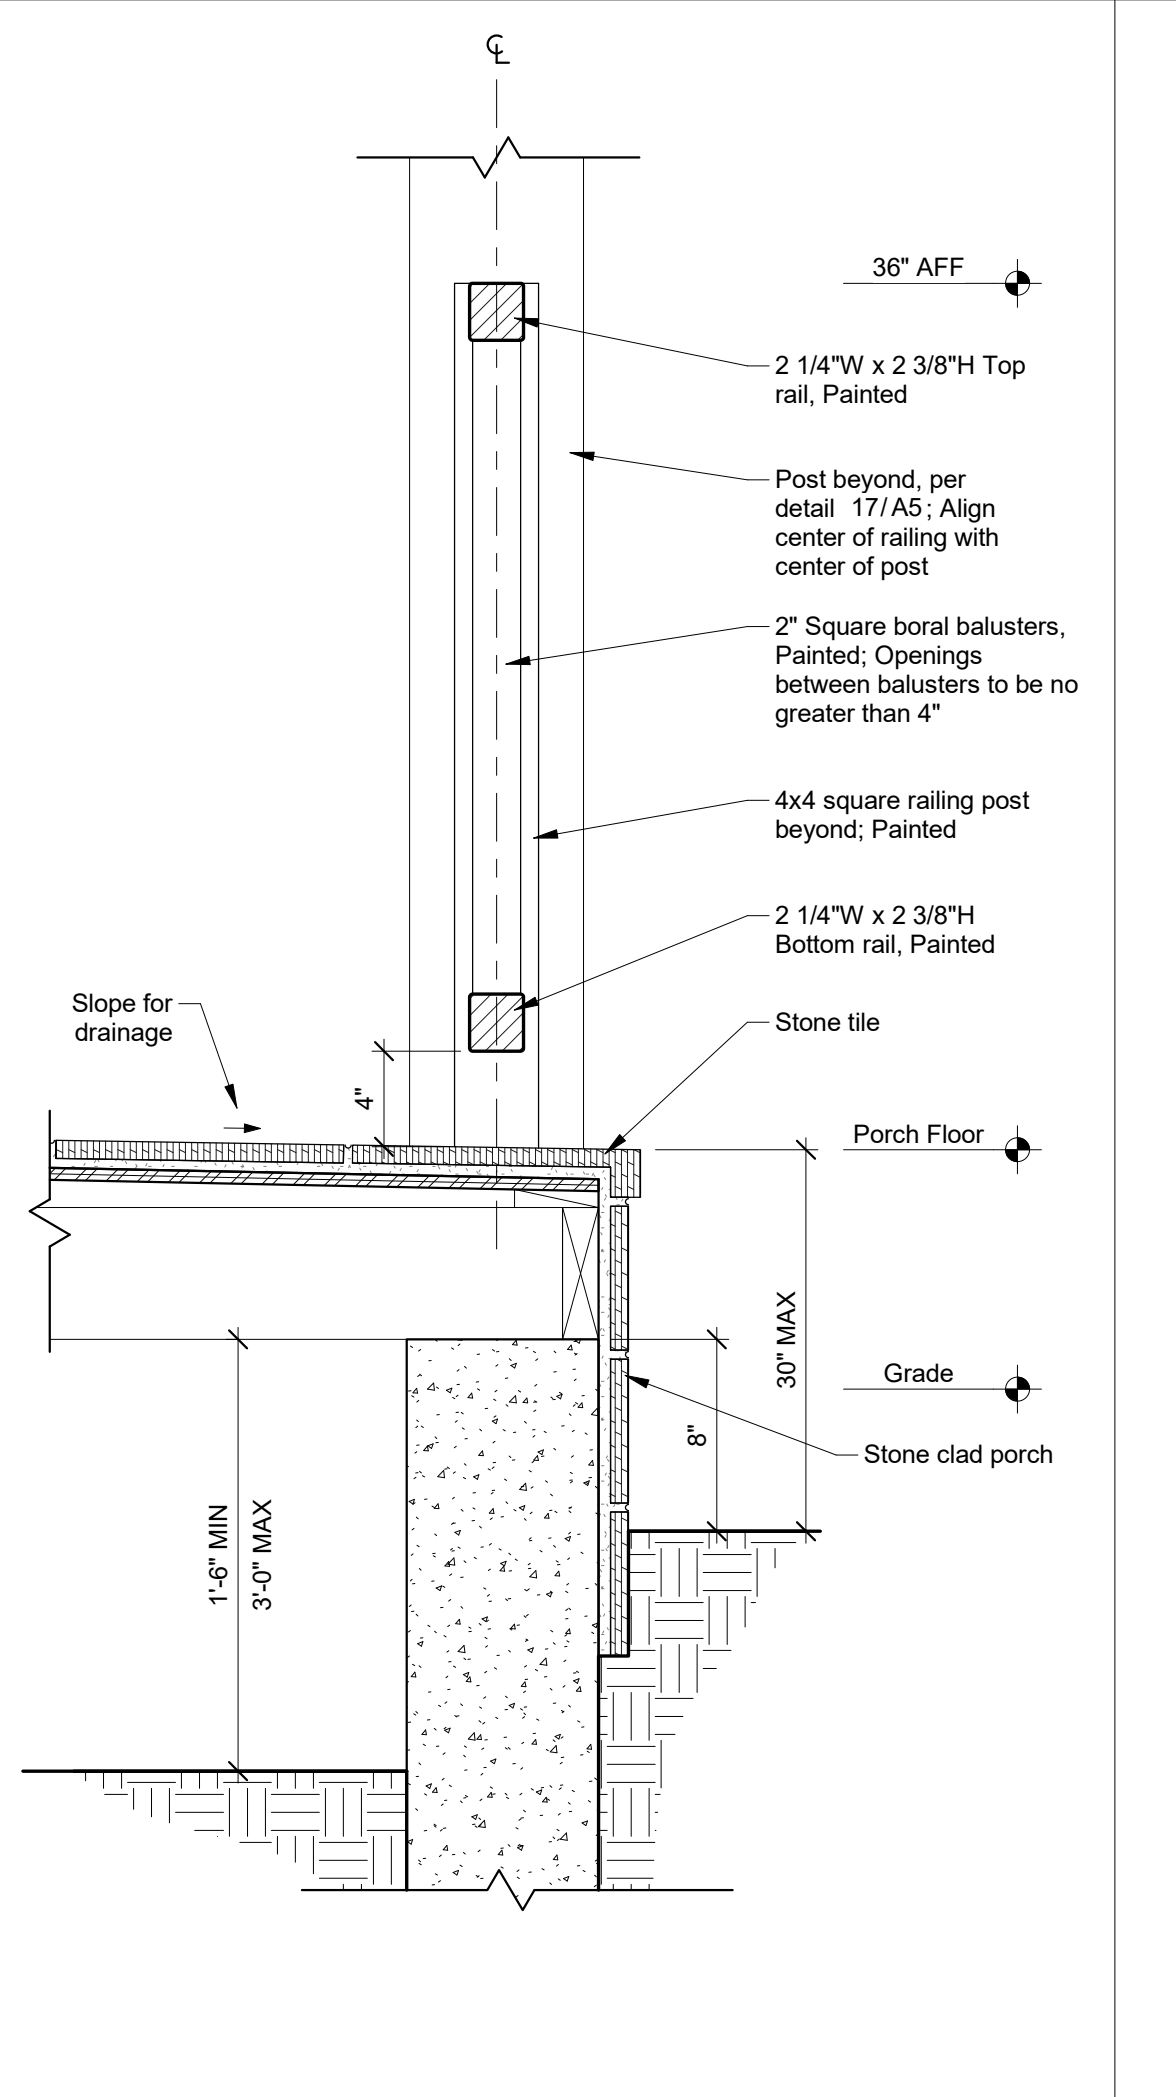


**16 Section Detail - Porch Railing**  
 1 1/2" = 1'-0"

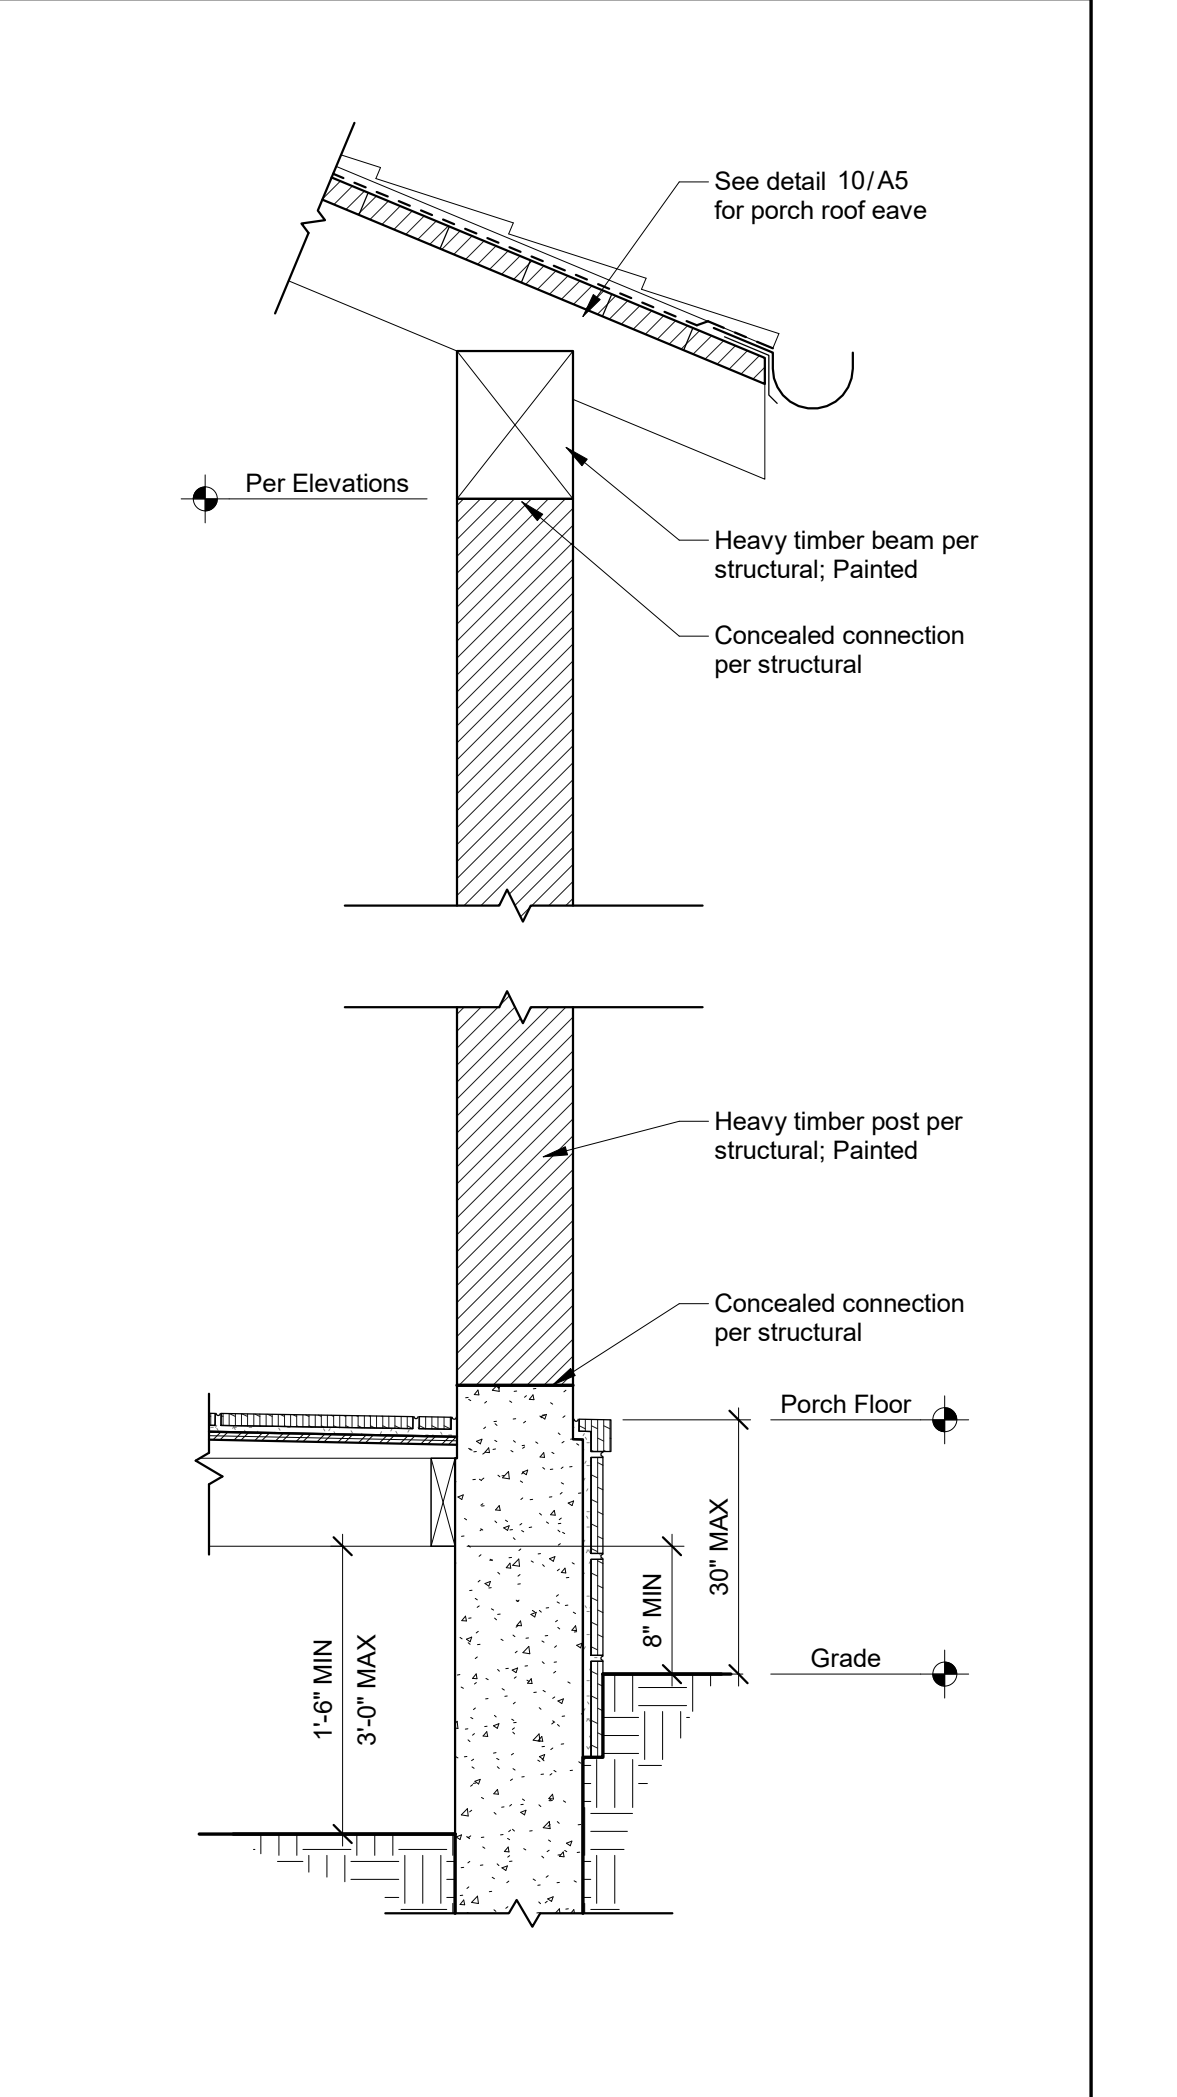


**17 Section Detail - Typ. Column**  
 1" = 1'-0"




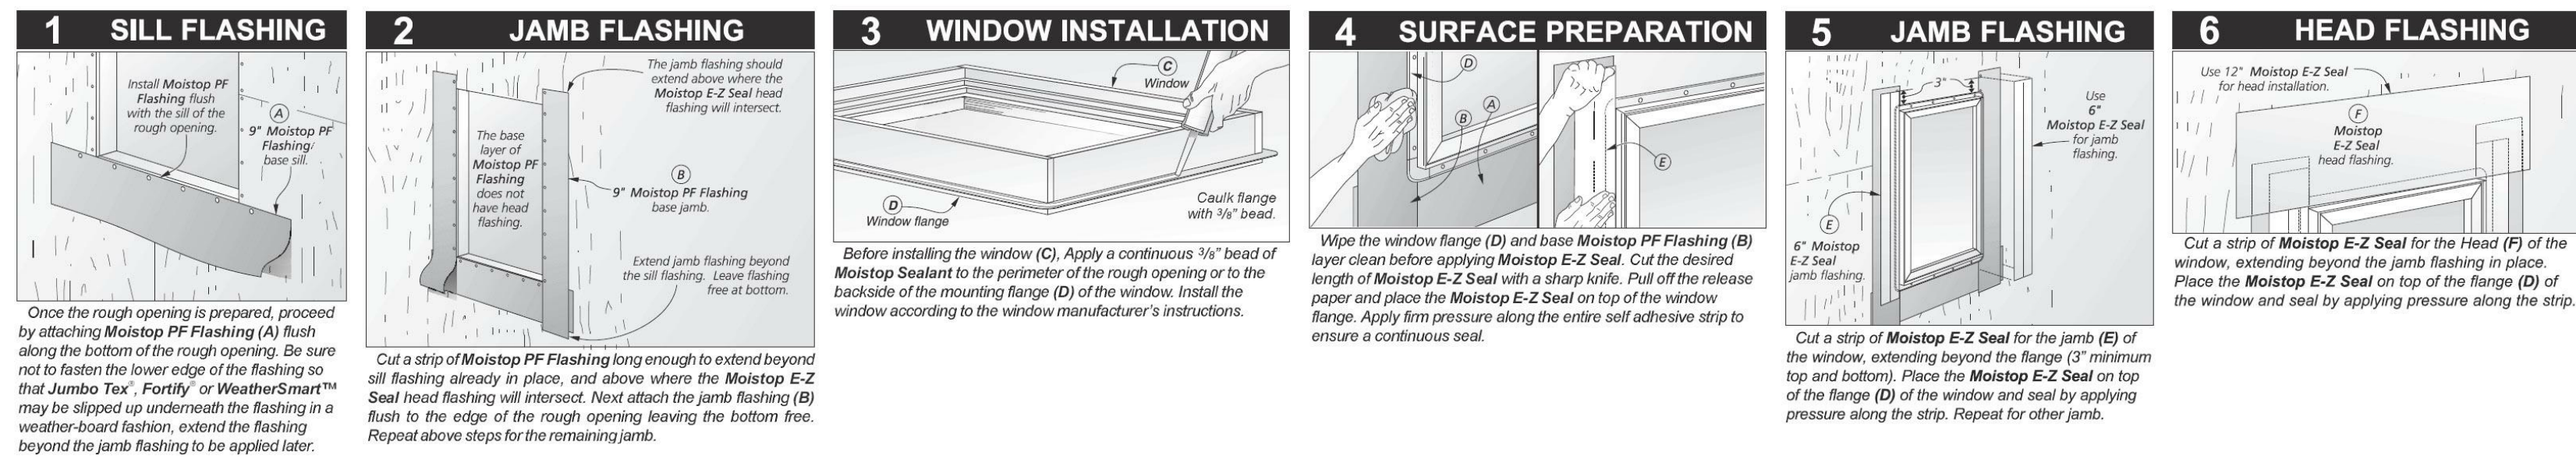

1 Typical Window Installation

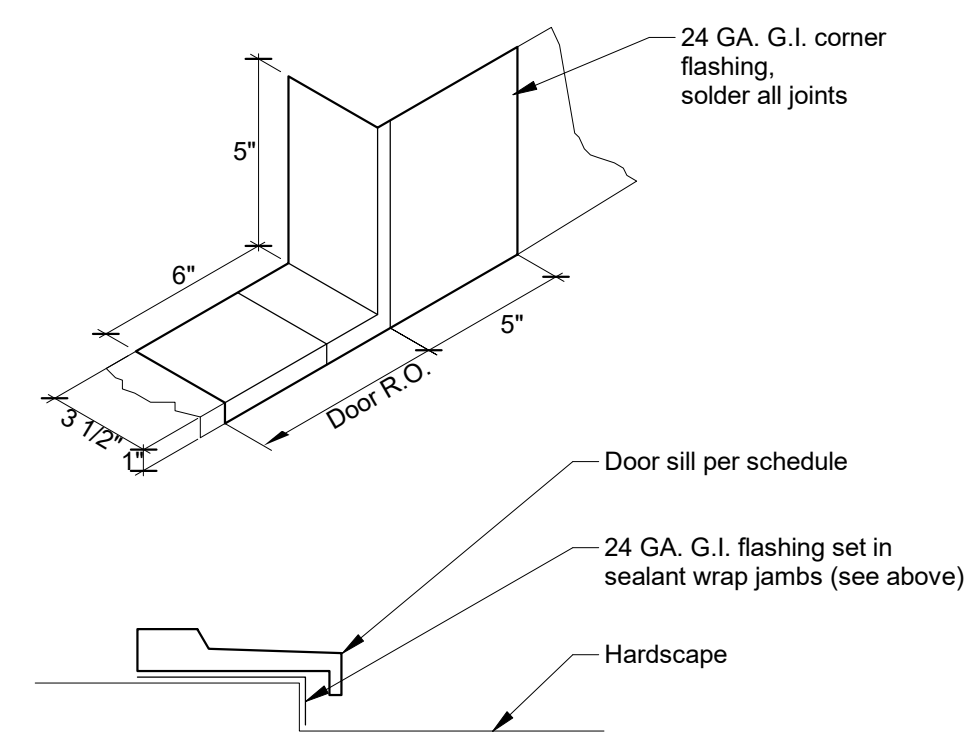

2 Door Flashing  
1 1/2" = 1'-0"

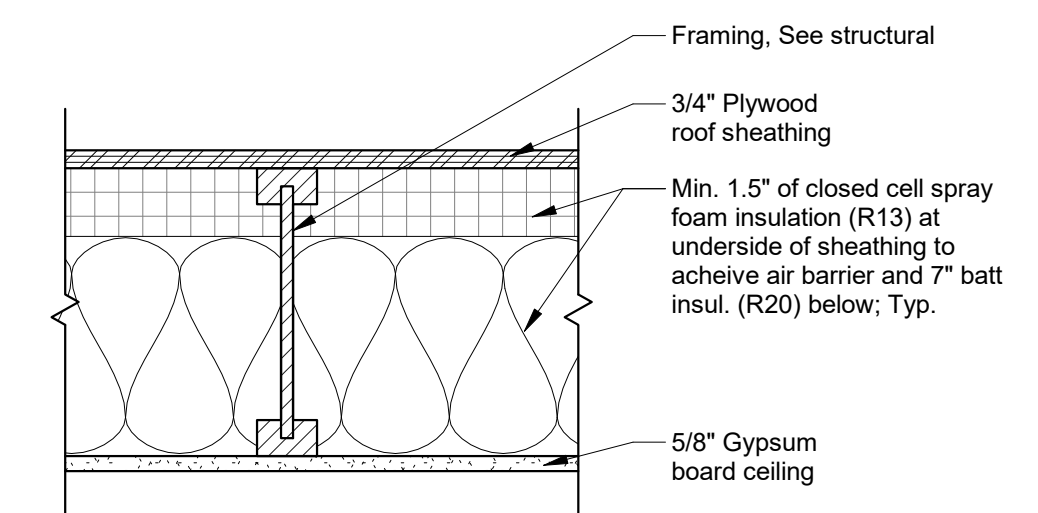

3 Non-Vented Roof Detail  
1 1/2" = 1'-0"

**NN DESIGN**

**NICODEMUS DESIGN**  
8861 Villa La Jolla Dr.,  
P.O. Box # 13367,  
La Jolla, CA 92037  
Phone: (760) 473-1041

DESIGNER:

*Signature*

Drawn By:  
NN

Drawing Date:  
October 10, 2023

Revisions:

revision	date	notes
1	12/13/23	Plan Check

**Evans Remodel**  
412 Flora Vista, Santa Barbara, CA


PROJECT:

Details


SHEET TITLE:

**A6**


DRAWING NUMBER:

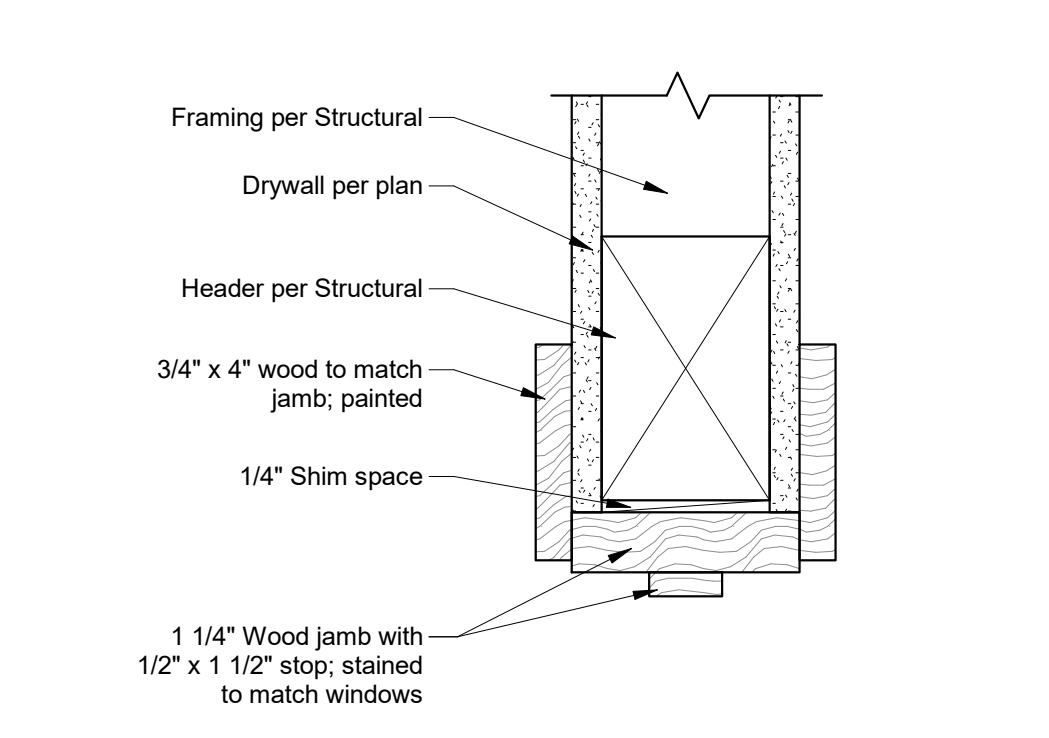


4 Section Detail - Door Jamb / Header  
3" = 1'-0"

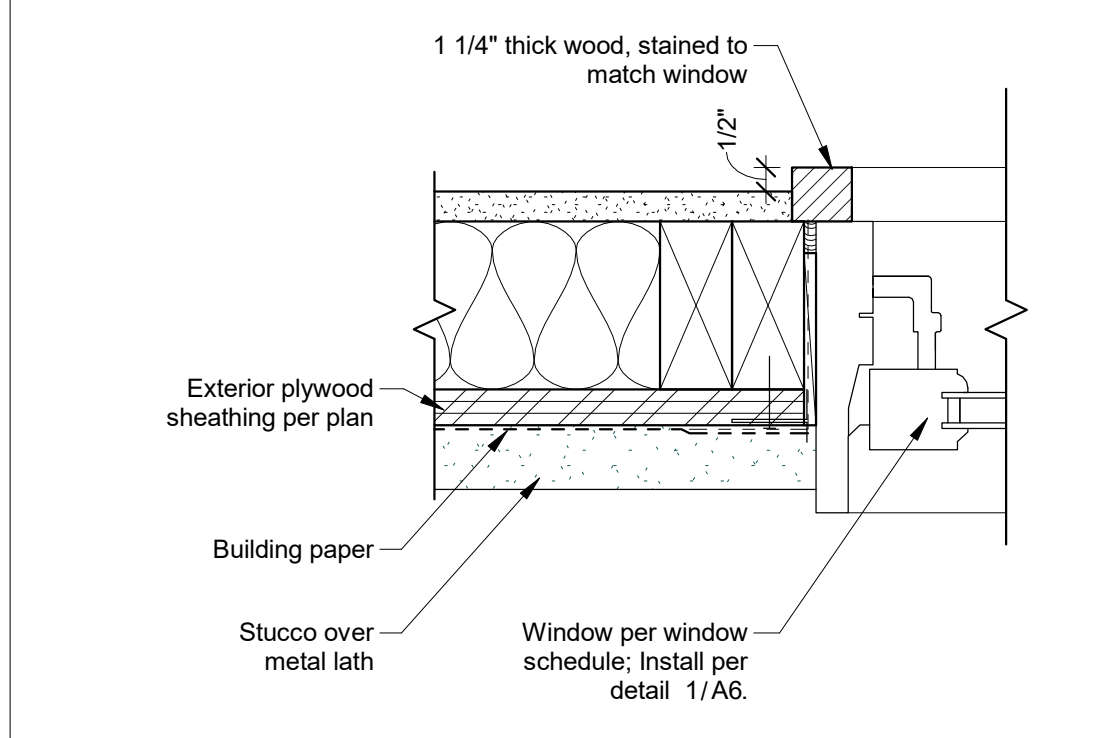


5 Section Detail - Typ. Window Jamb  
3" = 1'-0"

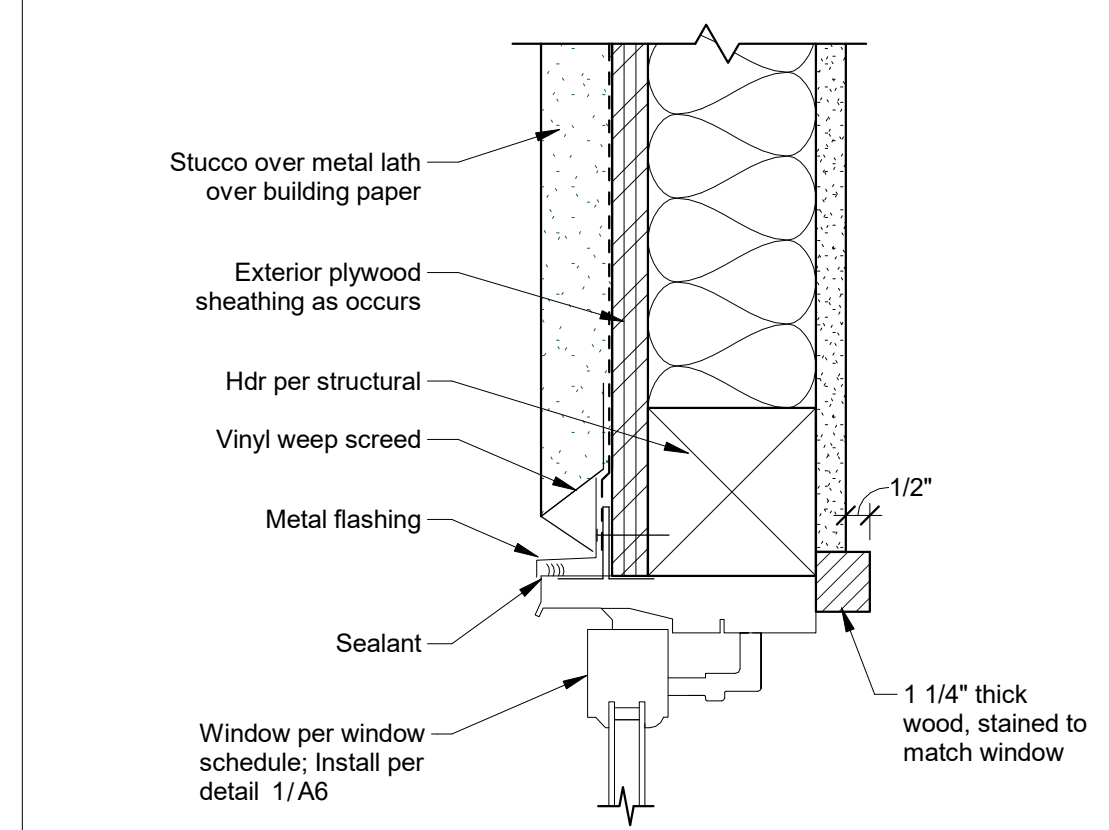


6 Section Detail - Typ. Window Head  
3" = 1'-0"

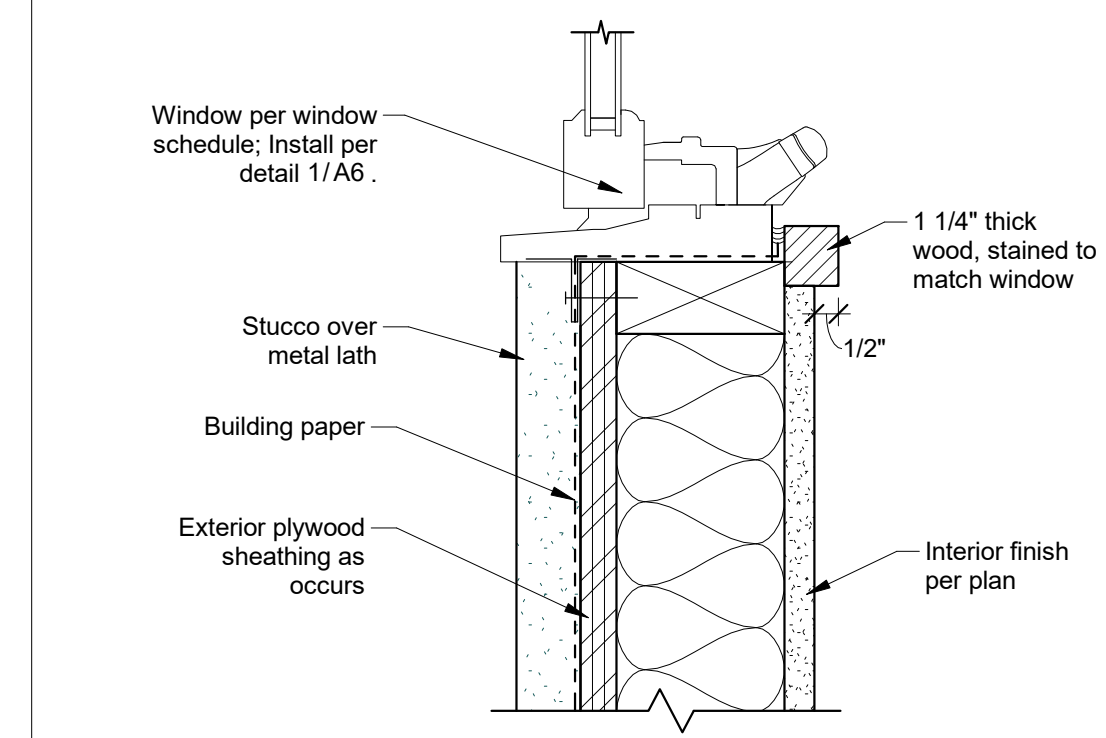


7 Section Detail - Typ. Window Sill  
3" = 1'-0"

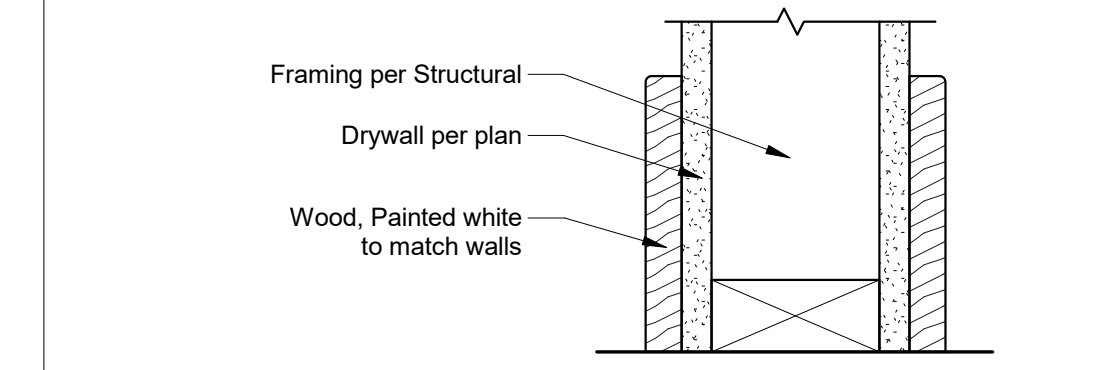


8 Section Detail - Typ. Baseboard  
3" = 1'-0"

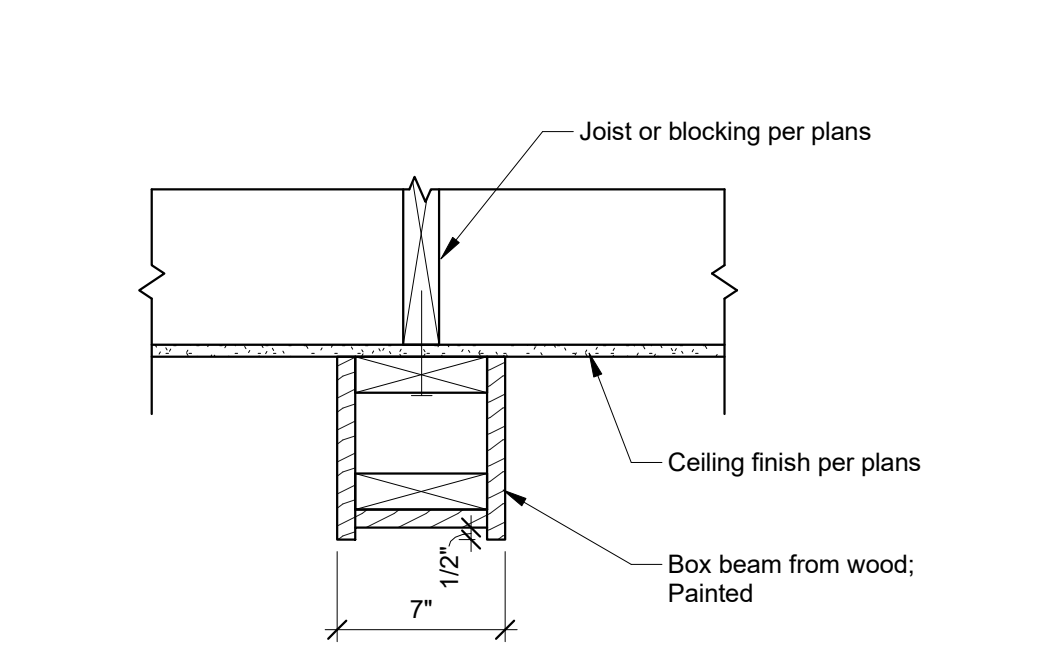


9 Section Detail - Decorative Ceiling Beam  
1 1/2" = 1'-0"

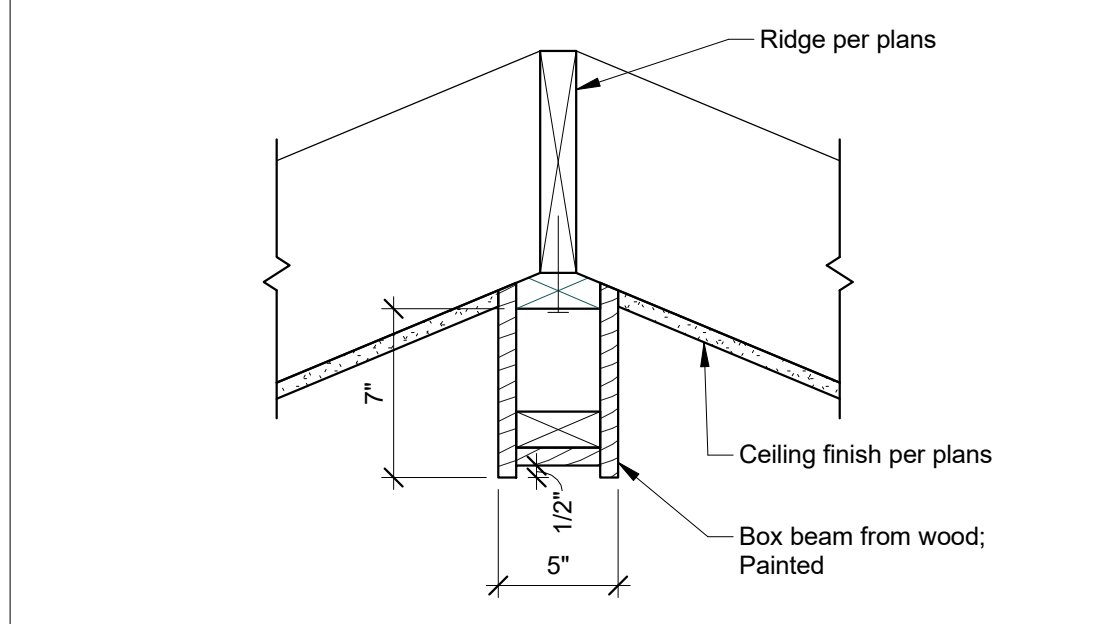


10 Section Detail - Decorative Ridge Beam  
1 1/2" = 1'-0"

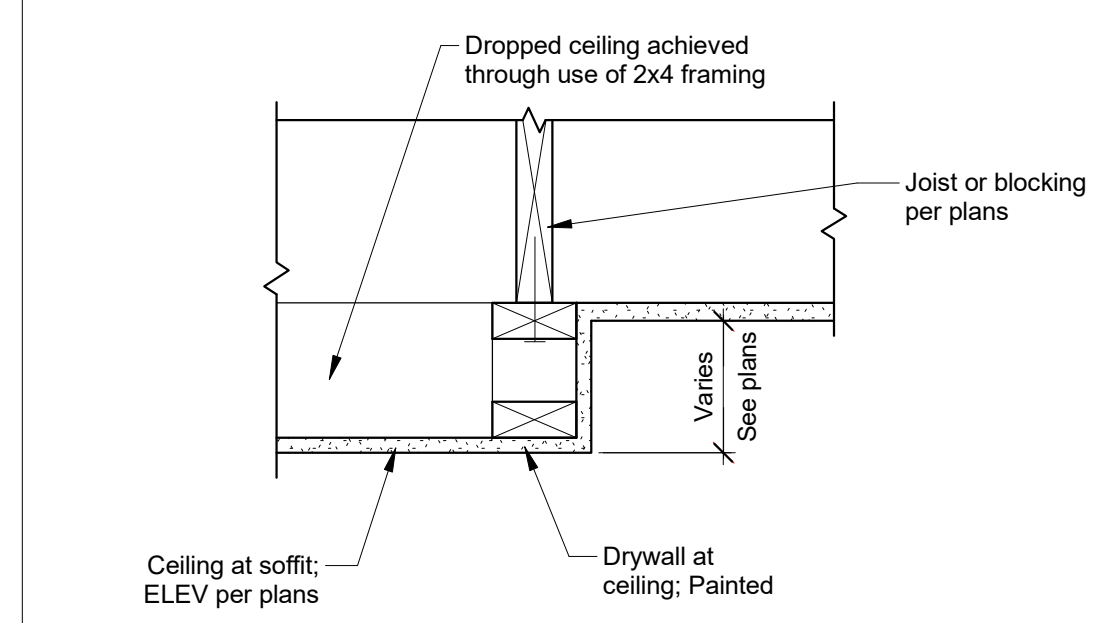


11 Section Detail - Typ. Soffit  
1 1/2" = 1'-0"

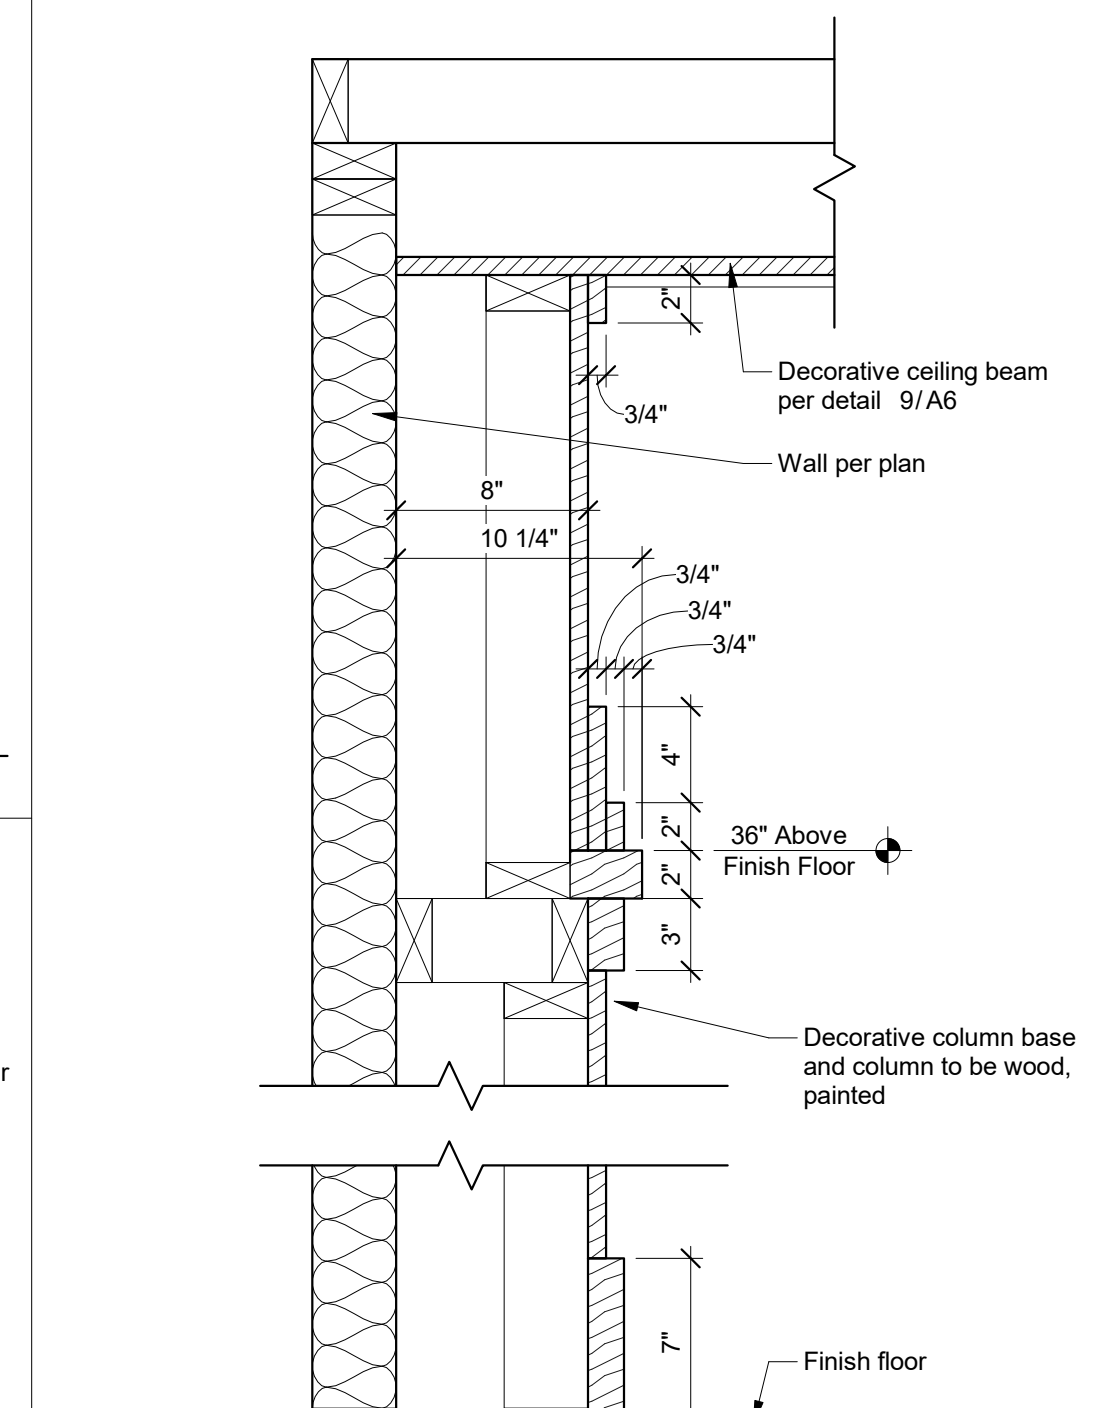


15 Section Detail - Int. Column  
1 1/2" = 1'-0"

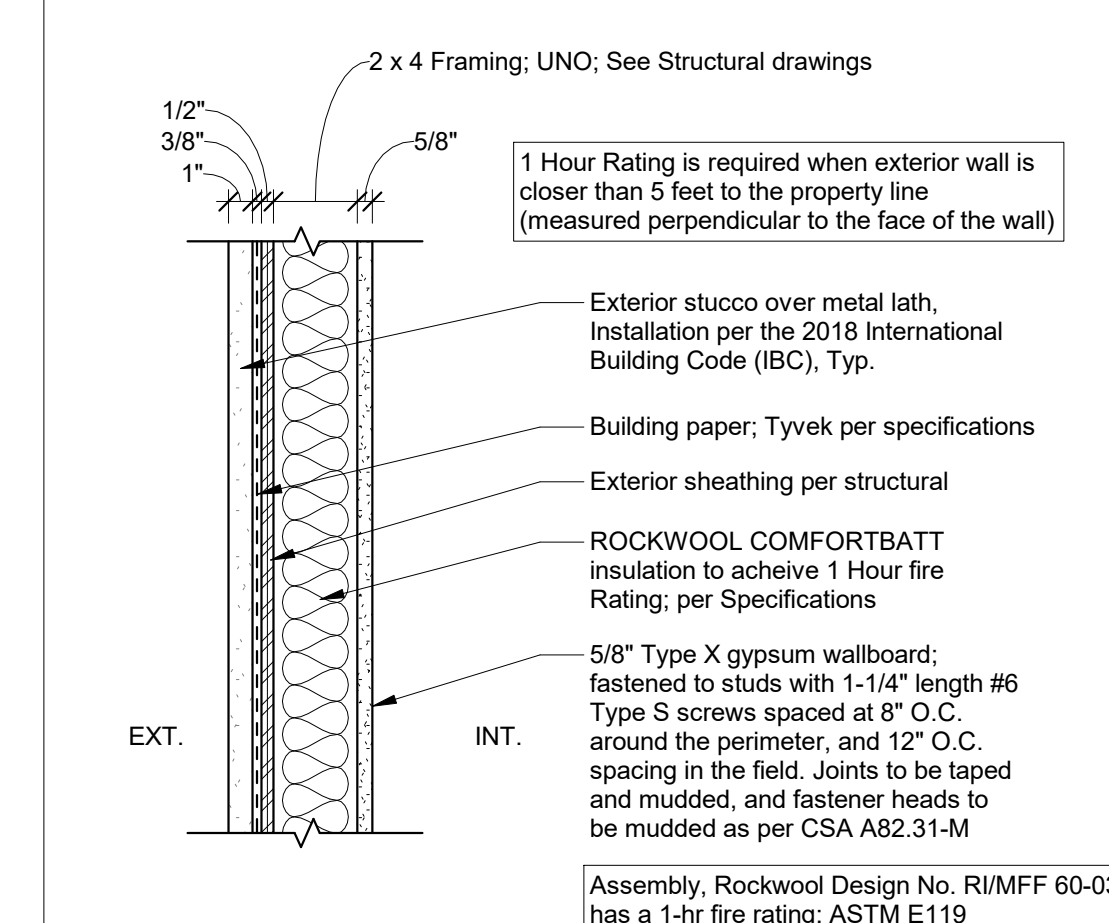


16 Section Detail - 1 HR Wall  
1 1/2" = 1'-0"

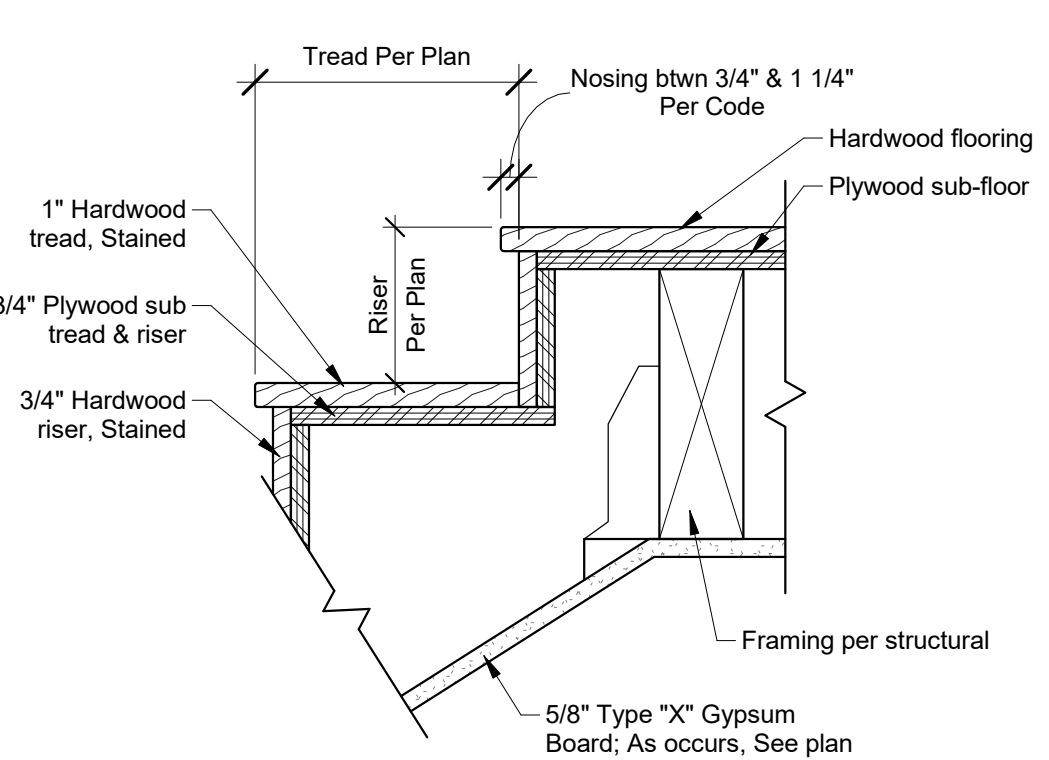

12 Section Detail - Typ. Stair Tread & Riser  
1 1/2" = 1'-0"

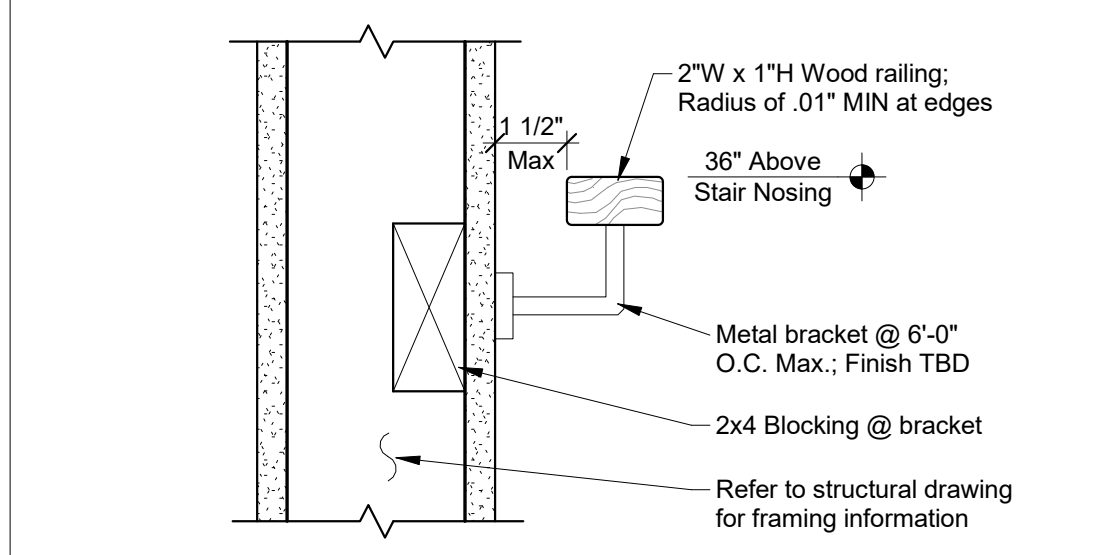

13 Section Detail - Handrail  
3" = 1'-0"

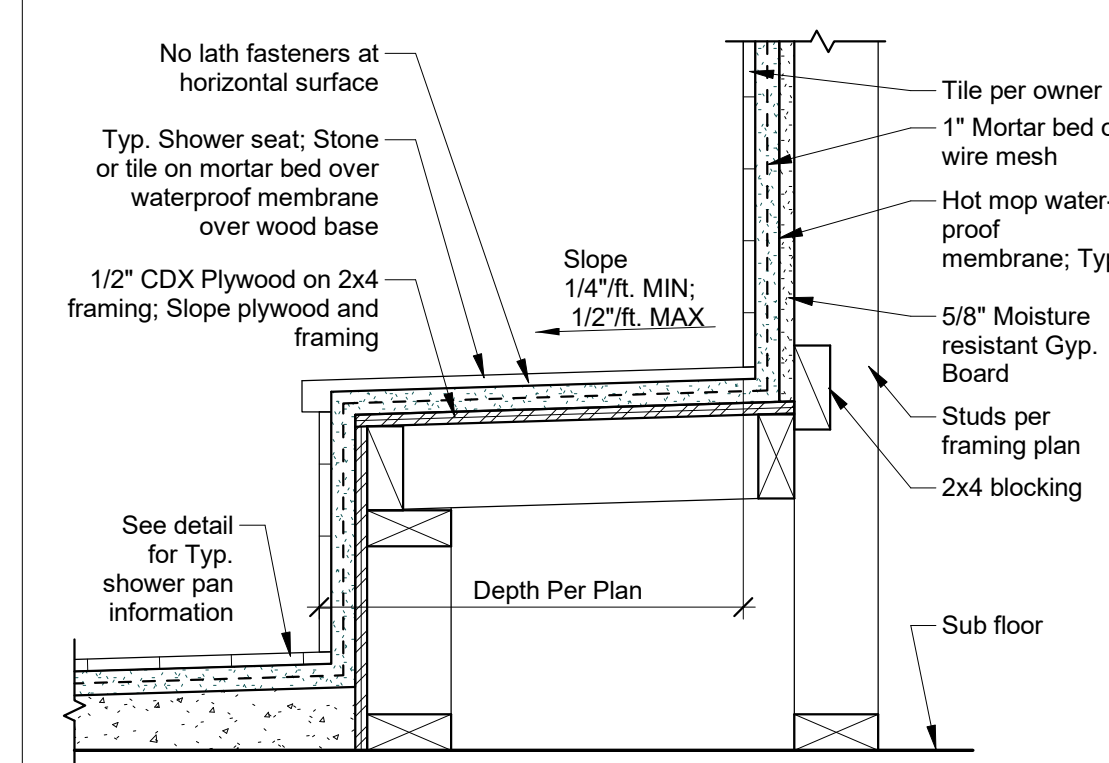

14 Section Detail - Shower Seat / Shelf  
1 1/2" = 1'-0"



Drawn By:  
 NN

Drawing Date:  
 October 10, 2023


Revisions:

revision	date	notes


**Evans Remodel**  
 412 Flora Vista, Santa Barbara, CA

**Interior Elevations**


**A7**

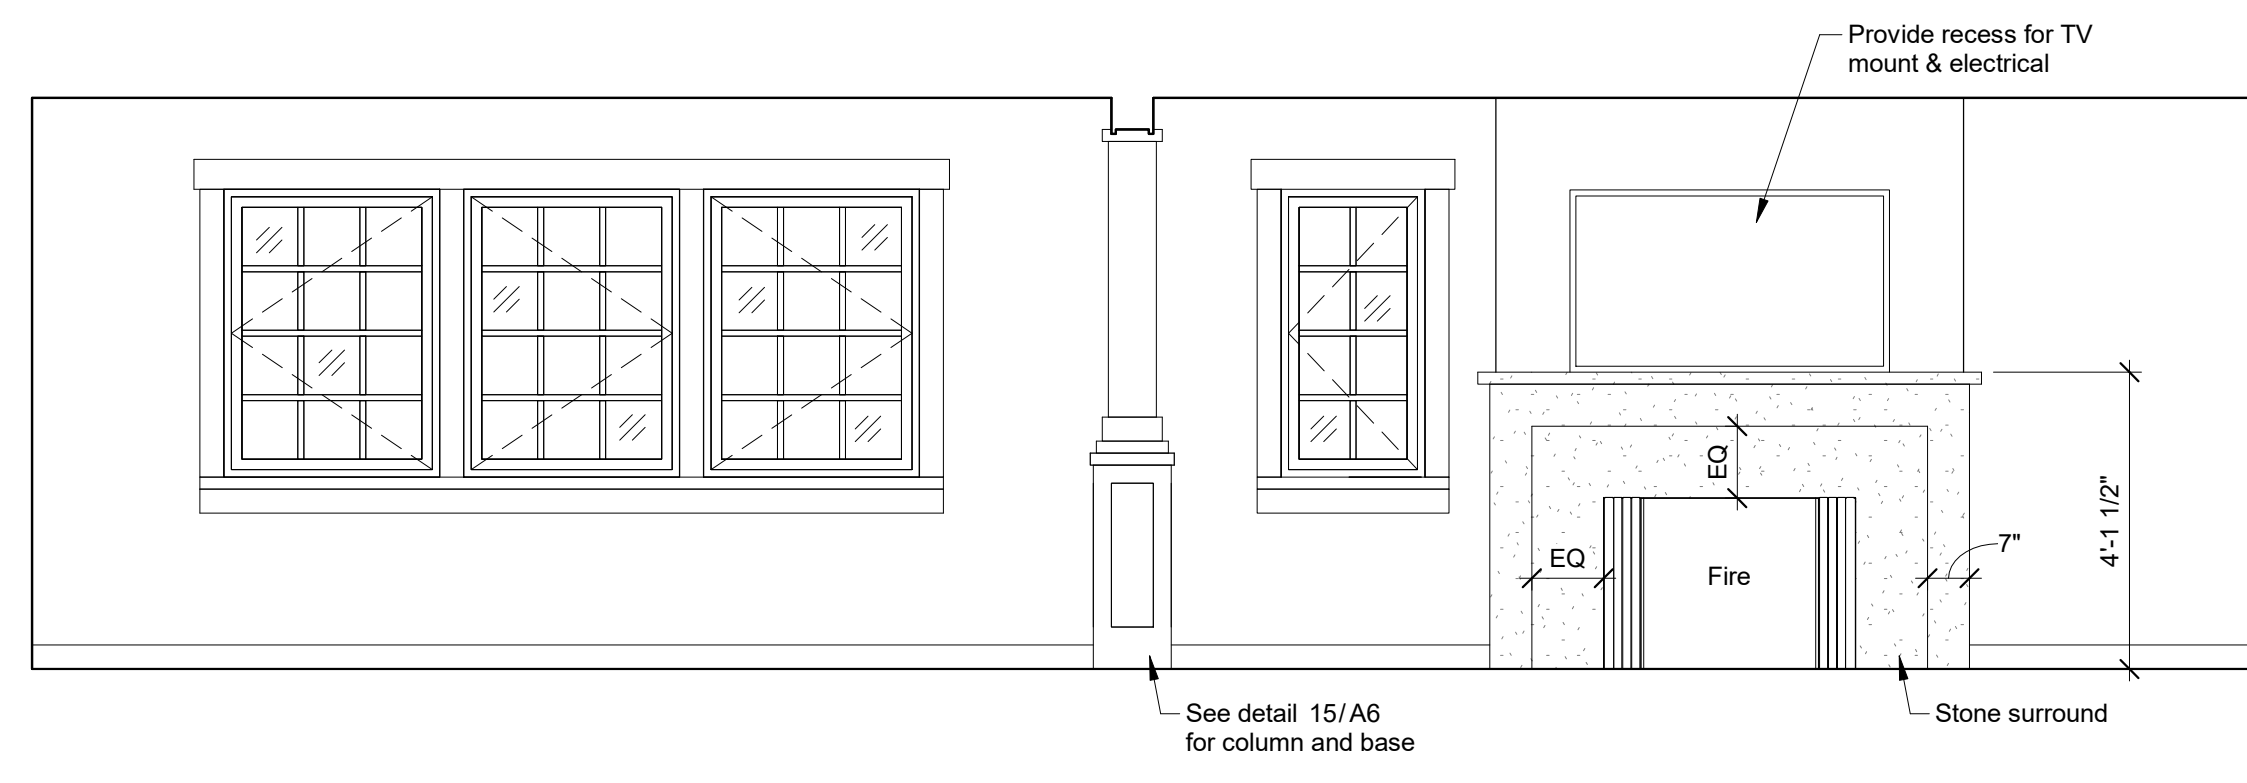


**1 Fireplace & Dining**  
 3/8" = 1'-0"

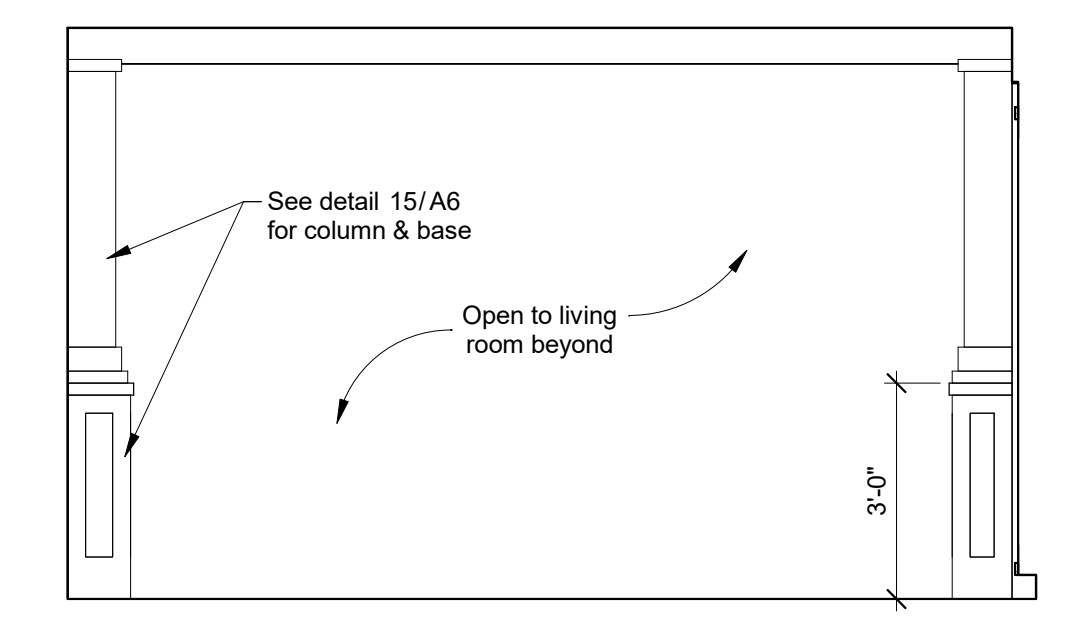


**2 Posts & Beam**  
 3/8" = 1'-0"

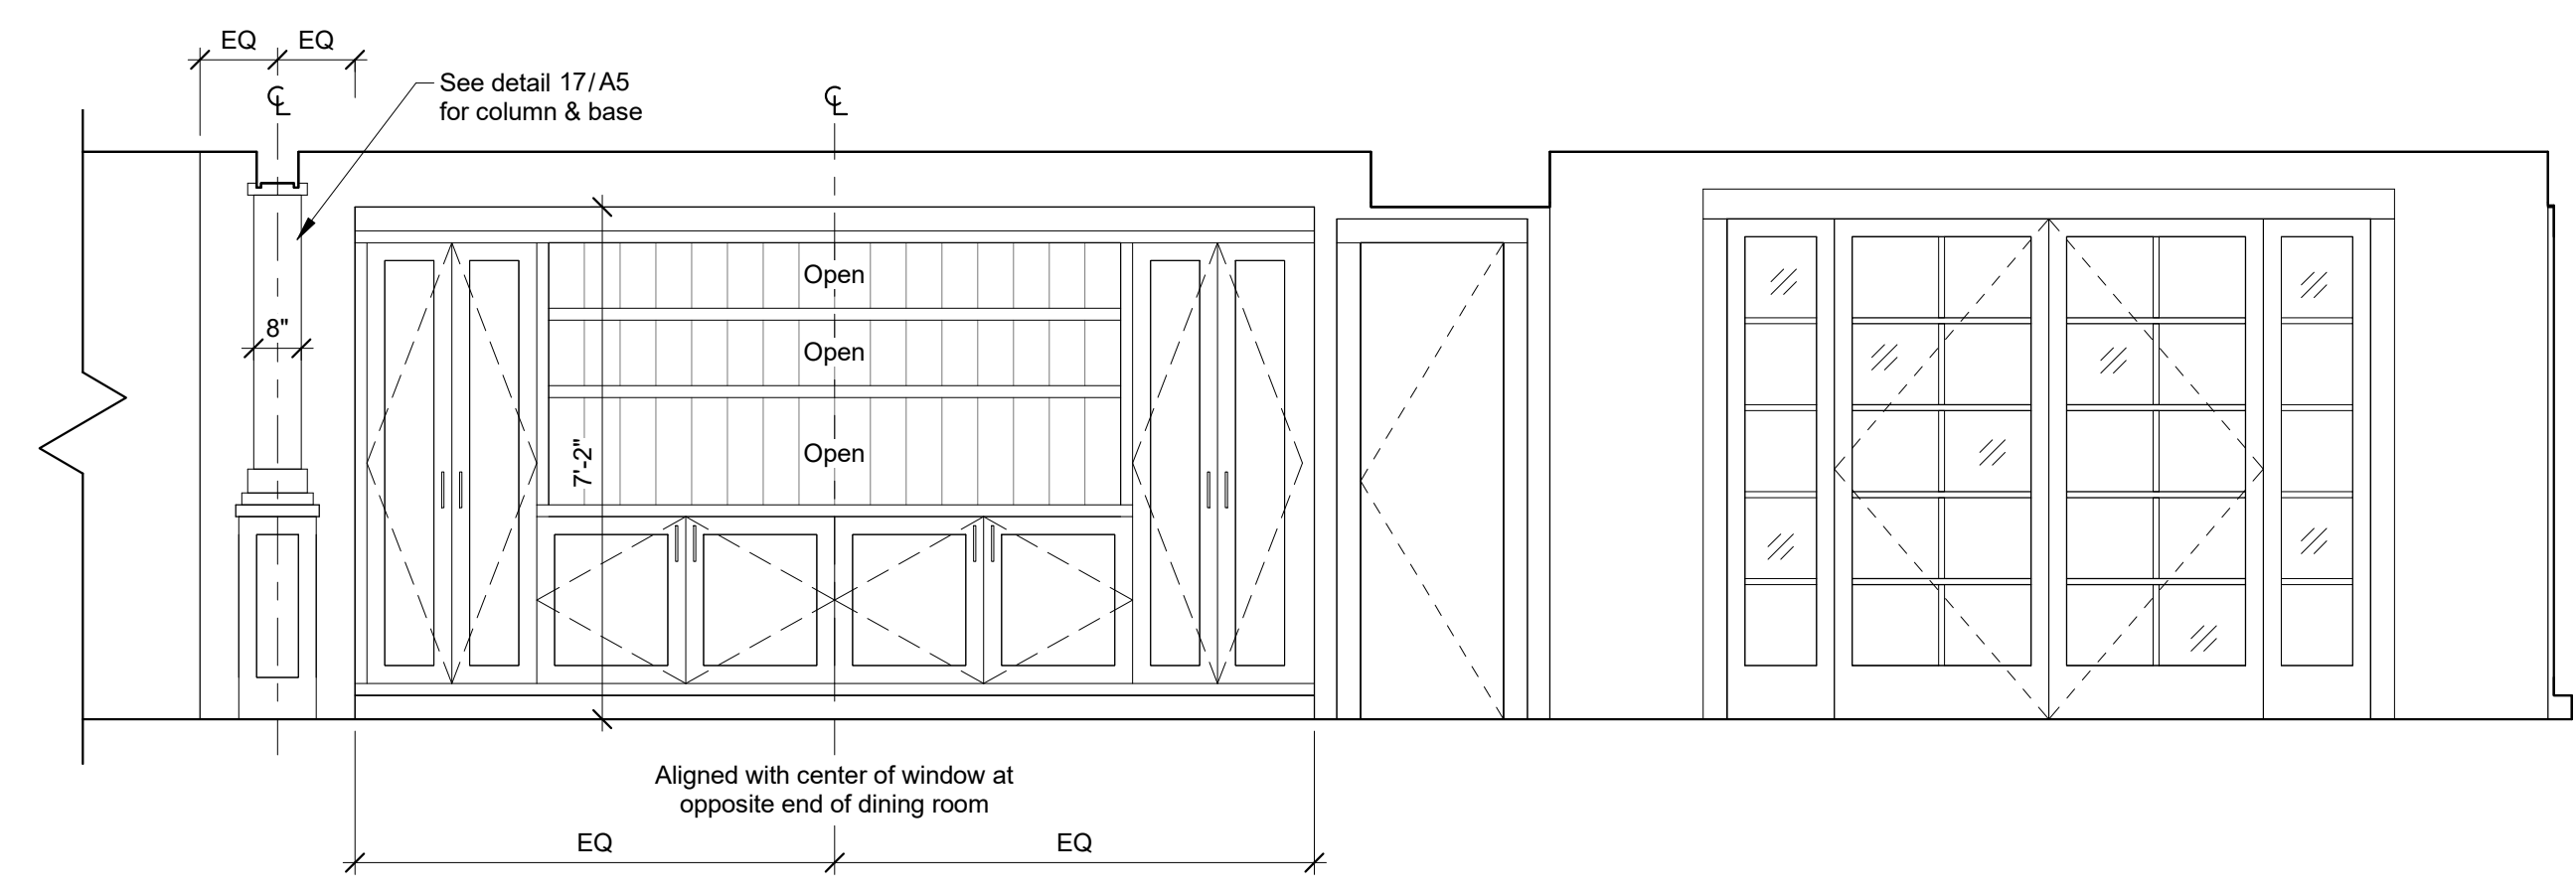


**3 Dining Cabinetry**  
 3/8" = 1'-0"

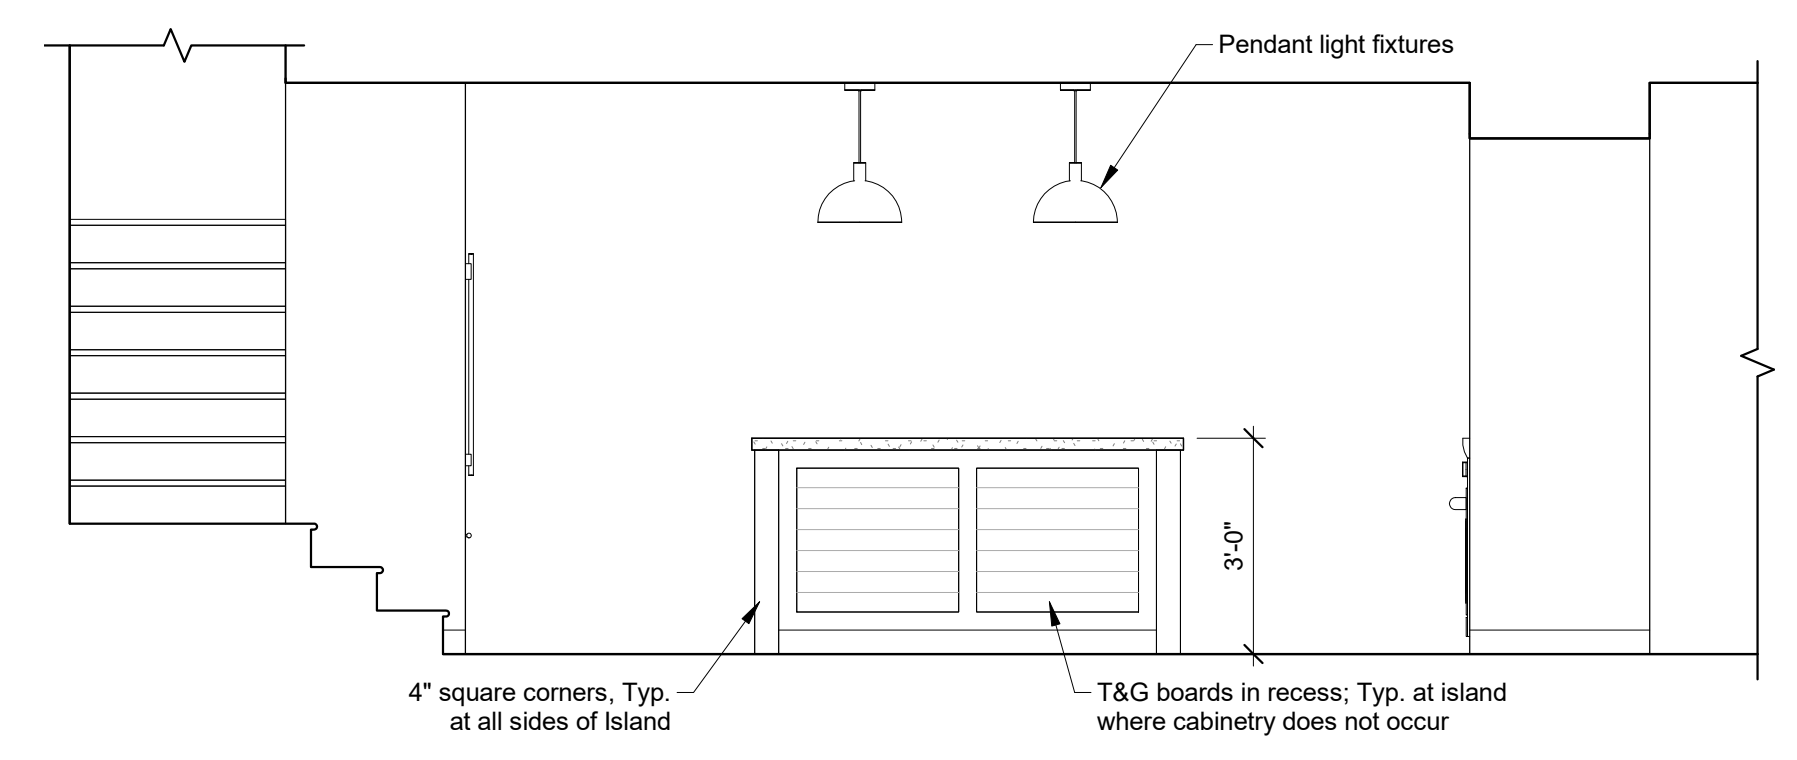

**4 Island**  
 3/8" = 1'-0"

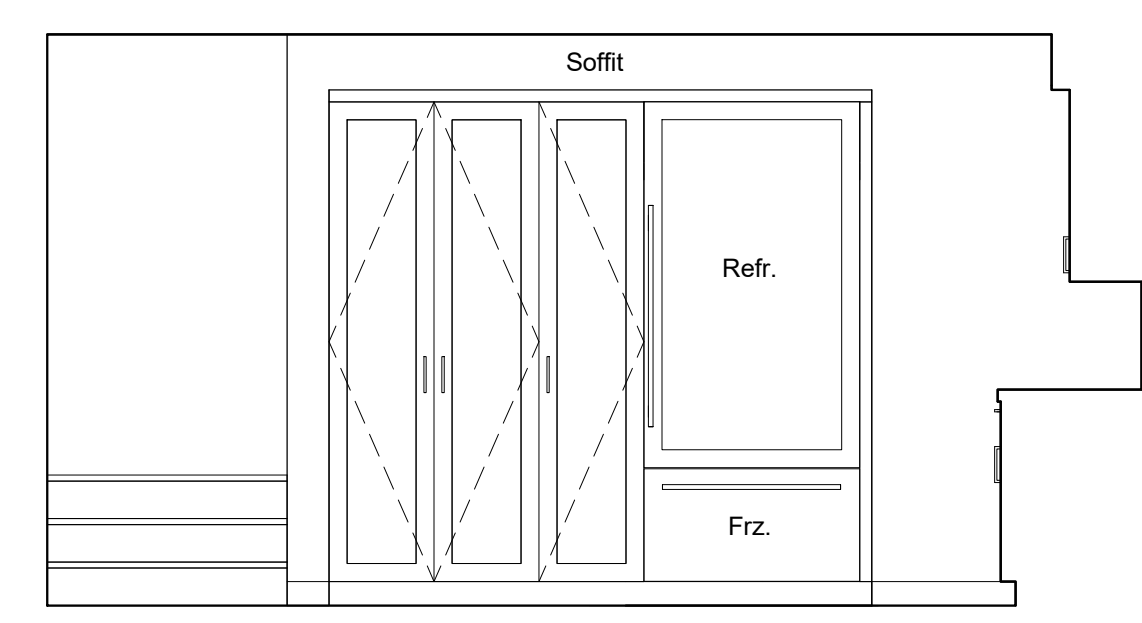


**5 Kitchen**  
 3/8" = 1'-0"

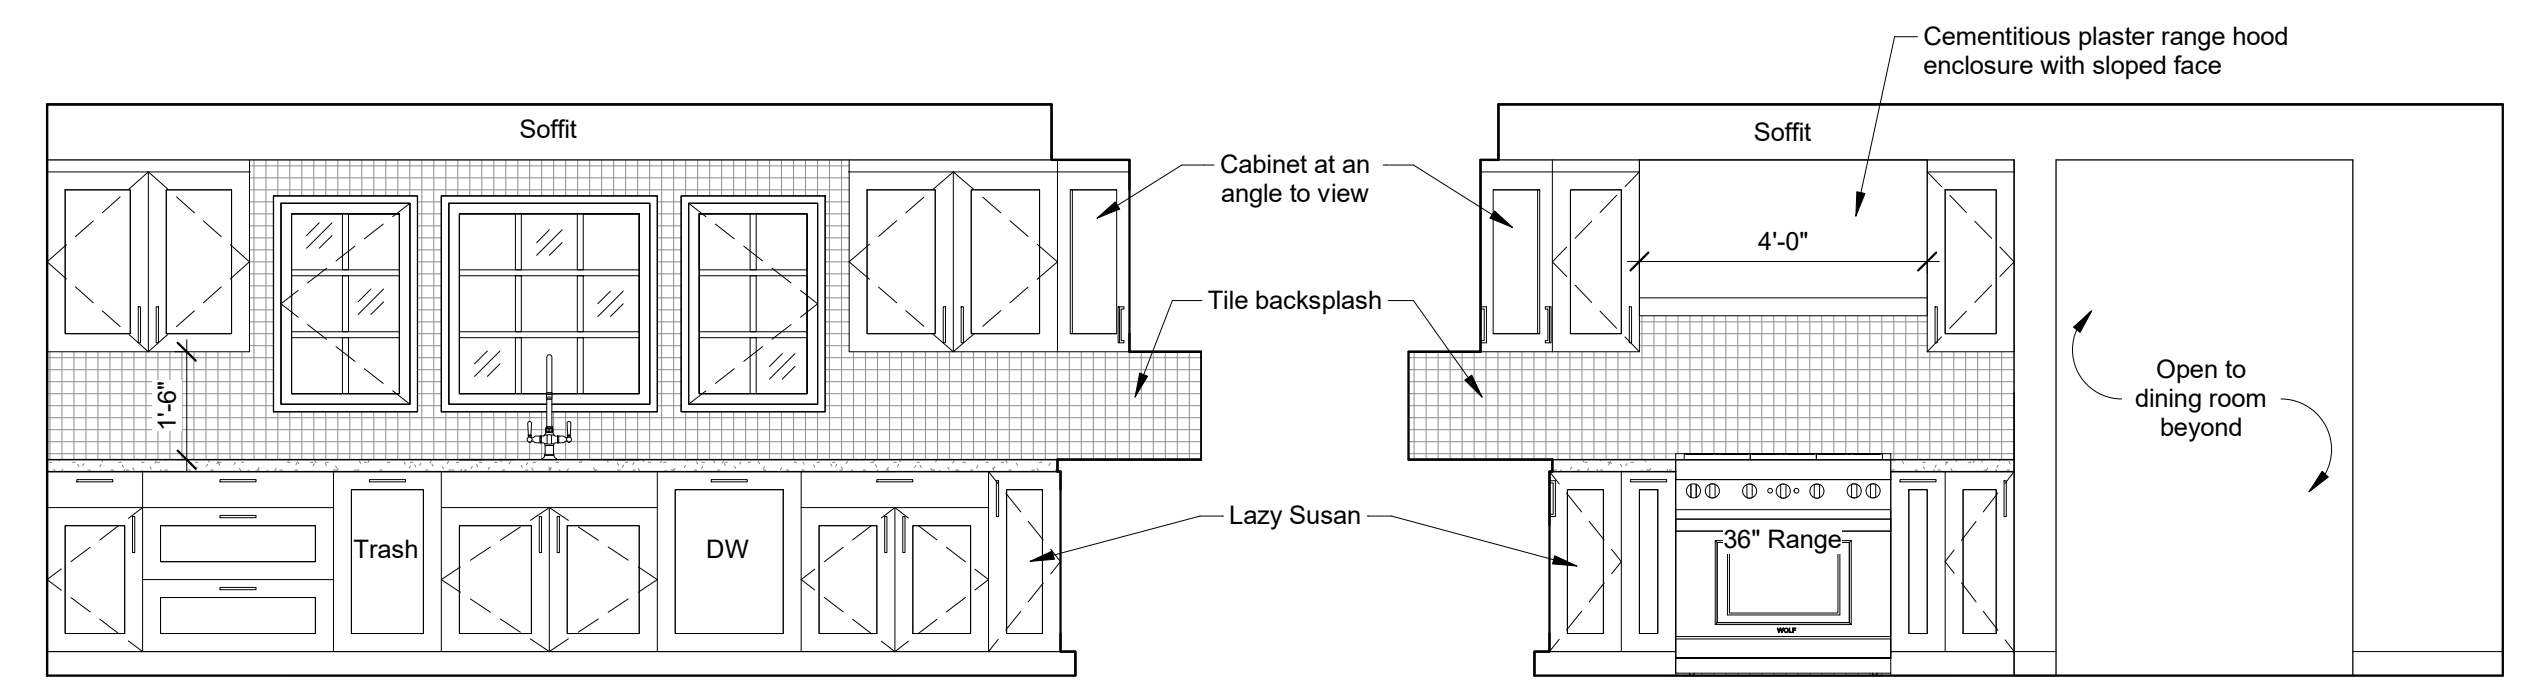


**6 Kitchen**  
 3/8" = 1'-0"


**7 Kitchen**  
 3/8" = 1'-0"

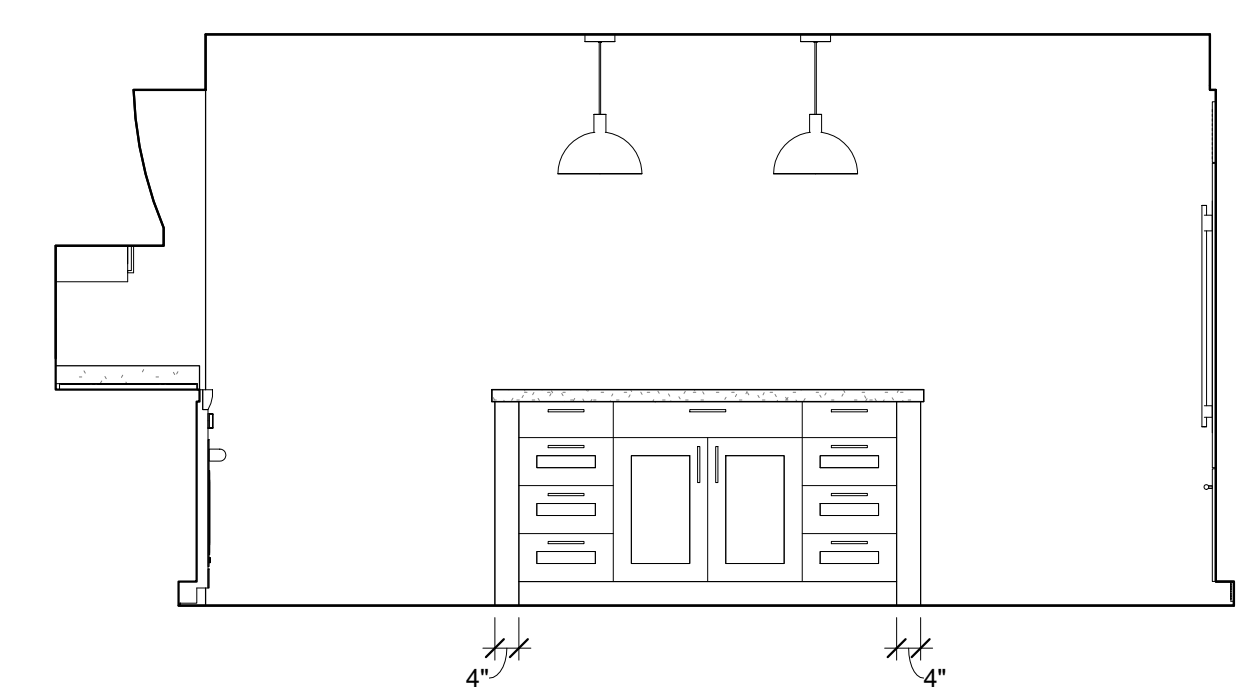

**8 Island**  
 3/8" = 1'-0"

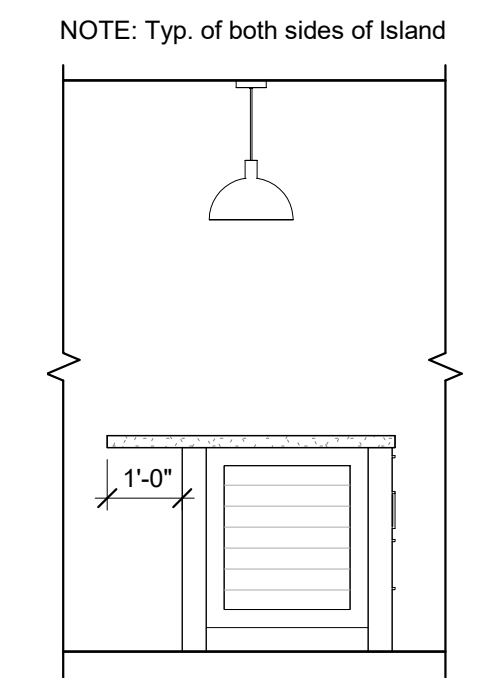

**9 Island**  
 3/8" = 1'-0"

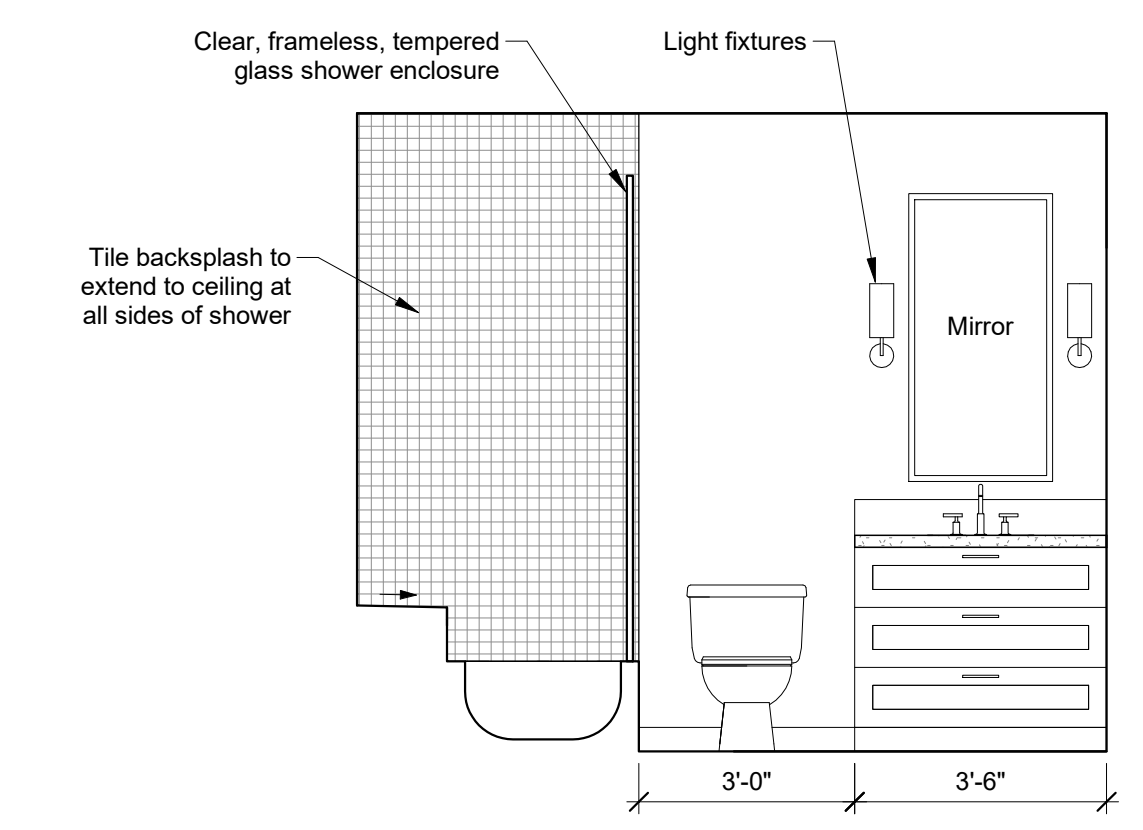

**10 Primary Bath**  
 3/8" = 1'-0"

PROJECT:

SHEET TITLE:

DRAWING NUMBER:






*Handwritten signature*

Drawn By:  
 NN

Drawing Date:  
 October 10, 2023

Revisions:

revision	date	notes

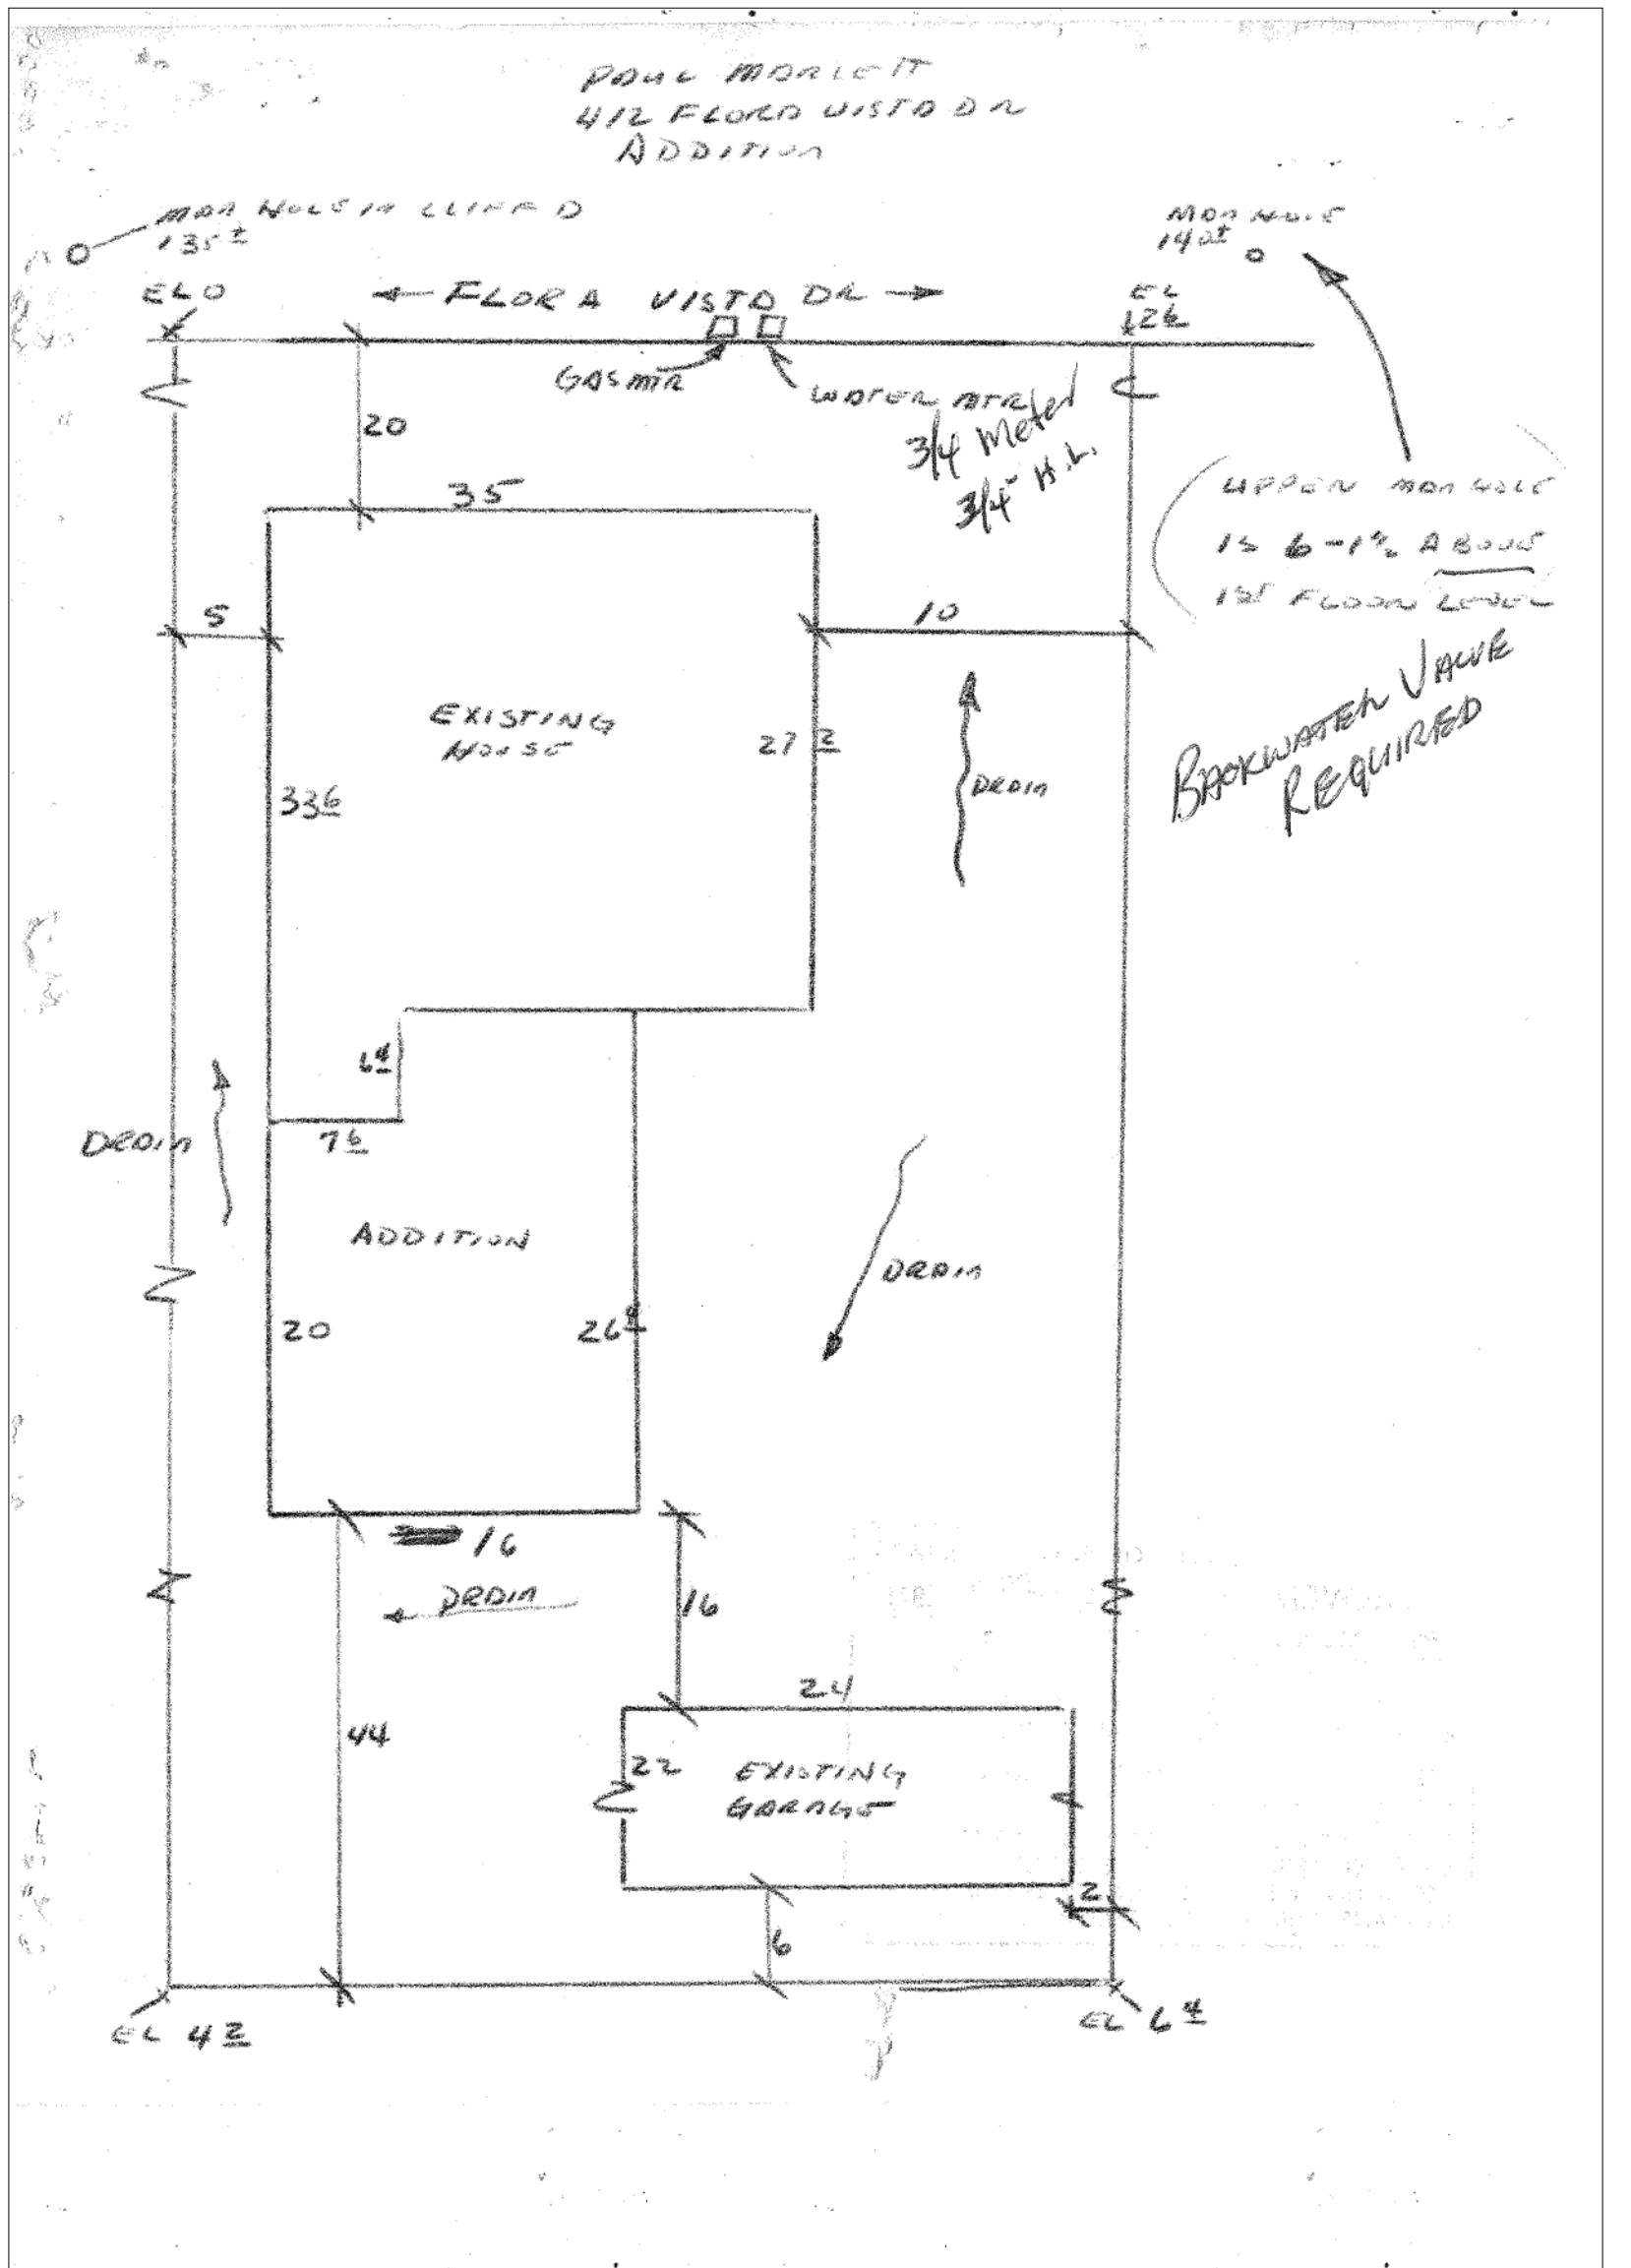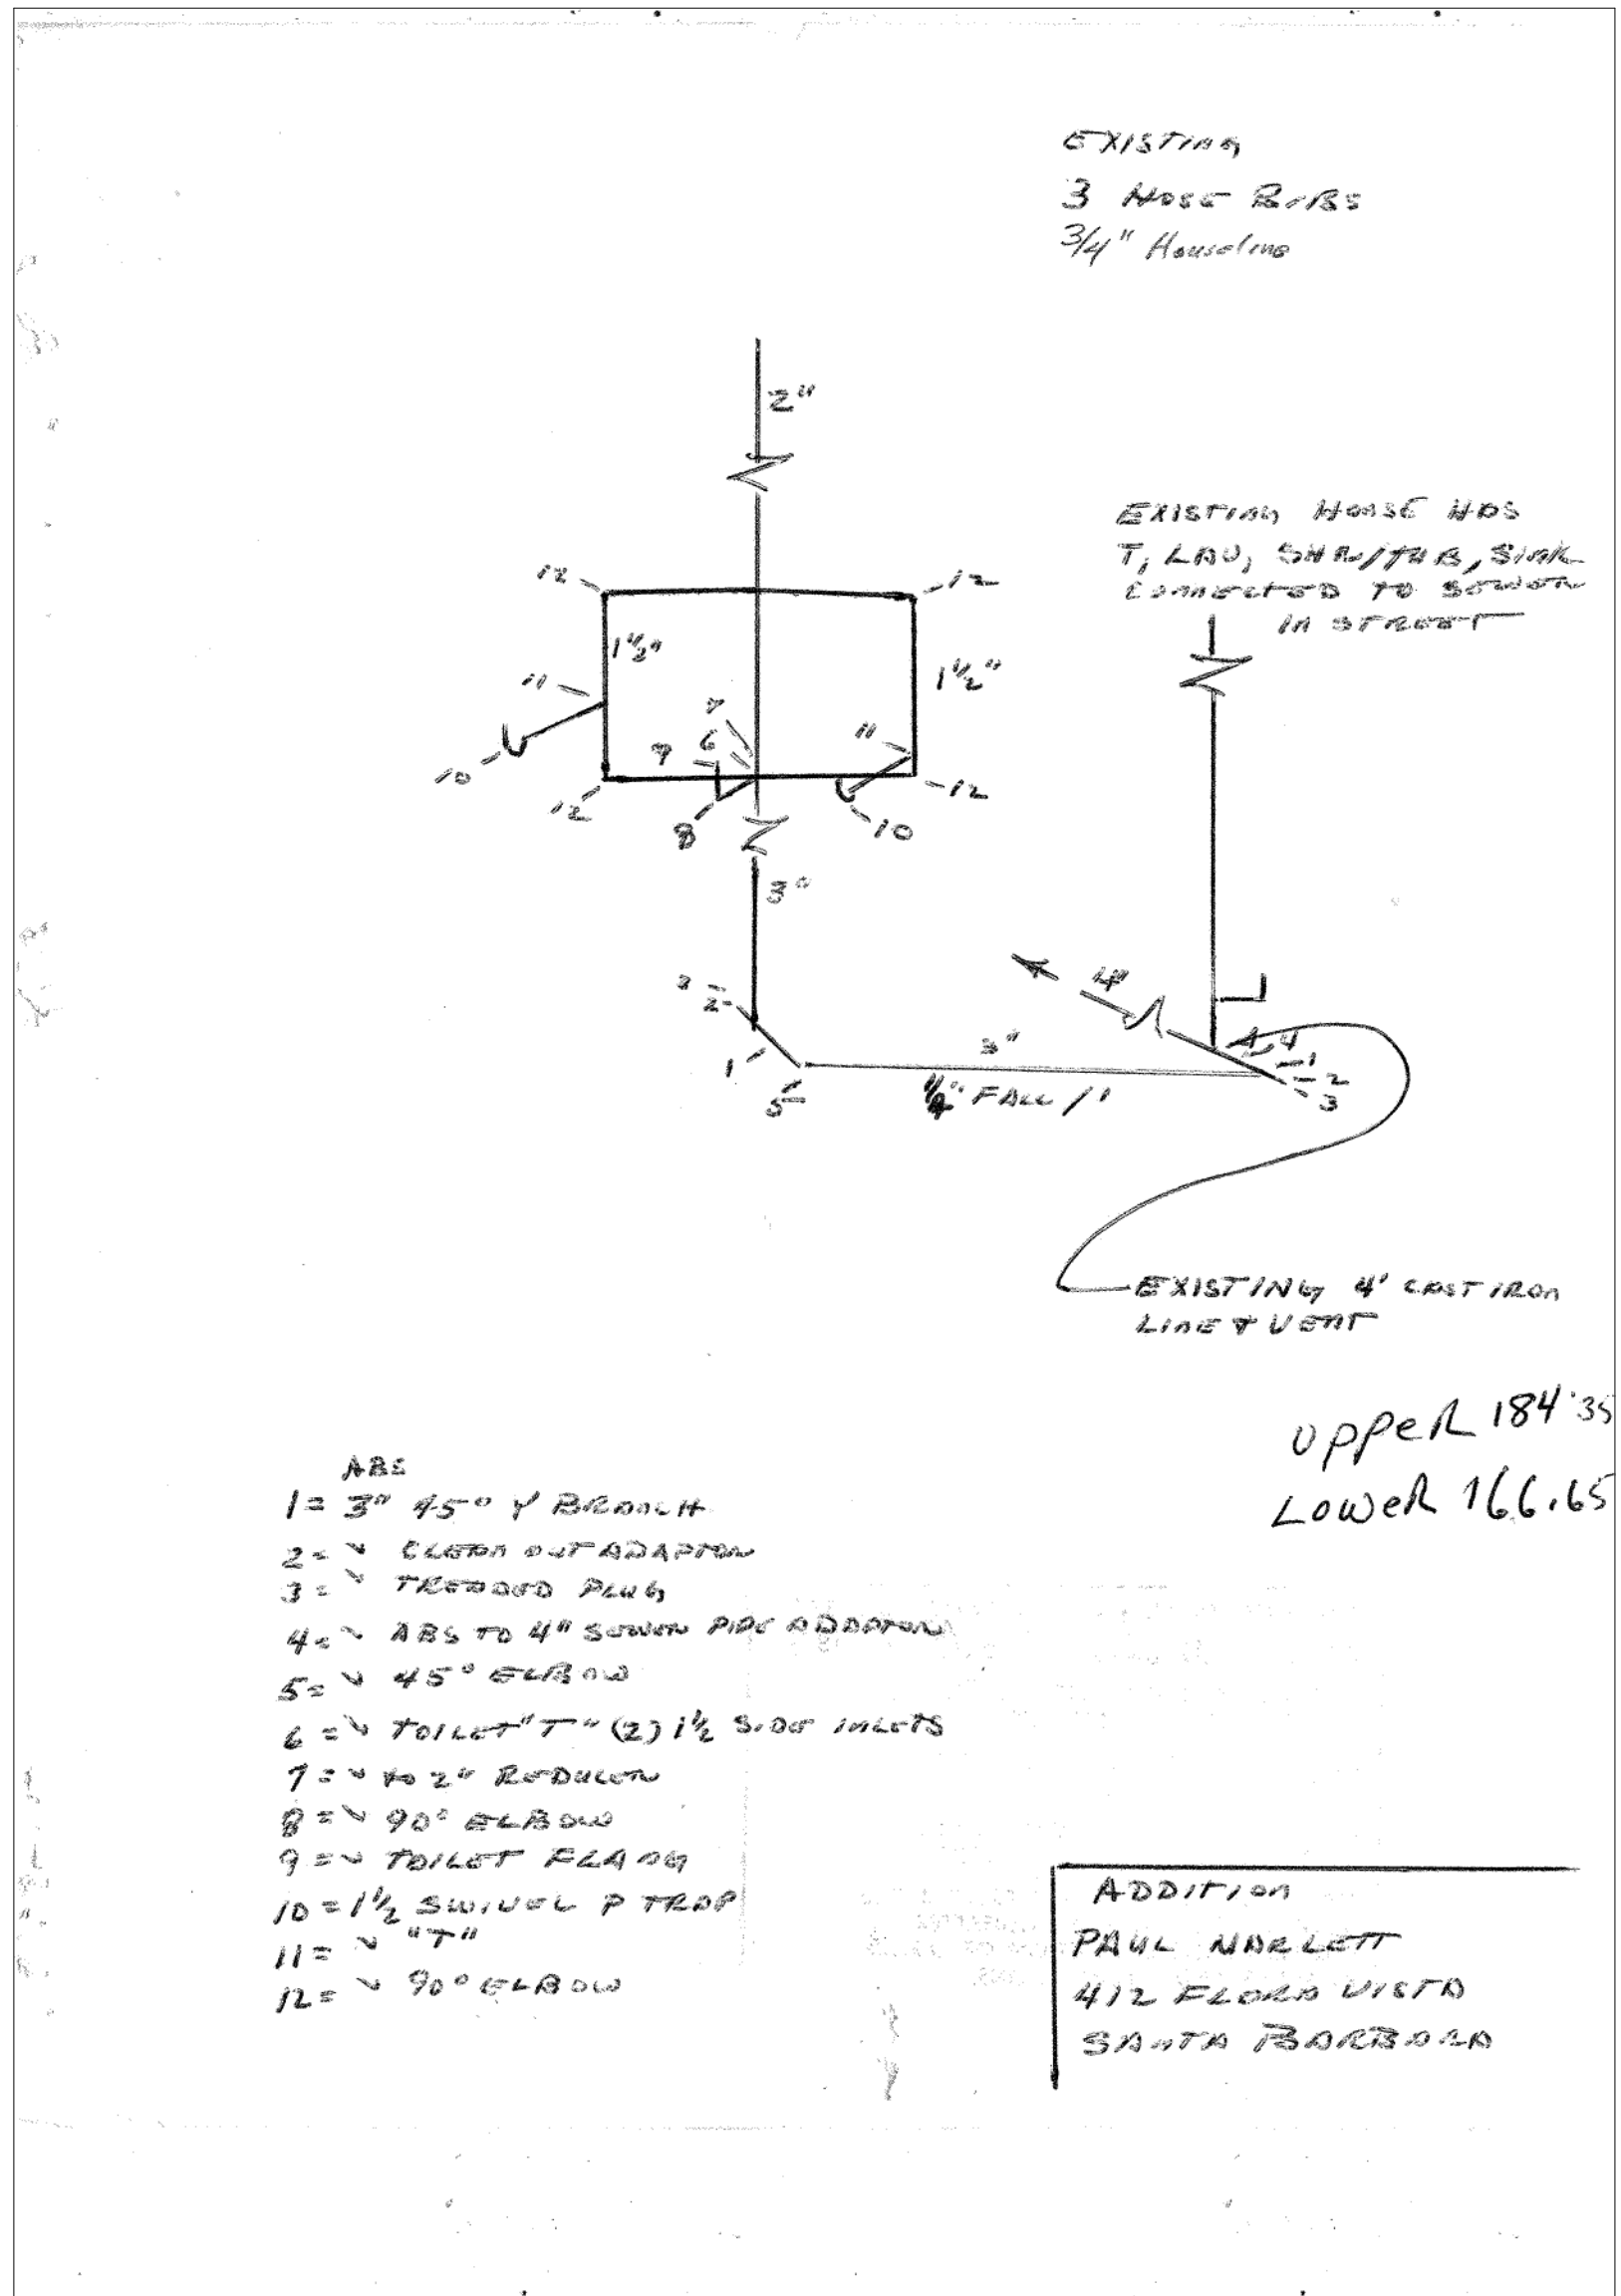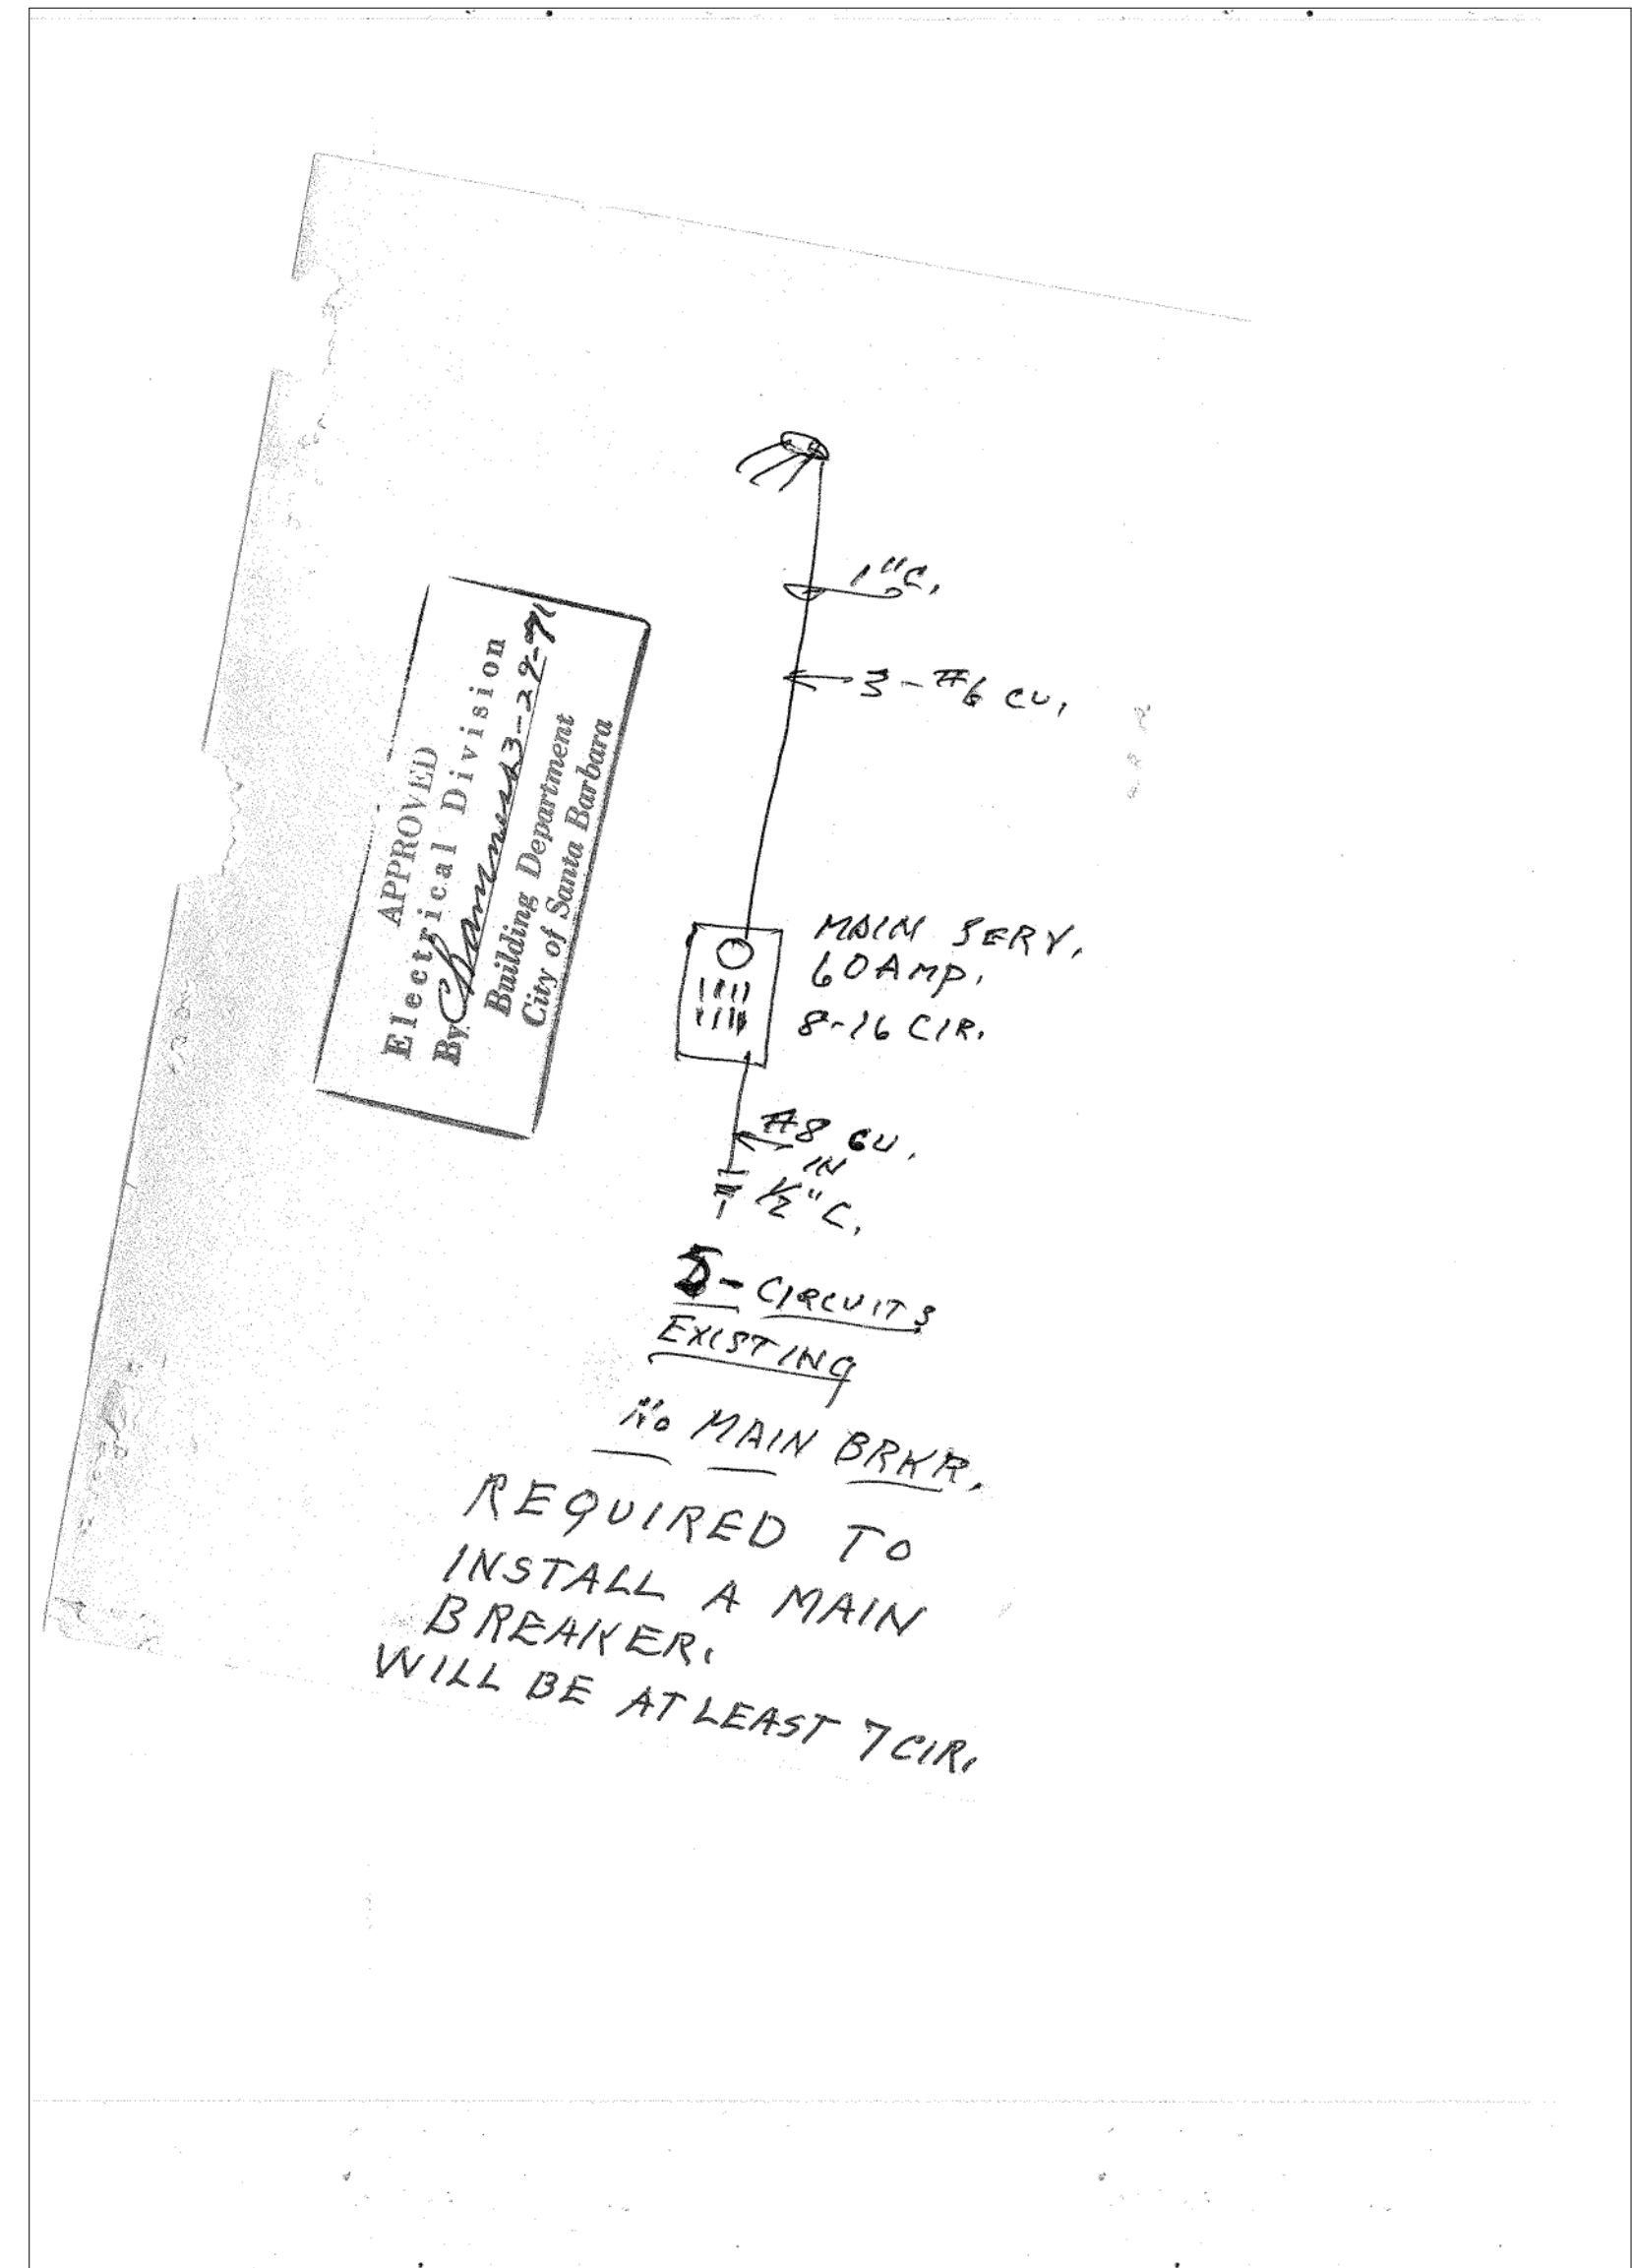

Evans Remodel  
 412 Flora Vista, Santa Barbara, CA

Existing Plans


A8.1

DRAWING NUMBER: SHEET TITLE: PROJECT:










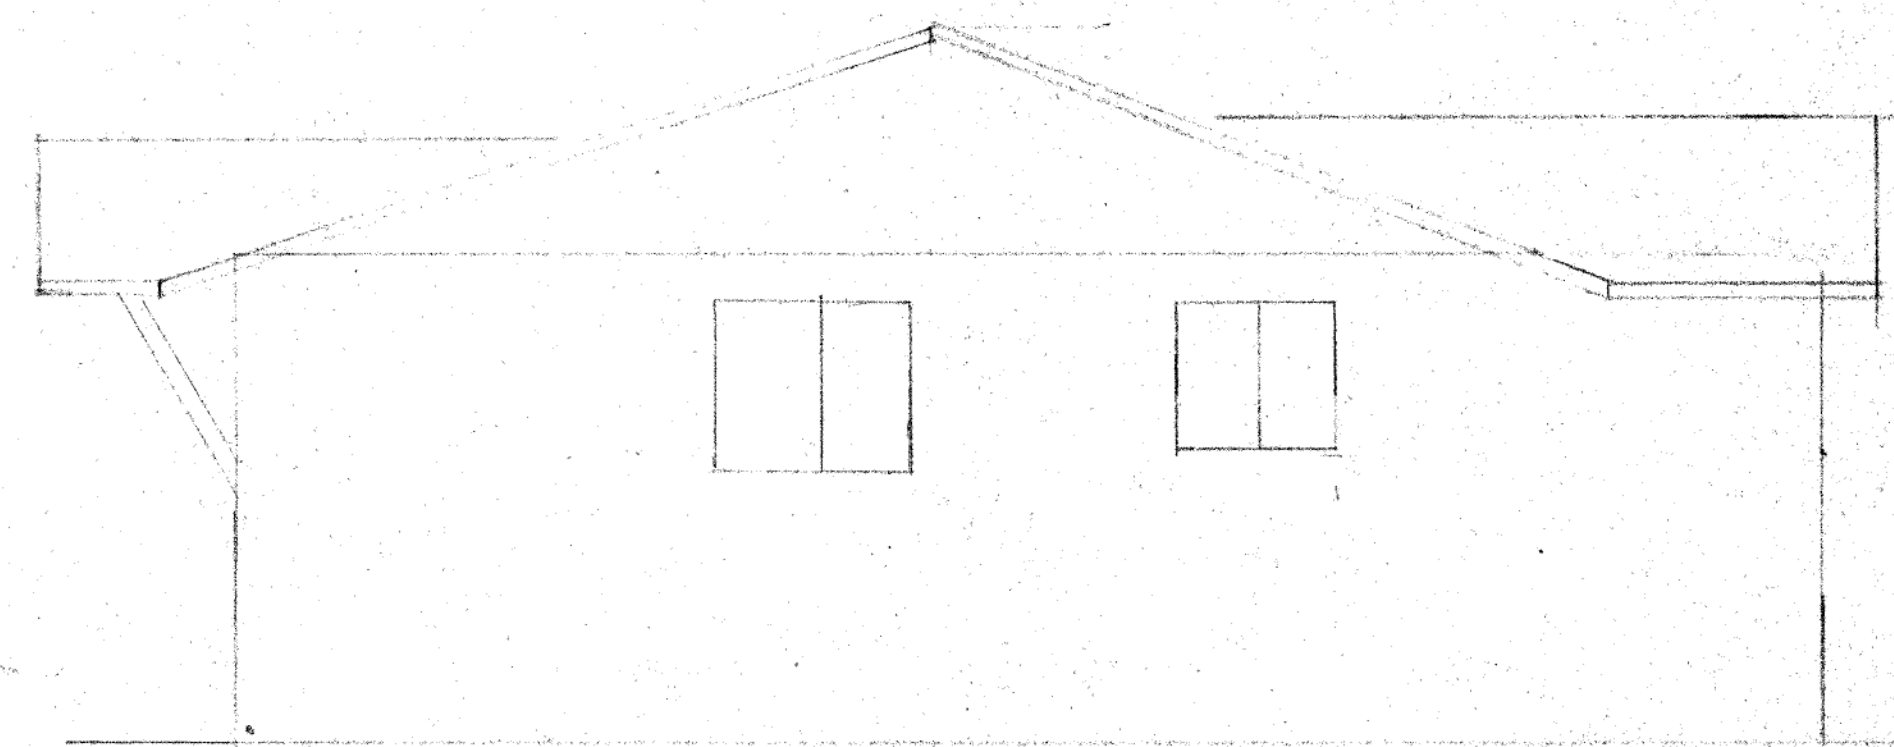

North Elevation

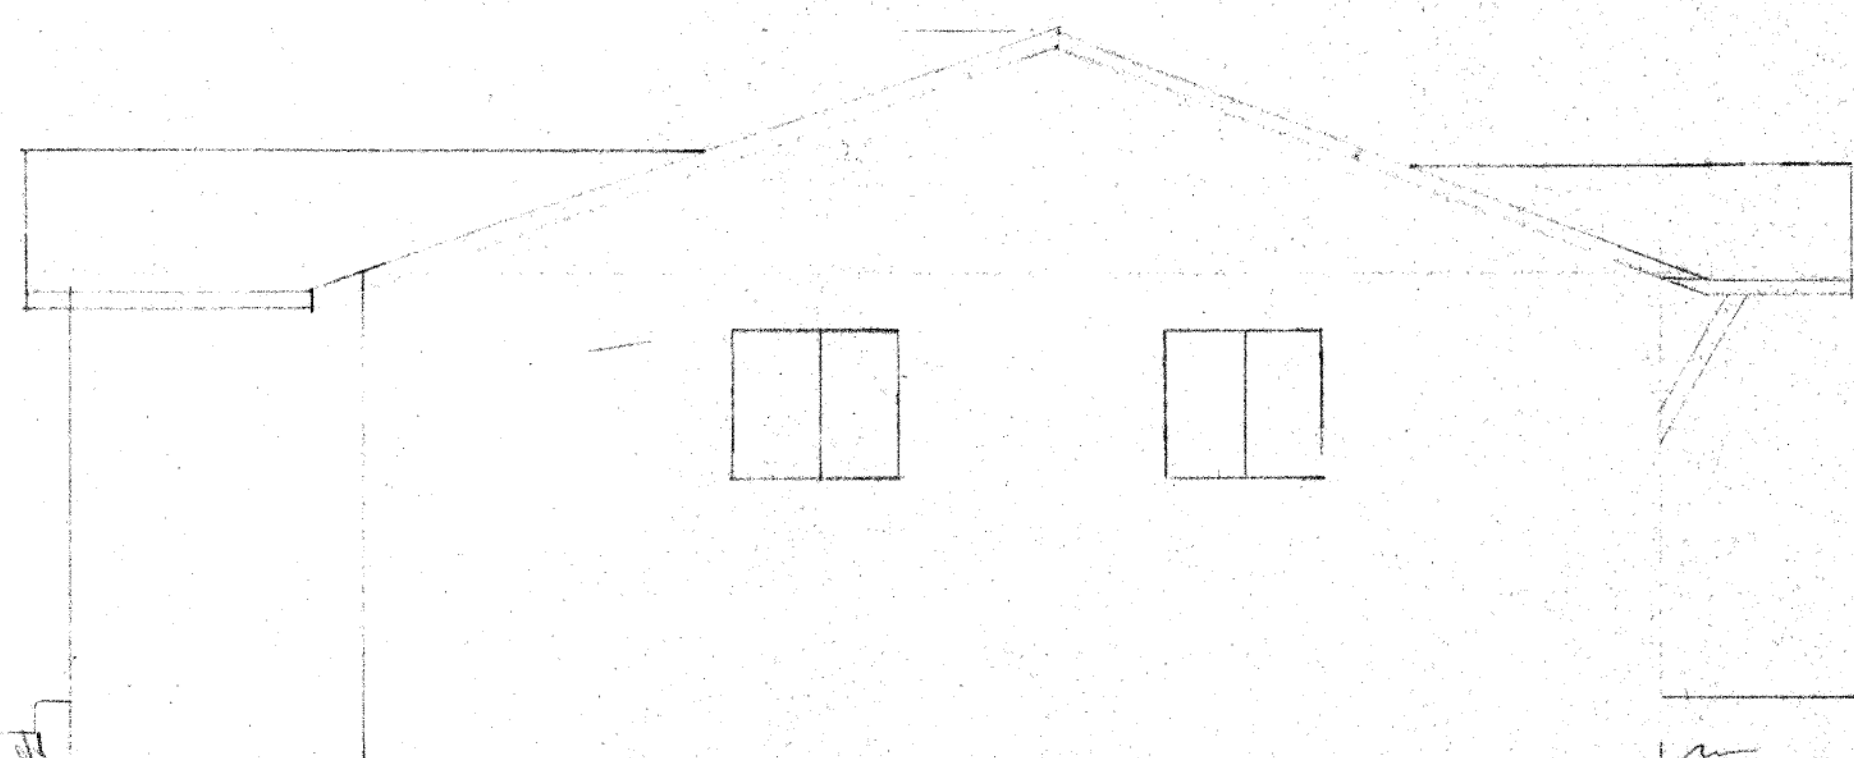


South Elevation

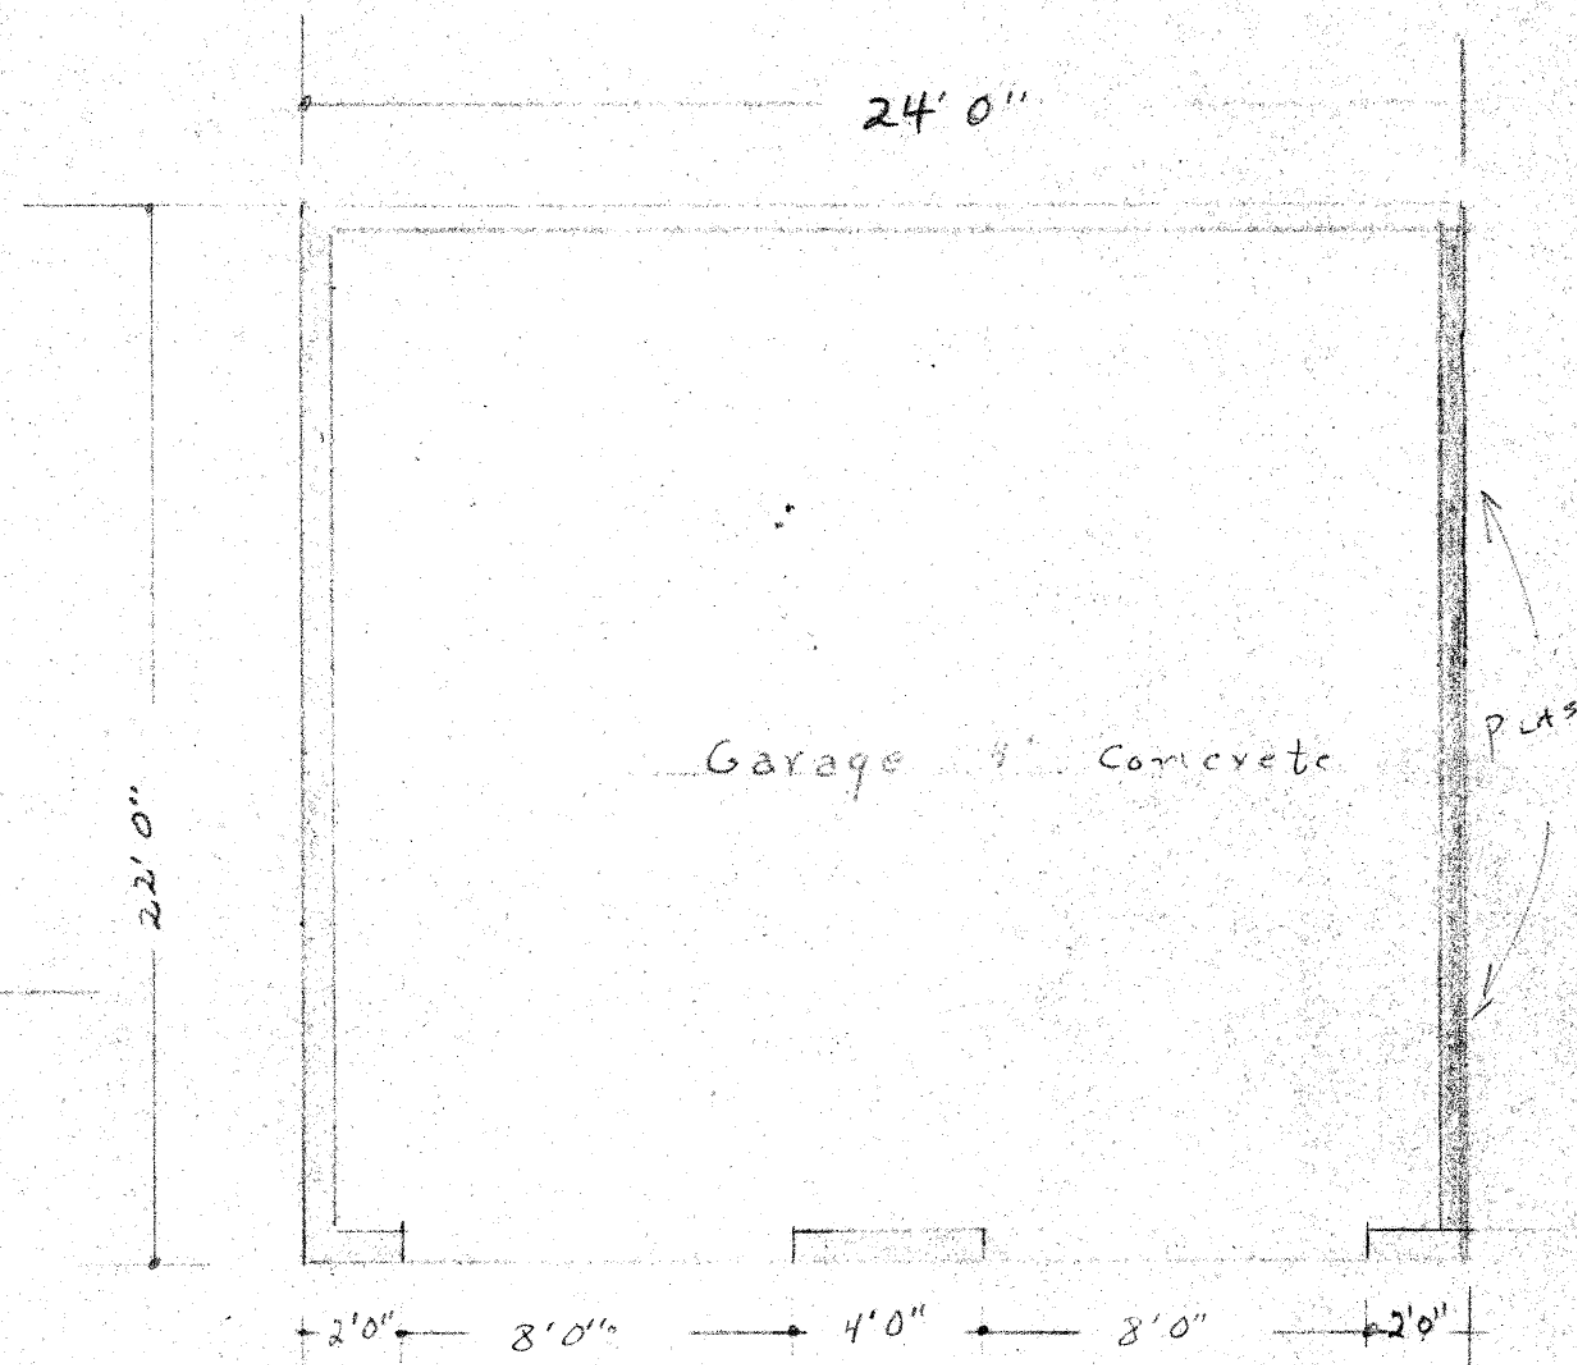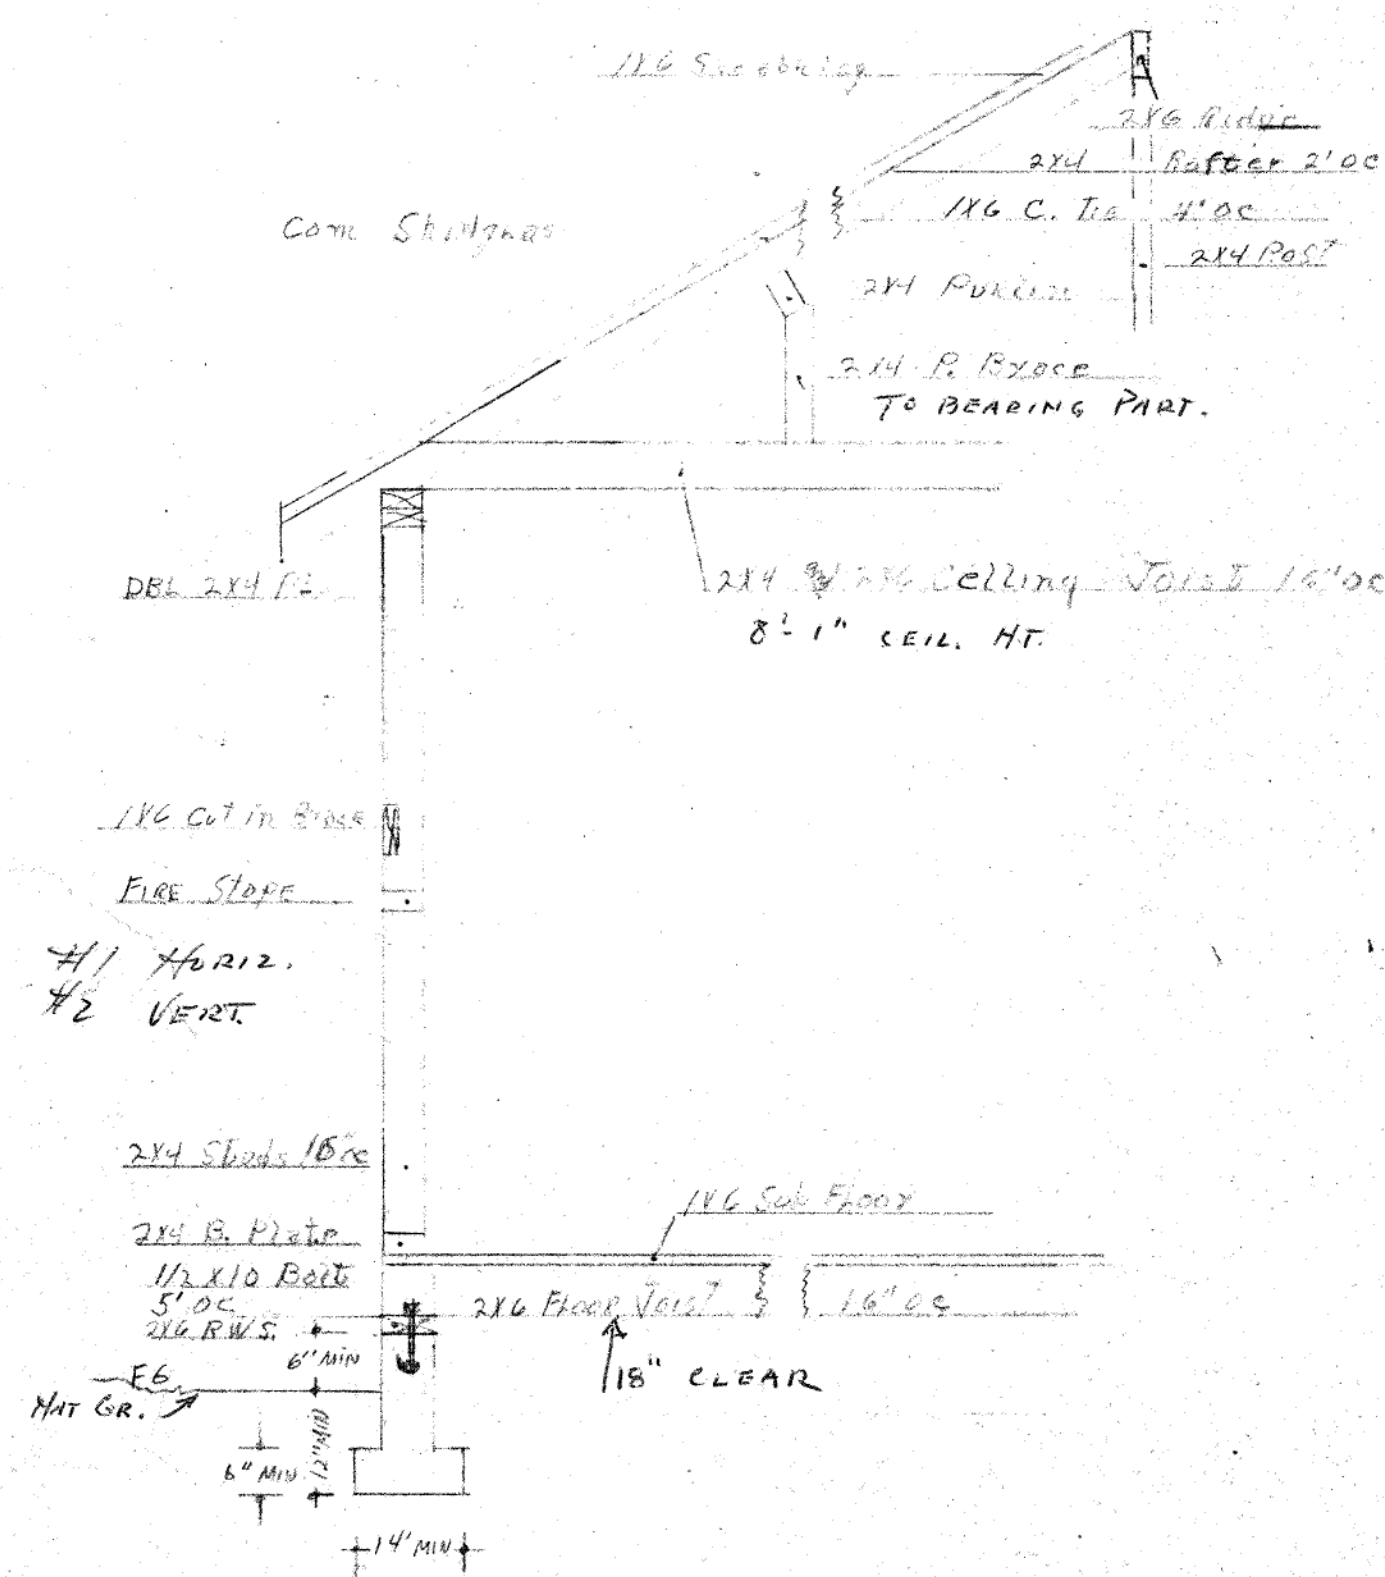

**APPROVED**  
SEP 19 1955  
BUILDING INSPECTOR  
CITY OF SANTA BARBARA

G.B. MARLETT  
412 Flora Vista Dr  
Lot 5

SPECIAL NOTICE!  
PLUMBING, GAS, HEATING AND ELECTRICAL WORK SHALL REQUIRE SEPARATE PERMITS WHICH SHALL BE OBTAINED BEFORE ANY WORK IS STARTED. CHECK CITY SEWER FOR ELEVATION AND LOCATION. NO FLOORING SHALL COVER ANY PLUMBING UNTIL INSPECTED AND APPROVED.

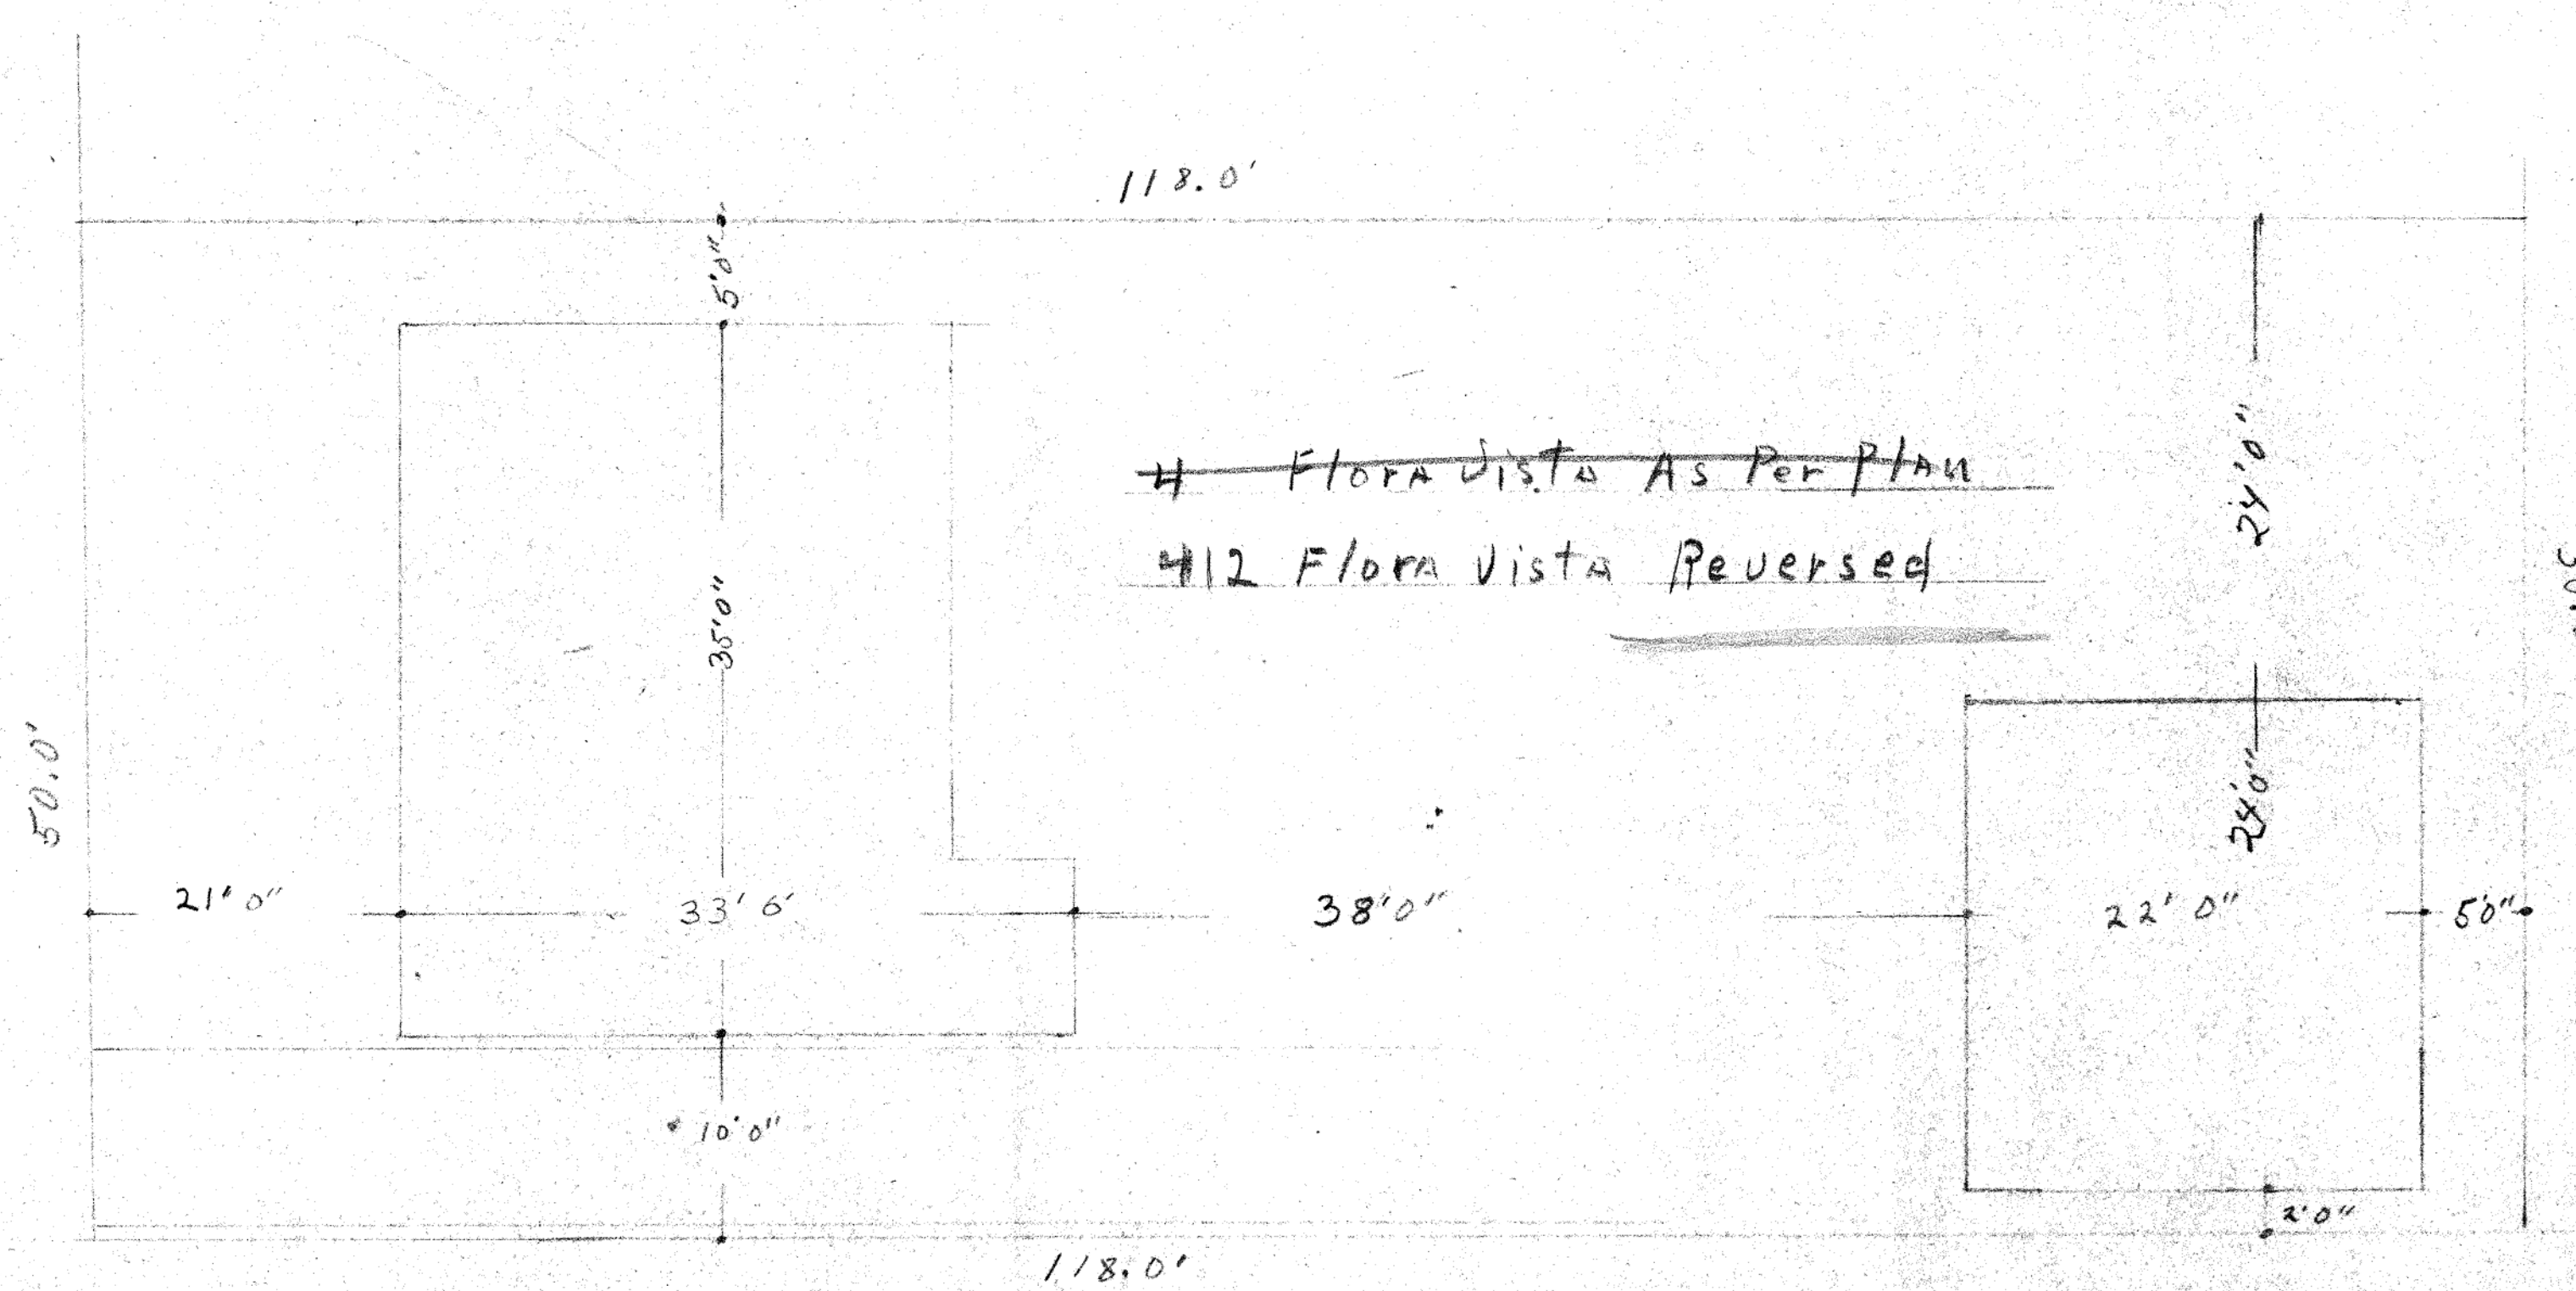

# Flora Vista As Per Plan  
#12 Flora Vista Reversed








# Evans Remodel

412 Flora Vista,  
Santa Barbara, CA


## STANDARD DETAILS

### 9 TYPICAL NOTCHING & BORING


#### PENETRATIONS IN TOP PLATES & SILL PLATES

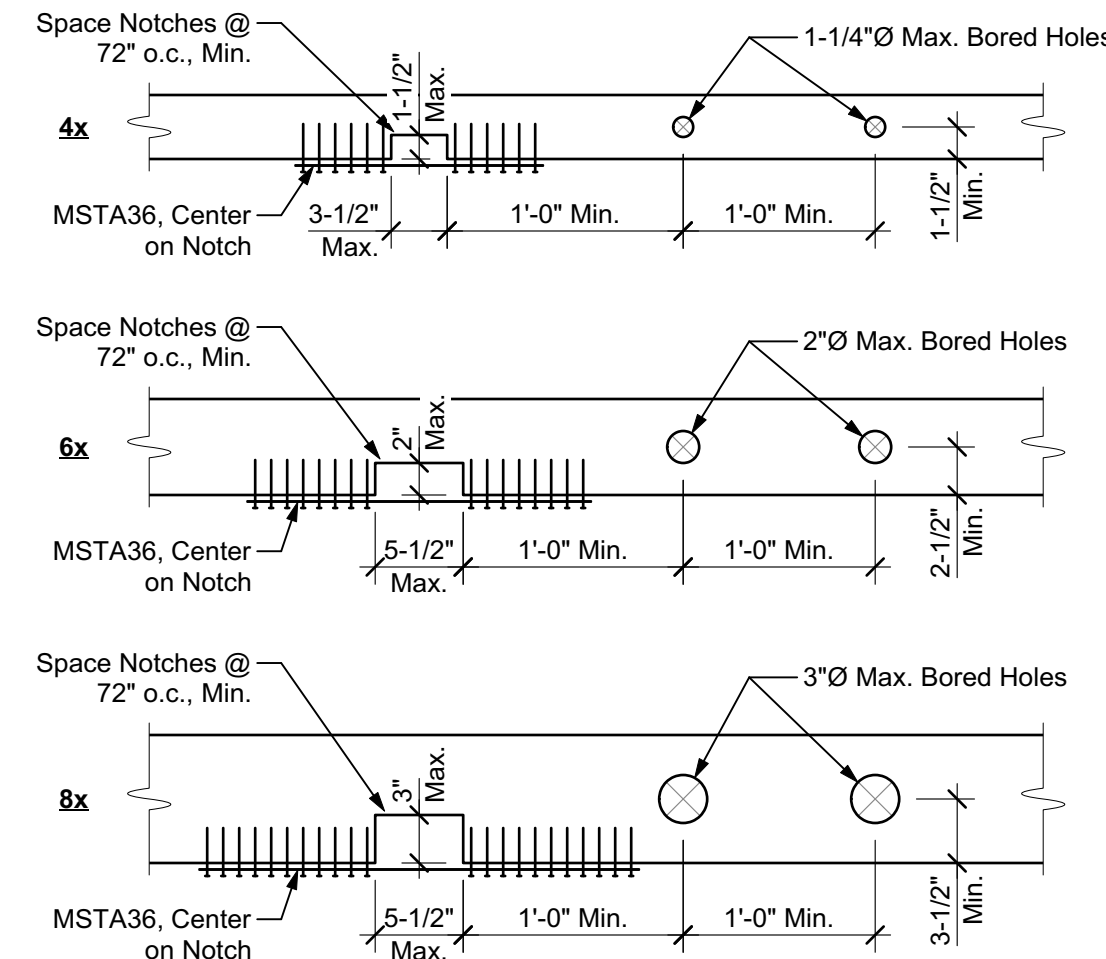


#### NOTCHING LIMITS FOR WOOD STUDS

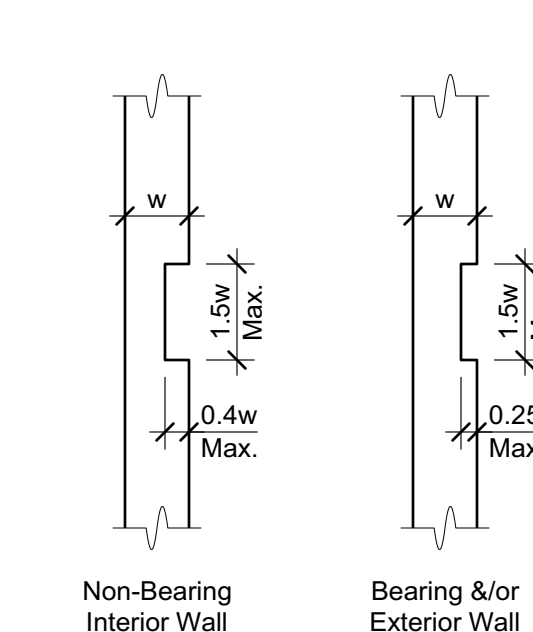


#### BORING LIMITS FOR WOOD STUDS

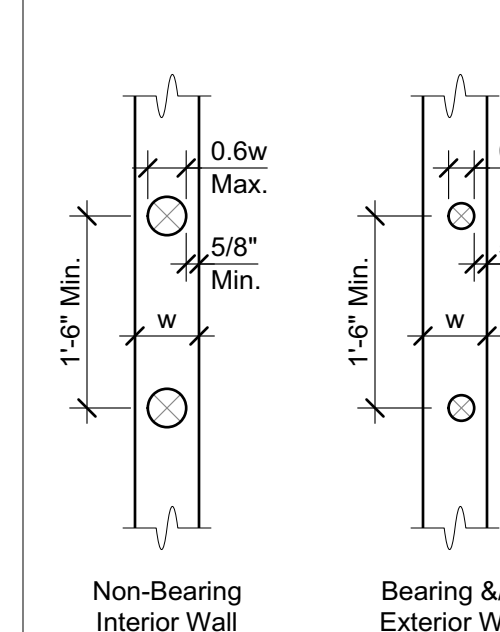


### 6 TYPICAL FLOOR / ROOF NAILING

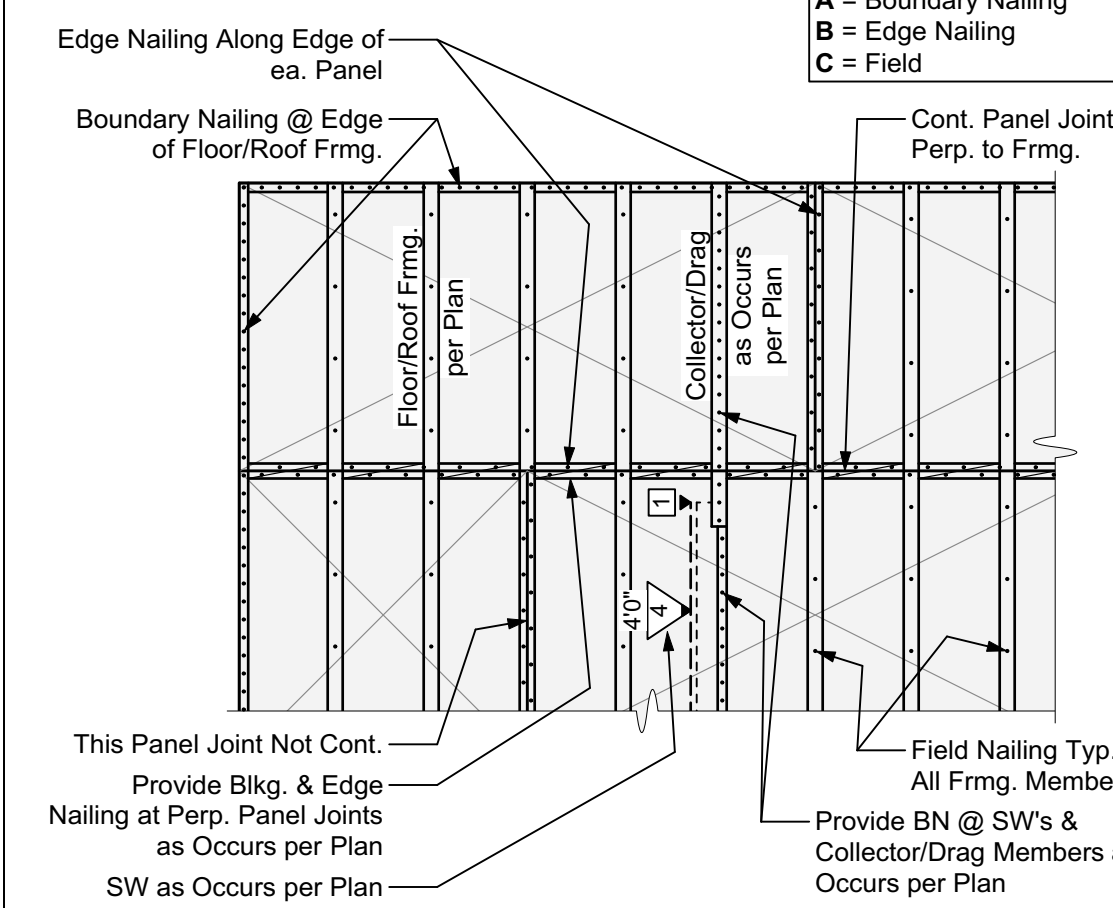

### 4 TYPICAL CONCRETE SLAB JOINTS

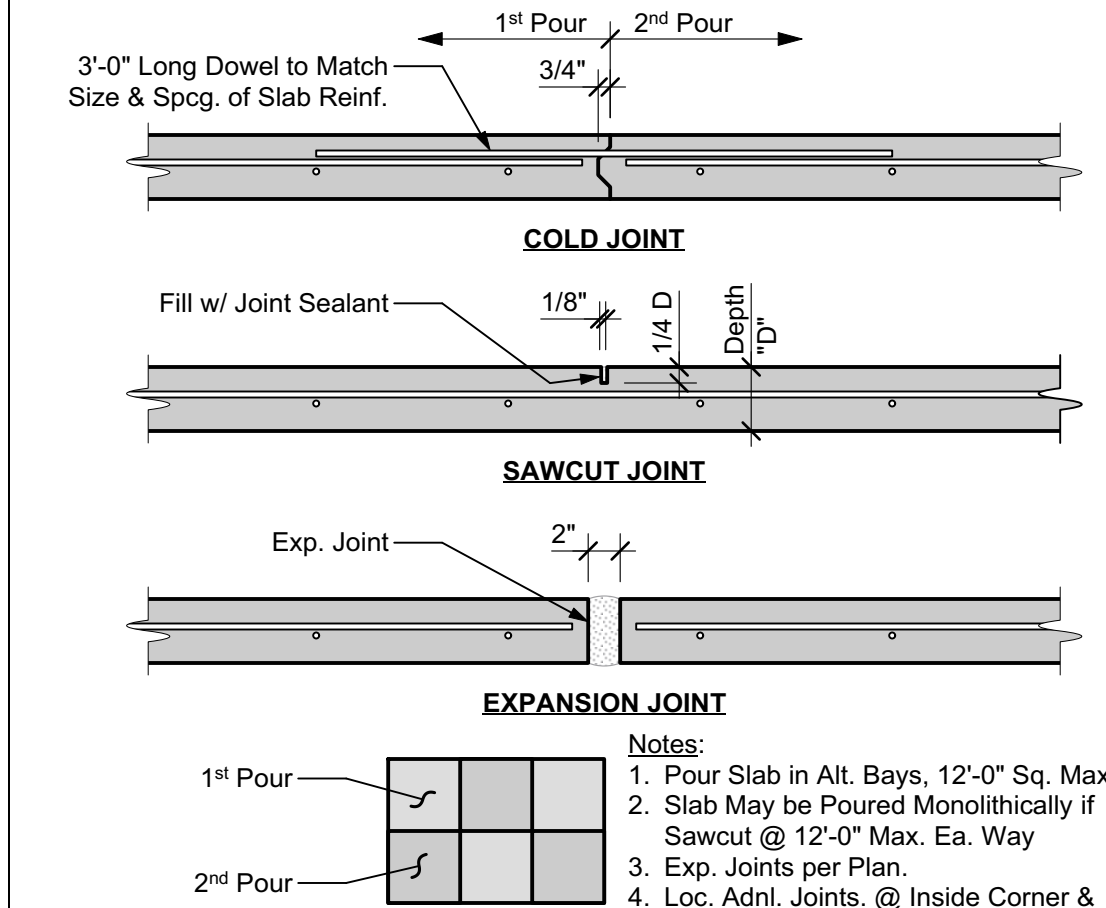

### 1 TYPICAL REINFORCING BAR BENDS

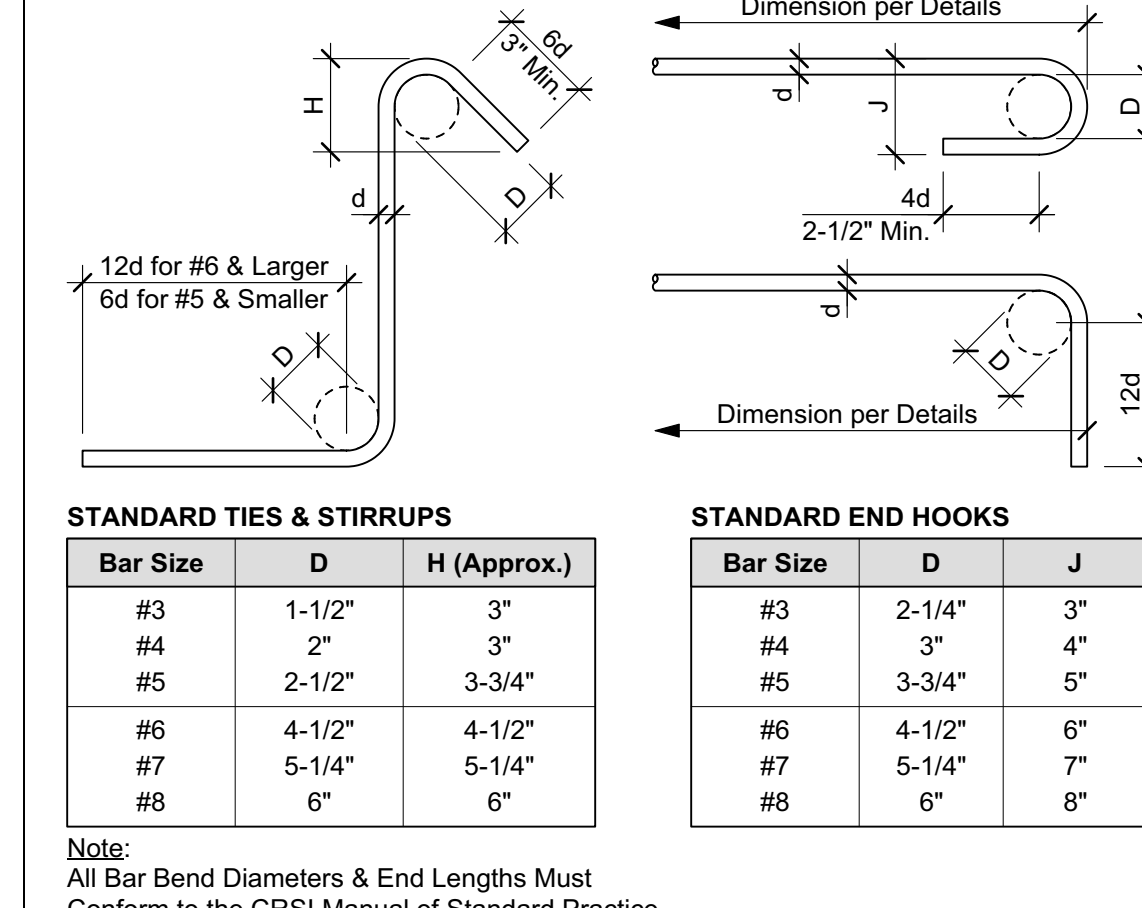

## ABBREVIATIONS

AB	Anchor Bolt	Mas.	Masonry
A&B	Above and Below	Max.	Maximum
Adv.	Above	MB	Machinist Bolt
Adn.	Addition (al)	MF	Moment Frame
Adj.	Adjacent/Adjustable	Mfr.	Manufacturer(s)
Alt.	Alternate (ive)	Min.	Minimum, Minute
Appd.	Approved	Mod.	Modify(ing), (ication)
Arch.	Architect(ural)	Mtl.	Metal
Avg.	Average	(N)	New
Bdry.	Boundary	N/A	Not Applicable
Bldg.	Building	Nat.	Natural
Bk(g).	Block (ing)	NTS	Not to Scale
Bm.	Beam	oc	Over
BN	Boundary Nailing	oc	On Center
B-O	Bottom of	OD	Outside Diameter
BO	By Others	Opng.	Opening
Bot.	Bottom	Opp.	Opposite
Brg.	Bearing	Opt.	Optional
Bwn.	Between	Para.	Parallel
BW	Both Ways	PCF	Lbs per Cubic Ft.
Cant.	Cantilever(ed)	Pen.	Penetrate, (ion)
CIP	Cast in Place	Perf.	Perforated
CJ	Ceiling Joint	Perim.	Perimeter
CJP	Complete Joint	Perp.	Perpendicular
	Penetration	PI	Panel Index
CL	Center Line	PJP	Partial Joint Pen.
Ctg.	Ceiling	PL	Plate
CMU	Conc. Masonry Unit	PLF	Lbs per Linear Ft.
Col.	Column	Ply.	Plywood
Com.	Common	Prep.	Prepare, (ation)
Comp.	Component	Press.	Pressure
Conc.	Concrete	Proj.	Project
Conn.	Connection	Prop.	Property
Const.	Construction	PSF	Lbs per Square Ft.
Cont.	Continue (ous)	PSI	Lbs per Square In.
Cr.	Center	PT	Pressure-Treated
d	Penny	PV	Photovoltaic (Solar Panels)
Dbl.	Double	R	Radius
Defl.	Deflection	R	Radius
Deg.	Degree	Rec(s)	Recommendation(s)
Demo.	Demolish(ion)	Rect.	Rectangular
Dep.	Depress(ed)	Ref.	Reference
DF	Douglas Fir	Reinf.	Reinforce(d)
Dia.	Diameter	Req(d)	Required(d)
Diaph.	Diaphragm	Reqs.	Requirements
Diff.	Different	Ret.	Retain(ing)
Dim.	Dimension	Ret.	Retain(ing)
Dist.	Distance	Roof Joist	Roof Joist
DJ	Deck Joint	RFR	Roof Rafter
DL	Dead Load	RW	Redwood
Dwg.	Drawing	SAD	See Arch Dwg's
(E)	Existing	Sched.	Schedule
Ea.	Each	Sgl.	Single
EF	Each Face	Shtg.	Sheathing
EFP	Equivalent Fluid	Sim.	Similar
	Pressure	SIP	Str. Insulated Panel
Elev.	Elevator, Elevation	SM	Sheet Metal
Embed.	Embed(ed), (ment)	SMS	Sheet Metal Screw
Engr.	Engineer	SOG	Slab on Grade
EOR	Engineer of Record	Spec.	Specify(ed), (ations)
Eq.	Equal, Equivalent	Sq.	Square
ES	Each Side	Std.	Standard
EW	Each Way	Std.	Standard
Exp.	Expand, Expansion	Stgr.	Stagger(ed)
Ext.	Exterior	Str.	Steel
Fdn.	Foundation	Struc.	Structure, (al)
FF	Finished Floor	SW	Shear Wall
FJ	Floor Joist	Sym.	Symmet(ry), (rical)
Fr(g).	Floor (ing)	T&B	Top and Bottom
Frmg.	Framing	T&G	Tongue and Groove
FOC	Face of Concrete	Temp.	Temporary
FOM	Face of Masonry	Thk.	Thick(ness)
FOS	Face of Studs	Thru	Through
FFW	Face of Wall	Tru	True
Frmg.	Framing	TP	Top Plate
FT	Foot, Feet	T-O	Top of
Ftg.	Footing	TOB	Top of Beam
Galv.	Gage, Gauge	TOC	Top of Concrete
GB	Galvanized	TOG	Top of Grade
GC	Grade Beam	TOM	Top of Masonry
Gyp.	Gypsum	TOS	Top of Steel
HD	Holddown	TOW	Top of Wall
Hdr.	Header	TRU	To Remain
Hdw.	Hardware	Unchng.	Unchanged
Hgr.	Hanger	Trmr.	Trimmer Stud
Hor(z)	Horizontal	Typ.	Typical
HT	Height	UNO	Unless Noted
ID	Inside Diameter	Otherw.	Otherwise
In.	Inch(es)	Vert.	Vertical
Insp.	Inspection(ion)	VIF	Verify in Field
Int.	Interior	VVA	Verify with Arch
Inv.	Invert, Inverted	w/	With
Jst.	Joist	w/in	Within
K	Kips (1,000 pounds)	w/o	Without
KLF	Kips per Linear Ft.	WS	Wood Screw
KB	King Stud	Wtd.	Welded
KP	King Post	WT	Weight
KSF	Kips per Square Ft.	WWF	Welded Wire Fabric
KSL	Kips per Square In.	Yd.	Yard
Lx(s).	Live Load	@	At
LL	Live Load	Ø	Diameter
Loc.	Location	>	Greater Than
LW	Light Weight	<	Less Than
		#	Number, Pound(s)
		/	Per
		%	Percent(age)
		±	Plus or Minus

## PROJECT INFORMATION

**CLIENT:**  
Nate Evans  
412 Flora Vista,  
Santa Barbara, CA 93109

**DESIGNER:**  
NN Design  
9114 Regents Rd, #C  
La Jolla, CA 92037  
(760) 473-1041

## DESIGN PARAMETERS

**GENERAL PARAMETERS**

Building Code: 2022 CBC  
Roof Loads: 20 psf  
Dead Loads\*\* (DL): 15 psf  
\*\*Includes 3 psf PV Loads  
Live Loads (LL): 20 psf  
Floor Loads - Typ.: 15 psf  
Dead Loads (DL): 40 psf  
Live Loads (LL): 40 psf

**SOILS VALUES** (Table 1806.2)  
Bearing Pressure: 1500 psf

## WIND DESIGN BASIS

Ultimate Wind Speed,  $V_{ULT}$ : 95 mph  
Nominal Wind Speed,  $V_{ASD}$ : 74 mph  
Risk Category: II  
Exposure: B

## SEISMIC DESIGN BASIS

Seismic Design Category: E  
Site Class: D  
Seismic Factors:  $S_{ps} / S_{D1}$ : 2.316 / 0.821  
 $S_{ps} / S_{D1}$ : 1.853 / 0.930  
Risk Category: II  
Importance Factor,  $I_e$ : 1.00  
Resisting System: Wood Shear Walls  
Response Mod.: 6.5  
Design Base Shear:  $V = 0.285W$   
Analysis Procedure: Eqv. Lateral Force (ASCE 7-16, T. 12.6-1)

## SHEET INDEX

S-1.1	Structural Title Sheet
S-1.2	Structural Specifications & Special Inspections
S-2.1	Foundation Plan
S-2.2	Floor Framing Plan
S-2.3	Roof Framing Plan
S-3.1	Structural Details
S-3.2	Structural Details
S-3.3	Structural Details

The use of these plans and specifications shall be restricted to the original site for which they were prepared and publication thereof is expressly limited to such use. Reproduction or publication by any method, in whole or in part, is prohibited. Title to these plans and specifications remain with Ashley & Vance Engineering, Inc. without prejudice. Visual contact with these plans and specifications shall constitute prima facie evidence of the acceptance of these restrictions.




Engineer of Record:

Evans Remodel  
412 Flora Vista,  
Santa Barbara, CA


### TYPICAL SHEAR WALL FRAMING NOTES:

- Single sided shear walls may be placed on EITHER side of the framed wall.
- Sill plates on masonry or concrete to be pressure treated per Timber / Lumber specifications. Sill plate thickness per SW Sched.
- Wall studs and blkg. are required at all adjoining panel edges. Thickness of wall studs and blkg. at panel edges per SW Sched.
- Where plywood is applied on both faces of a wall, edge nails shall be staggered on adjacent panel edges OR panel joints shall be offset to fall on different framing members. Plywood joint and sill plate nailing shall be staggered in all cases.
- Plywood panels shall butt along centerlines of framing members. Minimum plywood dimension for shearwall shall be 12".
- Nails shall be located at least 3/8" from all panel edges.
- The use of pneumatic nail guns for shear wall nailing is subject to continued satisfactory jobsite performance and subject to the review and approval by the Engineer of Record and/or Building Inspector. If the nail heads penetrate the outer ply more than would be normal for a hand held hammer, or if the minimum edge distances are not maintained, the performance will be deemed as unsatisfactory and the continued use of pneumatic nail for shear wall nailing will not be permitted.
- All bearing walls (both exterior and interior walls) not noted as shear walls, continuous full depth blocking shall be provided between joists and rafters with LTP4 or A35 to top plates @ 32" oc at floors and 48" oc at roofs, unless noted otherwise per plan.
- Refer to material specifications for additional framing requirements.


### SHEAR WALL LEGEND

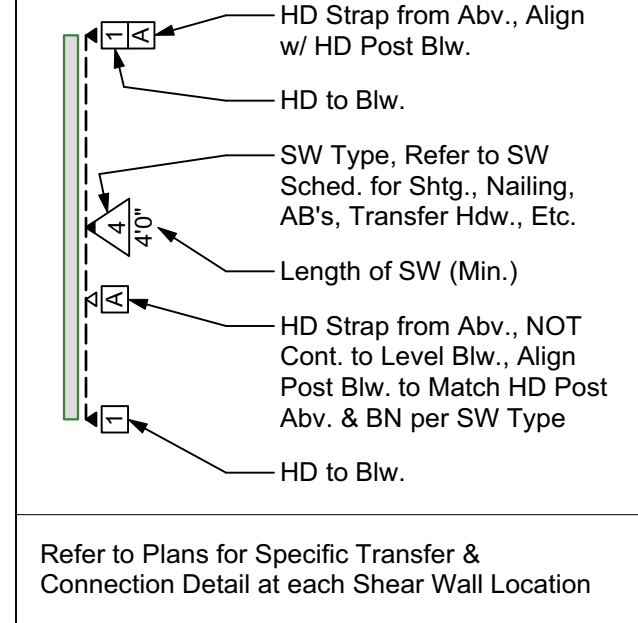


### 10 TYPICAL SHEAR WALL INTERSECTIONS

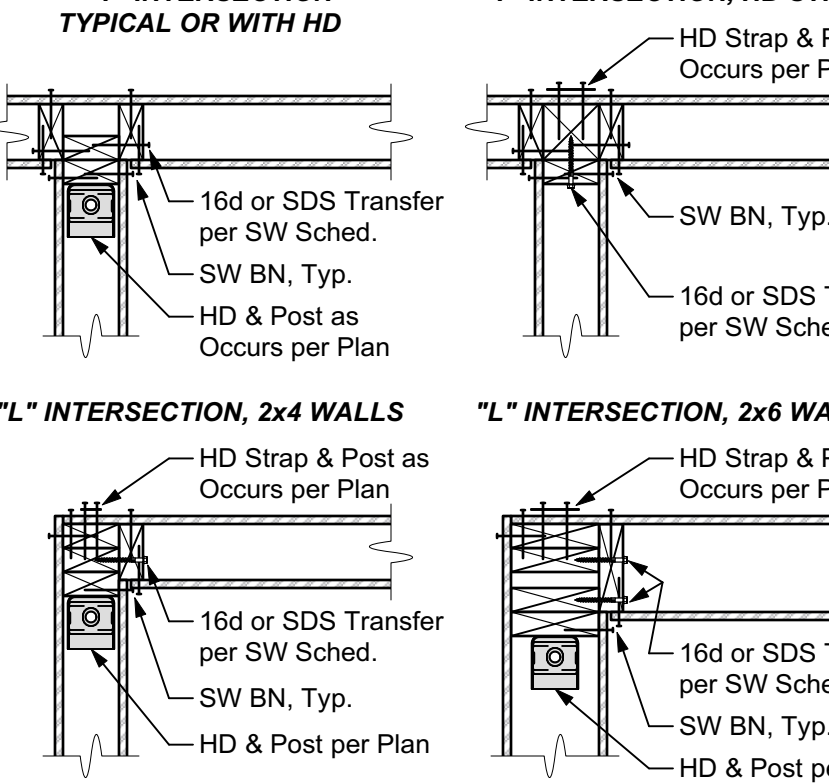

### 8 TYPICAL SHEAR WALL FRAMING

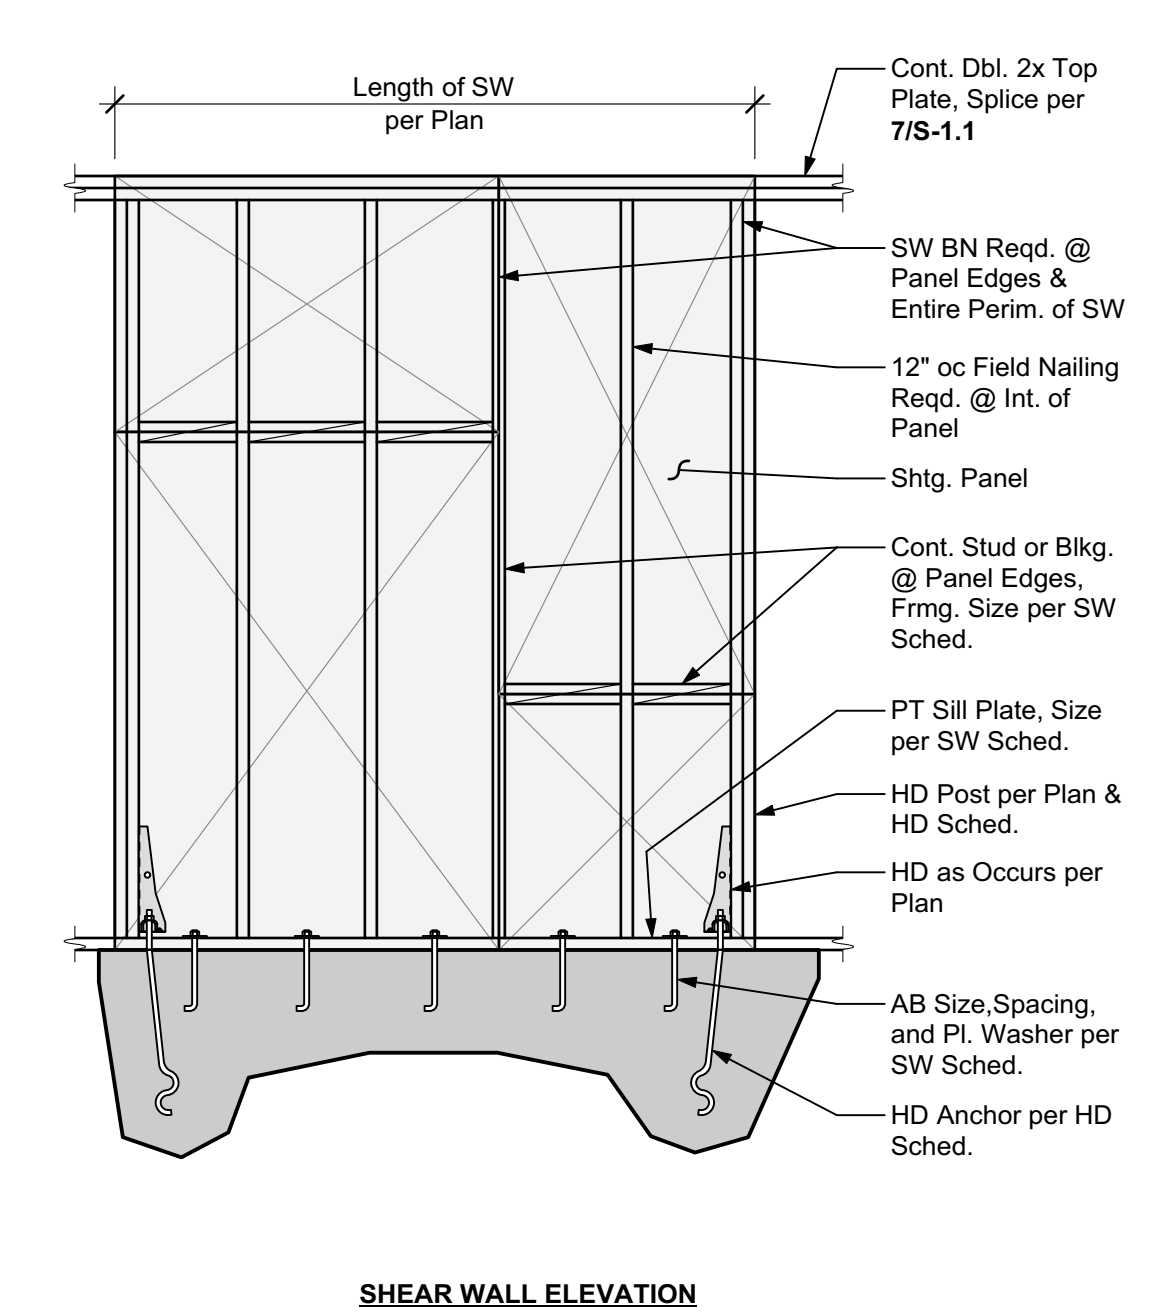


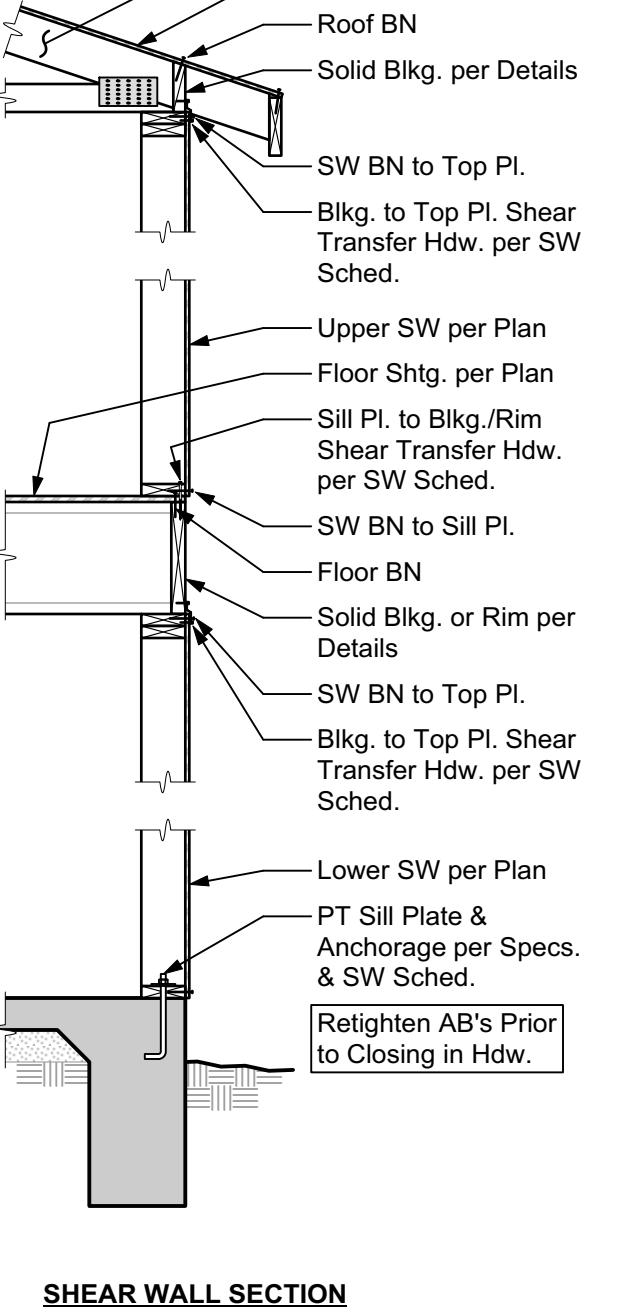

### Recommended Non-Str. Int. Wall Hdr.

Span	2x4 Wall	2x6 Wall
< 4'-0"	Dbl. 2x4 Flat	Dbl. 2x6 Flat
< 6'-0"	4x4	4x6 Flat
< 8'-0"	4x6	6x6
> 8'-0"	Span in Feet Equals Beam Depth in Inches	

































Drawn By:  
 NN

Drawing Date:  
 October 10, 2023

Revisions:

revision	date	notes

**Evans Remodel**  
 412 Flora Vista, Santa Barbara, CA


PROJECT:

**Plumbing Plans**


SHEET TITLE:

**P**

DRAWING NUMBER:

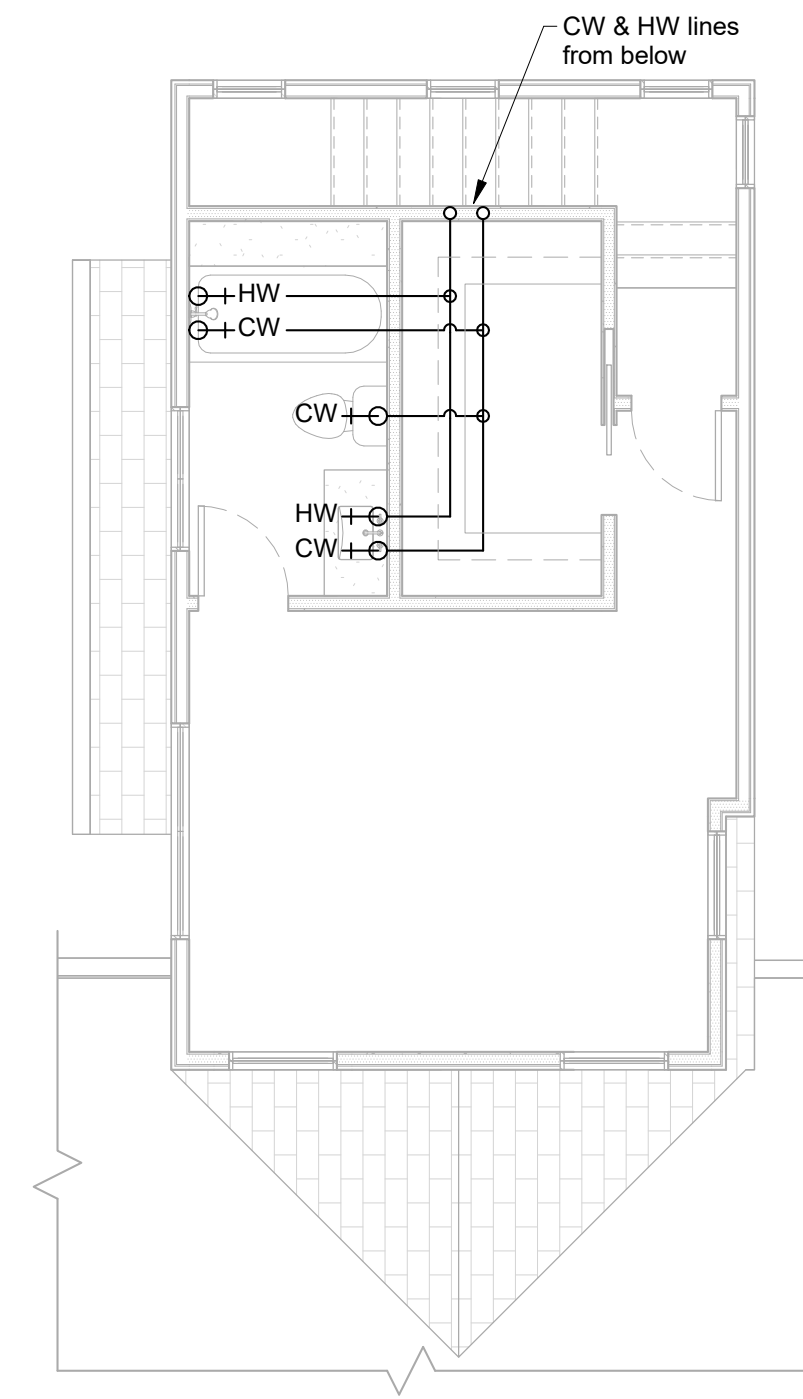

**2 Plumbing Plan - 2nd Floor**  
 3/16" = 1'-0"

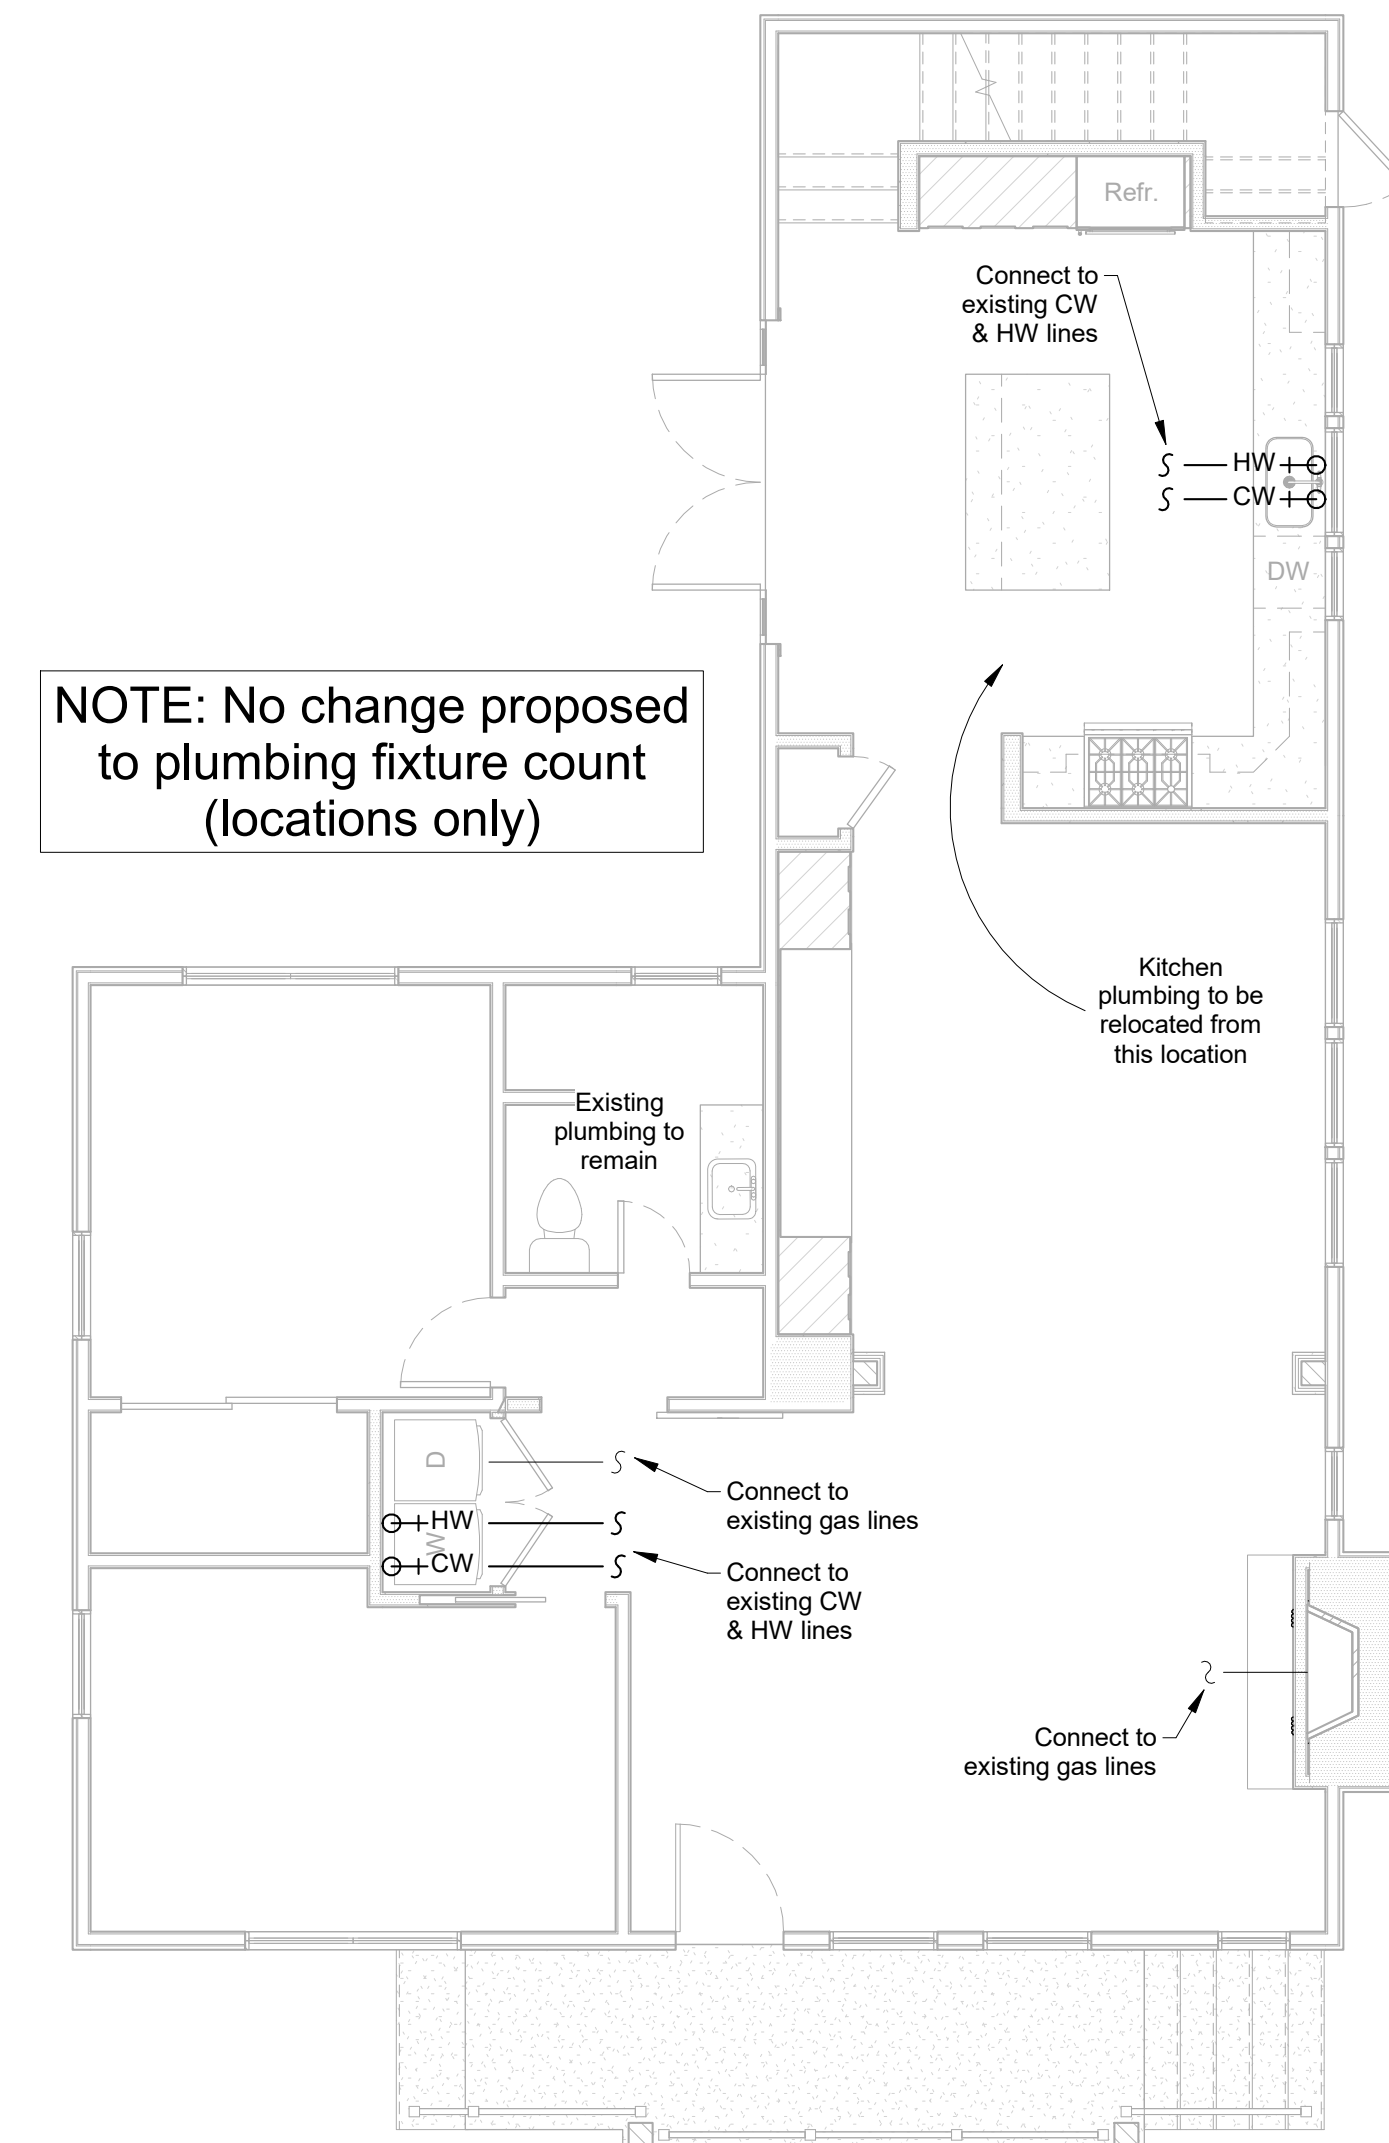

**1 Plumbing Plan - 1st Floor**  
 3/16" = 1'-0"

**Plumbing Notes:**

- All hot water piping from the heating source to the kitchen fixtures must be insulated with 1" thick insulation for pipes sizes 2" or less and 1 1/2" thick insulation for pipe sizes greater than 2".
- Water piping connections shall use lead-free solder.
- The control valves in showers and bathtubs must be pressure balanced or thermostatic mixing valves. CPC Sections 408, 409, 410
- Building drain and vent piping materials shall comply with Sections 701.0 and 903.3 of the California Plumbing Code.
- All sanitary system materials shall be listed by an approved listing agency.
- If shower is provided with multiple shower heads, the sum of flow to all heads shall not exceed the 20% reduced limit, or the shower shall be designed so that only one head is on at a time per CGC 4.303.2
- Below grade hot water piping is required to be installed in a waterproof and non-crushable sleeve or casing that allows for replacement of both the piping and insulation.

**Hot Water Heater Notes:**

Navien Hot Water Heater, model NPE-240A: 95% Thermal Efficiency; 0.95 Energy Factor; 199,000 BTU max input; 3/4" gas line feed; Provide outdoor venting cap for all locations; Install per manufacturer's specifications located at exterior wall by Gallery (See 1/P1).

- For gas water heaters installed to serve individual dwelling units: ES 150.0(n)
- Gas piping sizing based upon a minimum input of 200,000 btu/hr.
- A condensate drain installed no higher than 2" above the base of the heater that also allows for gravity drainage.
- A 120 volt receptacle accessible to the heater installed within 3'.
- Instantaneous water heaters shall have isolating valves on both the cold and hot water piping leaving the water heater complete with hose bibs or other fittings on each valve for flushing the water heater when valves are closed. ES 110.3

**FIXTURE FLOW RATES (SECT 4.303)**

FIXTURE TYPE	MAX ALLOW. FLOW RATE
Water closets	1.28 gallons/flush
Urinals (wall-mounted)	0.125 gallons/flush
Urinals (others)	0.5 gallons/flush
Showerheads	1.8 gpm @ 80 psi
Lavatory faucets	1.2 gpm @ 60 psi <sup>1</sup>
Kitchen faucets	1.8 @ 60 psi
Metering faucets	0.25 gallons per cycle

Note: Where complying faucets are unavailable, aerators or other means may be used to achieve reduction

<sup>1</sup>. Lavatory faucets shall not have a flow rate less than 0.8 gpm at 20 psi.



2022 CALIFORNIA GREEN BUILDING STANDARDS CODE
RESIDENTIAL MANDATORY MEASURES, SHEET 1 (January 2023)

Y = YES
NA = NOT APPLICABLE
RESPON = RESPONSIBLE PARTY (i.e. ARCHITECT, ENGINEER, OWNER, CONTRACTOR, INSPECTOR ETC.)

Main table with 4 columns: Y, NA, RESPON, PARTY. Contains sections for CHAPTER 3 GREEN BUILDING, DIVISION 4.1 PLANNING AND DESIGN, CHAPTER 4 RESIDENTIAL MANDATORY MEASURES, and DIVISION 4.4 MATERIAL CONSERVATION AND RESOURCE EFFICIENCY.

TABLE H-2
STANDARDS FOR COMMERCIAL PRE-RINSE SPRAY VALVES MANUFACTURED ON OR AFTER JANUARY 28, 2019
PRODUCT CLASS [spray force in ounce force (ozf)] MAXIMUM FLOW RATE (gpm)

4.303.2 Submeters for multifamily buildings and dwelling units in mixed-used residential/commercial buildings. Submeters shall be installed to measure water usage of individual rental dwelling units in accordance with the California Plumbing Code.

4.303.3 Standards for plumbing fixtures and fittings. Plumbing fixtures and fittings shall be installed in accordance with the California Plumbing Code, and shall meet the applicable standards referenced in Table 1701.1 of the California Plumbing Code.

NOTE: THIS TABLE COMPLETES THE DATA IN SECTION 4.303.1, AND IS INCLUDED AS A CONVENIENCE FOR THE USER.

TABLE - MAXIMUM FIXTURE WATER USE
FIXTURE TYPE FLOW RATE
SHOWER HEADS (RESIDENTIAL) 1.8 GMP @ 80 PSI
LAVATORY FAUCETS (RESIDENTIAL) MAX. 1.2 GPM @ 60 PSI MIN. 0.8 GPM @ 20 PSI



**MAXIMUM INCREMENTAL REACTIVITY (MIR).** The maximum change in weight of ozone formed by adding a compound to the "Base Reactive Organic Gas (ROG) Mixture" per weight of compound added, expressed to hundredths of a gram (g O<sub>3</sub>/g ROG).  
Note: MIR values for individual compounds and hydrocarbon solvents are specified in CCR, Title 17, Sections 9470 and 9470.1.

**MOISTURE CONTENT.** The weight of the water in wood expressed in percentage of the weight of the oven-dry wood.

**PRODUCT-WEIGHTED MIR (PWMIR).** The sum of all weighted-MIR for all ingredients in a product subject to this article. The PWMIR is the total product reactivity expressed to hundredths of a gram of ozone formed per gram of product (excluding container and packaging).  
Note: PWMIR is calculated according to equations found in CCR, Title 17, Section 94521 (a).

**REACTIVE ORGANIC COMPOUND (ROC).** Any compound that has the potential, once emitted, to contribute to ozone formation in the troposphere.

**VOC.** A volatile organic compound (VOC) broadly defined as a chemical compound based on carbon chains or rings with vapor pressures greater than 0.1 millimeters of mercury at room temperature. These compounds typically contain hydrogen and may contain oxygen, nitrogen and other elements. See CCR Title 17, Section 94508(a).

**4.503 FIREPLACES**  
4.503.1 GENERAL. Any installed gas fireplace shall be a direct-vent sealed-combustion type. Any installed woodstove or pellet stove shall comply with U.S. EPA New Source Performance Standards (NSPS) emission limits as applicable, and shall have a permanent label indicating they are certified to meet the emission limits. Woodstoves, pellet stoves and fireplaces shall also comply with applicable local ordinances.

**4.504 POLLUTANT CONTROL**  
4.504.1 COVERING OF DUCT OPENINGS & PROTECTION OF MECHANICAL EQUIPMENT DURING CONSTRUCTION. At the time of rough installation, during storage on the construction site and until final startup of the heating, cooling and ventilating equipment, all duct and other related air distribution component openings shall be covered with tape, plastic, sheet metal or other methods acceptable to the enforcing agency to reduce the amount of water, dust or debris which may enter the system.

**4.504.2 FINISH MATERIAL POLLUTANT CONTROL.** Finish materials shall comply with this section.

**4.504.2.1 Adhesives, Sealants and Caulks.** Adhesives, sealant and caulks used on the project shall meet the requirements of the following standards unless more stringent local or regional air pollution or air quality management district rules apply:

- Adhesives, adhesive bonding primers, adhesive primers, sealants, sealant primers and caulks shall comply with local air pollution control or air quality management district rules where applicable or SCAQMD Rule 1168 VOC limits, as shown in Table 4.504.1 or 4.504.2, as applicable. Such products also shall comply with the Rule 1168 prohibition on the use of certain toxic compounds (chloroform, ethylene dichloride, methylene chloride, perchloroethylene and trichloroethylene), except for aerosol products, as specified in Subsection 2 below.
- Aerosol adhesives, and smaller unit sizes of adhesives, and sealant or caulking compounds (in units of product, less packaging, which do not weigh more than 1 pound and do not consist of more than 16 fluid ounces) shall comply with statewide VOC standards and other requirements, including prohibitions on use of certain toxic compounds, of California Code of Regulations, Title 17, commencing with section 94507.

**4.504.2.2 Paints and Coatings.** Architectural paints and coatings shall comply with VOC limits in Table 1 of the ARB Architectural Coatings Control Measure, as shown in Table 4.504.3, unless more stringent local limits apply. The VOC content limit for coatings that do not meet the definitions for the specialty coatings categories listed in Table 4.504.3 shall be determined by classifying the coating as a Flat, Nonflat or Nonflat-High Gloss coating, based on its gloss, as defined in subsections 4.21, 4.36, and 4.37 of the 2007 California Air Resources Board, Suggested Control Measure, and the corresponding Flat, Nonflat or Nonflat-High Gloss VOC limit in Table 4.504.3 shall apply.

**4.504.2.3 Aerosol Paints and Coatings.** Aerosol paints and coatings shall meet the Product-weighted MIR Limits for ROG in Section 94522(a)(2) and other requirements, including prohibitions on use of certain toxic compounds and ozone depleting substances, in Sections 94522(e)(1) and (f)(1) of California Code of Regulations, Title 17, commencing with Section 94520, and in areas under the jurisdiction of the Bay Area Air Quality Management District additionally comply with the percent VOC by weight of product limits of Regulation 8, Rule 49.

**4.504.2.4 Verification.** Verification of compliance with this section shall be provided at the request of the enforcing agency. Documentation may include, but is not limited to, the following:

- Manufacturer's product specification.
- Field verification of on-site product containers.

ARCHITECTURAL APPLICATIONS	VOC LIMIT
INDOOR CARPET ADHESIVES	50
CARPET PAD ADHESIVES	50
OUTDOOR CARPET ADHESIVES	150
WOOD FLOORING ADHESIVES	100
RUBBER FLOOR ADHESIVES	60
SUBFLOOR ADHESIVES	50
CERAMIC TILE ADHESIVES	65
VCT & ASPHALT TILE ADHESIVES	50
DRYWALL & PANEL ADHESIVES	50
COVE BASE ADHESIVES	50
MULTIPURPOSE CONSTRUCTION ADHESIVE	70
STRUCTURAL GLAZING ADHESIVES	100
SINGLE-PLY ROOF MEMBRANE ADHESIVES	250
OTHER ADHESIVES NOT LISTED	50
<b>SPECIALTY APPLICATIONS</b>	
PVC WELDING	510
CPVC WELDING	490
ABS WELDING	325
PLASTIC CEMENT WELDING	250
ADHESIVE PRIMER FOR PLASTIC	550
CONTACT ADHESIVE	80
SPECIAL PURPOSE CONTACT ADHESIVE	250
STRUCTURAL WOOD MEMBER ADHESIVE	140
TOP & TRIM ADHESIVE	250
<b>SUBSTRATE SPECIFIC APPLICATIONS</b>	
METAL TO METAL	30
PLASTIC FOAMS	50
POROUS MATERIAL (EXCEPT WOOD)	50
WOOD	30
FIBERGLASS	80

1. IF AN ADHESIVE IS USED TO BOND DISSIMILAR SUBSTRATES TOGETHER, THE ADHESIVE WITH THE HIGHEST VOC CONTENT SHALL BE ALLOWED.

2. FOR ADDITIONAL INFORMATION REGARDING METHODS TO MEASURE THE VOC CONTENT SPECIFIED IN THIS TABLE, SEE SOUTH COAST AIR QUALITY MANAGEMENT DISTRICT RULE 1168.

SEALANTS	VOC LIMIT
ARCHITECTURAL	250
MARINE DECK	760
NONMEMBRANE ROOF	300
ROADWAY	250
SINGLE-PLY ROOF MEMBRANE	450
OTHER	420
<b>SEALANT PRIMERS</b>	
ARCHITECTURAL	
NON-POROUS	250
POROUS	775
MODIFIED BITUMINOUS	500
MARINE DECK	760
OTHER	750

COATING CATEGORY	VOC LIMIT
FLAT COATINGS	50
NON-FLAT COATINGS	100
NONFLAT-HIGH GLOSS COATINGS	150
<b>SPECIALTY COATINGS</b>	
ALUMINUM ROOF COATINGS	400
BASEMENT SPECIALTY COATINGS	400
BITUMINOUS ROOF COATINGS	50
BITUMINOUS ROOF PRIMERS	350
BOND BREAKERS	350
CONCRETE CURING COMPOUNDS	350
CONCRETE/MASONRY SEALERS	100
DRIVEWAY SEALERS	50
DRY FOG COATINGS	150
FAUX FINISHING COATINGS	350
FIRE RESISTIVE COATINGS	350
FLOOR COATINGS	100
FORM-RELEASE COMPOUNDS	250
GRAPHIC ARTS COATINGS (SIGN PAINTS)	500
HIGH TEMPERATURE COATINGS	420
INDUSTRIAL MAINTENANCE COATINGS	250
LOW SOLIDS COATINGS <sub>1</sub>	120
MAGNESITE CEMENT COATINGS	450
MASTIC TEXTURE COATINGS	100
METALLIC PIGMENTED COATINGS	500
MULTICOLOR COATINGS	250
PRETREATMENT WASH PRIMERS	420
PRIMERS, SEALERS, & UNDERCOATERS	100
REACTIVE PENETRATING SEALERS	350
RECYCLED COATINGS	250
ROOF COATINGS	50
RUST PREVENTATIVE COATINGS	250
SHELLACS	
CLEAR	730
OPAQUE	550
SPECIALTY PRIMERS, SEALERS & UNDERCOATERS	100
STAINS	250
STONE CONSOLIDANTS	450
SWIMMING POOL COATINGS	340
TRAFFIC MARKING COATINGS	100
TUB & TILE REFINISH COATINGS	420
WATERPROOFING MEMBRANES	250
WOOD COATINGS	275
WOOD PRESERVATIVES	350
ZINC-RICH PRIMERS	340

1. GRAMS OF VOC PER LITER OF COATING, INCLUDING WATER & EXEMPT COMPOUNDS

2. THE SPECIFIED LIMITS REMAIN IN EFFECT UNLESS REVISER LIMITS ARE LISTED IN SUBSEQUENT COLUMNS IN THE TABLE.

3. VALUES IN THIS TABLE ARE DERIVED FROM THOSE SPECIFIED BY THE CALIFORNIA AIR RESOURCES BOARD, ARCHITECTURAL COATINGS SUGGESTED CONTROL MEASURE, FEB. 1, 2008. MORE INFORMATION IS AVAILABLE FROM THE AIR RESOURCES BOARD.

PRODUCT	CURRENT LIMIT
HARDWOOD PLYWOOD VENEER CORE	0.05
HARDWOOD PLYWOOD COMPOSITE CORE	0.05
PARTICLE BOARD	0.09
MEDIUM DENSITY FIBERBOARD	0.11
THIN MEDIUM DENSITY FIBERBOARD <sub>2</sub>	0.13

1. VALUES IN THIS TABLE ARE DERIVED FROM THOSE SPECIFIED BY THE CALIF. AIR RESOURCES BOARD, AIR TOXICS CONTROL MEASURE FOR COMPOSITE WOOD AS TESTED IN ACCORDANCE WITH ASTM E 1333. FOR ADDITIONAL INFORMATION, SEE CALIF. CODE OF REGULATIONS, TITLE 17, SECTIONS 93120 THROUGH 93120.12.

2. THIN MEDIUM DENSITY FIBERBOARD HAS A MAXIMUM THICKNESS OF 5/16" (8 MM).

**DIVISION 4.5 ENVIRONMENTAL QUALITY (continued)**  
4.504.3 CARPET SYSTEMS. All carpet installed in the building interior shall meet the requirements of the California Department of Public Health, "Standard Method for the Testing and Evaluation of Volatile Organic Chemical Emissions from Indoor Sources Using Environmental Chambers," Version 1.2, January 2017 (Emission testing method for California Specification 01350)

See California Department of Public Health's website for certification programs and testing labs.  
<https://www.cdph.ca.gov/Programs/CCDPHP/DEOD/CEHLB/IAQ/Pages/VOC.aspx>

**4.504.3.1 Carpet cushion.** All carpet cushion installed in the building interior shall meet the requirements of the California Department of Public Health, "Standard Method for the Testing and Evaluation of Volatile Organic Chemical Emissions from Indoor Sources Using Environmental Chambers," Version 1.2, January 2017 (Emission testing method for California Specification 01350)

See California Department of Public Health's website for certification programs and testing labs.  
<https://www.cdph.ca.gov/Programs/CCDPHP/DEOD/CEHLB/IAQ/Pages/VOC.aspx>

**4.504.3.2 Carpet adhesive.** All carpet adhesive shall meet the requirements of Table 4.504.1.

**4.504.4 RESILIENT FLOORING SYSTEMS.** Where resilient flooring is installed, at least 80% of floor area receiving resilient flooring shall meet the requirements of the California Department of Public Health, "Standard Method for the Testing and Evaluation of Volatile Organic Chemical Emissions from Indoor Sources Using Environmental Chambers," Version 1.2, January 2017 (Emission testing method for California Specification 01350)

See California Department of Public Health's website for certification programs and testing labs.  
<https://www.cdph.ca.gov/Programs/CCDPHP/DEOD/CEHLB/IAQ/Pages/VOC.aspx>

**4.504.5 COMPOSITE WOOD PRODUCTS.** Hardwood plywood, particleboard and medium density fiberboard composite wood products used on the interior or exterior of the buildings shall meet the requirements for formaldehyde as specified in ARB's Air Toxics Control Measure for Composite Wood (17CCR 93120 et seq.), by or before the dates specified in those sections, as shown in Table 4.504.5

**4.504.5.1 Documentation.** Verification of compliance with this section shall be provided as requested by the enforcing agency. Documentation shall include at least one of the following:

- Product certifications and specifications.
- Chain of custody certifications.
- Product labeled and invoiced as meeting the Composite Wood Products regulation (see CCR, Title 17, Section 93120, et seq.).
- Exterior grade products marked as meeting the PS-1 or PS-2 standards of the Engineered Wood Association, the Australian AS/NZS 2269, European EN 336 standards, and Canadian CSA 0121, CSA 0151, CSA 0153 and CSA 0329 standards.
- Other methods acceptable to the enforcing agency.

**4.505 INTERIOR MOISTURE CONTROL**  
4.505.1 General. Buildings shall meet or exceed the provisions of the California Building Standards Code.

**4.505.2 CONCRETE SLAB FOUNDATIONS.** Concrete slab foundations required to have a vapor retarder by California Building Code, Chapter 19, or concrete slab-on-ground floors required to have a vapor retarder by the California Residential Code, Chapter 5, shall also comply with this section.

**4.505.2.1 Capillary break.** A capillary break shall be installed in compliance with at least one of the following:

- A 4-inch (101.6 mm) thick base of 1/2 inch (12.7mm) or larger clean aggregate shall be provided with a vapor barrier in direct contact with concrete and a concrete mix design, which will address bleeding, shrinkage, and curling, shall be used. For additional information, see American Concrete Institute, ACI 302.2R-06.
- Other equivalent methods approved by the enforcing agency.
- A slab design specified by a licensed design professional.

**4.505.3 MOISTURE CONTENT OF BUILDING MATERIALS.** Building materials with visible signs of water damage shall not be installed. Wall and floor framing shall not be enclosed when the framing members exceed 19 percent moisture content. Moisture content shall be verified in compliance with the following:

- Moisture content shall be determined with either a probe-type or contact-type moisture meter. Equivalent moisture verification methods may be approved by the enforcing agency and shall satisfy requirements found in Section 101.8 of this code.
- Moisture readings shall be taken at a point 2 feet (610 mm) to 4 feet (1219 mm) from the grade stamped end of each piece verified.
- At least three random moisture readings shall be performed on wall and floor framing with documentation acceptable to the enforcing agency provided at the time of approval to enclose the wall and floor framing.

Insulation products which are visibly wet or have a high moisture content shall be replaced or allowed to dry prior to enclosure in wall or floor cavities. Wet-applied insulation products shall follow the manufacturers' drying recommendations prior to enclosure.

**4.506 INDOOR AIR QUALITY AND EXHAUST**  
4.506.1 Bathroom exhaust fans. Each bathroom shall be mechanically ventilated and shall comply with the following:

- Fans shall be ENERGY STAR compliant and be ducted to terminate outside the building.
- Unless functioning as a component of a whole house ventilation system, fans must be controlled by a humidity control.
  - Humidity controls shall be capable of adjustment between a relative humidity range less than or equal to 50% to a maximum of 80%. A humidity control may utilize manual or automatic means of adjustment.
  - A humidity control may be a separate component to the exhaust fan and is not required to be integral (i.e., built-in)

**Notes:**

- For the purposes of this section, a bathroom is a room which contains a bathtub, shower or tub/shower combination.
- Lighting integral to bathroom exhaust fans shall comply with the California Energy Code.

**4.507 ENVIRONMENTAL COMFORT**  
4.507.2 HEATING AND AIR-CONDITIONING SYSTEM DESIGN. Heating and air conditioning systems shall be sized, designed and have their equipment selected using the following methods:

- The heat loss and heat gain is established according to ANSI/ACCA 2 Manual J - 2011 (Residential Load Calculation), ASHRAE handbooks or other equivalent design software or methods.
- Duct systems are sized according to ANSI/ACCA 1 Manual D - 2014 (Residential Duct Systems), ASHRAE handbooks or other equivalent design software or methods.
- Select heating and cooling equipment according to ANSI/ACCA 3 Manual S - 2014 (Residential Equipment Selection), or other equivalent design software or methods.

**Exception:** Use of alternate design temperatures necessary to ensure the system functions are acceptable.

**CHAPTER 7 INSTALLER & SPECIAL INSPECTOR QUALIFICATIONS**  
**702 QUALIFICATIONS**

**702.1 INSTALLER TRAINING.** HVAC system installers shall be trained and certified in the proper installation of HVAC systems including ducts and equipment by a nationally or regionally recognized training or certification program. Uncertified persons may perform HVAC installations when under the direct supervision and responsibility of a person trained and certified to install HVAC systems or contractor licensed to install HVAC systems. Examples of acceptable HVAC training and certification programs include but are not limited to the following:

- State certified apprenticeship programs.
- Public utility training programs.
- Training programs sponsored by trade, labor or statewide energy consulting or verification organizations.
- Programs sponsored by manufacturing organizations.
- Other programs acceptable to the enforcing agency.

**702.2 SPECIAL INSPECTION [HCD].** When required by the enforcing agency, the owner or the responsible entity acting as the owner's agent shall employ one or more special inspectors to provide inspection or other duties necessary to substantiate compliance with this code. Special inspectors shall demonstrate competence to the satisfaction of the enforcing agency for the particular type of inspection or task to be performed. In addition to other certifications or qualifications acceptable to the enforcing agency, the following certifications or education may be considered by the enforcing agency when evaluating the qualifications of a special inspector:

- Certification by a national or regional green building program or standard publisher.
- Certification by a statewide energy consulting or verification organization, such as HERS raters, building performance contractors, and home energy auditors.
- Successful completion of a third party apprentice training program in the appropriate trade.
- Other programs acceptable to the enforcing agency.

**Notes:**

- Special inspectors shall be independent entities with no financial interest in the materials or the project they are inspecting for compliance with this code.
- HERS raters are special inspectors certified by the California Energy Commission (CEC) to rate homes in California according to the Home Energy Rating System (HERS).

[BSC] When required by the enforcing agency, the owner or the responsible entity acting as the owner's agent shall employ one or more special inspectors to provide inspection or other duties necessary to substantiate compliance with this code. Special inspectors shall demonstrate competence to the satisfaction of the enforcing agency for the particular type of inspection or task to be performed. In addition, the special inspector shall have a certification from a recognized state, national or international association, as determined by the local agency. The area of certification shall be closely related to the primary job function, as determined by the local agency.

**Note:** Special inspectors shall be independent entities with no financial interest in the materials or the project they are inspecting for compliance with this code.

**703 VERIFICATIONS**  
**703.1 DOCUMENTATION.**

Documentation used to show compliance with this code shall include but is not limited to, construction documents, plans, specifications, builder or installer certification, inspection reports, or other methods acceptable to the enforcing agency which demonstrate substantial conformance. When specific documentation or special inspection is necessary to verify compliance, that method of compliance will be specified in the appropriate section or identified applicable checklist.



**Standard Erosion and Sediment Control Plan Requirements**

**a) Required Best Management Practices (BMPs).** The following BMPs for soil erosion sediment control shall be used, as applicable, in a Standard Erosion Control Plan. Install these BMPs shall conform to the requirements found in the documents and/or websites | Section 4 of this policy.

**Gravel Construction Entrance.** A gravel construction entrance is generally required where traffic is anticipated off of existing paved or graveled roads. If there is more than one vehicle point, a gravel construction entrance should be installed at each entrance. The responsibility design to meet site conditions, and maintenance of the construction entrances remains v property owner or construction contractor. The owner/contractor shall remain responsible clean-up of any mud or dirt that is tracked onto streets or paved areas, even with the install gravel construction entrances.

Vehicles or equipment shall not enter a property adjacent to a creek, watercourse, or storr facility unless adequate measures are installed to prevent physical erosion into the water.

**Catch Basin Protection.** A filter system shall be used on catch basins (drop inlets) in pul private streets, and parking areas as a means of sediment control. Alternate methods will require the approval of the City.

**Sediment Filters/Barriers.** For all projects, a silt fence or straw wattle dike shall be installed along the down slope edge of the disturbed area, prior to the commencement of grading. The sediment filter structures will be located so that all runoff from the construction site is filtered, or passes through a sediment detention basin prior to crossing a property line, entering a creek, or entering the City storm drain system. Sediment shall be removed when the depth of sediment exceeds one half of the height of the structure. Silt fences and straw wattles shall be installed according to the standard references cited.

**Straw wattles** can be used as dikes to stabilize temporary channel flow lines or as a perimeter filter barrier. Straw wattles must be installed in a trench, staked and backfilled if they are to be effective in reducing flow velocity and filtering sediment from runoff.

Straw wattles should not remain in place more than 12 months after installation unless it can be determining significant deterioration has not occurred. When used as a perimeter filter, sediment should be removed when material is within 3 inches of the top of any wattle.

**Silt fences** should be installed where sediment from sheet flow or rill and gully erosion will enter directly onto adjacent property. When installing, it is important the fabric material be anchored into a trench and backfilled.

Maintenance of filter fences is similar to that of straw wattles in that the fabric must be inspected and needed repairs implemented after every storm event. Sediment deposits shall be removed when material reaches a depth of more than one-half of the fence height.

**Plastic Sheeting** Plastic sheeting shall generally not be used as an erosion control measure over large areas. Plastic sheeting may be used to protect small, highly erodible areas, or to protect temporary stockpiles of material. If plastic sheeting is used, all resulting concentrated water flow from the plastic must be directed to a properly designed or existing drainage system able to handle the runoff without causing additional erosion.

**Existing Vegetation and Revegetation.** As far as is practicable, existing vegetation shall be protected and left in place, in accordance with the clearing limits shown on the approved Building Permit or Grading Permit and the approved Erosion Control Plans. The exception is where exotic plant materials are to be removed, or fire fuels reduced in accordance with an approved Plan. Work areas shall be carefully located and marked to reduce unnecessary damage to existing vegetation.

**Slope Protection:** Hydro-seeding alone will normally not be considered satisfactory erosion protection for disturbed slopes steeper than 4H:1V. Disturbed slopes steeper than 4H:1V shall be protected using straw and tackifier. The installation of erosion control blankets shall be required for all disturbed slopes steeper than 2.5H:1V and greater than 20 feet in slope length. Installation of straw wattles staked on contour shall be required for all slopes steeper than 4H:1V with slope lengths greater than 30 feet. Straw wattles or silt fencing shall be installed at the toe of all slopes steeper than 4H:1V, and along (just below) top of bank along all creeks.

**Wet Weather Measures.** On sites where vegetation and ground cover have been removed from more than 0.5 acre of land, vegetative ground cover shall be planted on or before **September 15** with the ground cover established by **October 15**. As an alternative, if a protective ground cover is not established by **October 15**, the open areas shall be protected through the winter with straw mulch, erosion blankets, the installation of additional straw wattles, or other method(s) approved by the City.

**Seeding.** Seeding shall be as follows, or as recommended by a California Licensed Landscape Architect or a Certified Professional Soil Erosion and Sediment Control Specialist.

SEED MIX ONE (Application rate = 40 kg/ha or 35 lb/ac)		SEED MIX TWO Application rate=40 kg/ha or 35 lbs/acre)	
blando bromo	40%	blando bromo	35%
zorro annual fescue	8%	rose clover	20%
lana vetch	12%	annual ryegrass	15%
rose clover	15%	crimson clover	10%
crimson clover	15%	creeping red fescue	5%
sub clover	10%	zorro annual fescue	5%
TOTAL	100%	TOTAL	100%

**Fertilizer**

12-12-12 450 kg/ha (400 lb/ac), or 15-15-15 340 kg/ha (300 lb/ac), or 16-20-0 340 kg/ha (300 lb/ac).

**Mulch**

Straw 3,400 kg/ha (3,000 lb/ac), or wood fiber (if hydroseeded) 2,300 kg/ha (2,000 lb/ac)

**b) Additional Erosion Control Measures.** In addition to the required best management practices, the following erosion control measures shall be implemented as part of the standard erosion control plan when applicable.

- During any clearing, earth moving and/or grading phases of the project, water trucks or sprinkler systems shall be used in sufficient quantities to prevent dust from leaving the site. In addition, the entire area of disturbed soils shall be wetted down during the early morning hours and at the end of each day in such a manner as to create a crust.
- During the construction phase of the project, water trucks or sprinkler systems shall be used to keep all areas of vehicular movement damp enough to prevent dust raised from leaving the site. As a minimum, this will include the wetting down of such areas in the late morning hours and at the close of each day's activities.
- All trucks hauling soil materials to and from the site shall be covered with a tarp to prevent dust from blowing off the truck.
- All alleyways, circulation routes, haul routes, streets and sidewalks shall be kept clean and clear of dirt, dust and debris in a manner acceptable to the City of Santa Barbara's Public Works Department as outlined in their "Procedures for the Control of Runoff into Storm Drains and Watercourses". At a minimum, said areas shall be cleaned at the end of each working day or more often if directed by City personnel. The flushing of dirt or debris to storm drain or sanitary sewer facilities shall not be permitted. Failure to keep these areas clean will result in the issuance of a "Stop Work" order, which will not be released until such time as the area is cleaned in a manner acceptable to the City. Earth moving and grading activities shall be limited to the hours between 7:00 A.M. and 6:00 P.M. or as specified in the approved Erosion Control Plan or the project conditions of approval.
- After the completion of the clearing, grading, or excavation phase, the entire area of disturbed soil shall be treated to prevent wind pick up of the soil. Any one of the following methods may accomplish this:
  - The seeding and or watering of the site until such time as the ground cover has taken root.
  - The spreading of soil binders.
  - The wetting down of the area in such a manner as to create a crust on the surface and the repeated soaking of the area, as necessary, to maintain the crust and prevent soil blowing.
- The contractor or builder shall designate a person or persons to monitor the storm water pollution prevention and dust control programs, and to order increased watering as necessary to prevent the transport of dust off-site, and additional BMPs to prevent storm water pollutants from entering public right-of-way. This person's duty shall include holiday and weekend periods when work may not be in progress. The name and telephone number of such person or persons shall be provided to the City of Santa Barbara Community Development Department and be placed on the plans.

**c) Protection Measure Removal**

The erosion prevention and sediment control measures shall remain in place and be maintained in good condition until all disturbed soil areas are permanently stabilized by installation and establishment of landscaping, grass, mulching, or are otherwise covered and protected from erosion.

**d) Standard Erosion Control Measures Submittal Requirements**

The plans sheets for a **Standard Erosion Control Plan** shall include the following information:

- Specific measures to be installed
- Specific locations where measures will be installed.
- Installation details.

**BMP Maintenance Requirements.**

The permittee shall maintain the facilities and erosion control measures prescribed in the approved *Erosion Control Plan (Standard or Detailed)* so as to continue to be effective throughout the construction and establishment of permanent vegetation phases of the project. If the facilities and techniques approved in the Erosion Control Plans are not effective or sufficient, as determined by a City site inspection, the permittee shall submit a revised Plan within three working days of written notification by the City of unacceptable site erosion conditions. Upon approval of the revised plan by the City, the permittee shall immediately implement the additional facilities and measures included in the revised plan. In cases where significant erosion is likely to occur, the City may require that the applicant install interim control measures prior to submittal of the revised Erosion Control Plan



**CONSTRUCTION SITE BEST MANAGEMENT PRACTICES**

THE FOLLOWING BMPs MUST BE PROPERLY USED AT ALL CONSTRUCTION SITES IN THE CITY TO PROTECT STORM DRAINS AND MINIMIZE POLLUTION

The City of Santa Barbara Building & Safety Division Erosion/Sedimentation Control Program SBMC 22.85.020 and SBMC 16.15.010 prohibit pollutant discharges at work sites from flowing into storm drains and polluting local creeks, water courses and the ocean.

To stay in compliance and keep your project on schedule, make sure BMPs are in place and functioning. Sites must be checked and maintained daily.

**PAINT AND STUCCO**

All paint and stucco materials stored on the site must be contained and covered. It is illegal to dump unused paint or stucco in the sewer or storm drain system. Do not wash out paint brushes in the street or dump any residues in the storm drain. Paint brushes and spray guns must be washed/cleaned out into a hazardous materials drum or back into the original container and disposed of properly.

**PERIMETER CONTROLS**

Gravel bags, silt fences and straw wattles (weighted or staked) are acceptable perimeter controls, and must be used to surround the entire site. Avoid running over perimeter controls with vehicles or heavy equipment as they can damage the materials. Keep extra absorbent materials and/or a wet-dry vacuum on site to quickly pick up unintended spills.

**BUILDING MATERIALS/STAGING AREAS**


All construction material must be stored on site at all times. Building materials should always be covered when not in use to prevent runoff caused by wind or rain. Flooding must also be prevented by monitoring your site before, during and after rain events to ensure that BMPs are functioning and that there are not any safety issues.

**TRAFFIC CONTROL PERMITS**

Any material or equipment in the Public Right of Way (such as dumpsters or trucks) require a Public Works Permit. To apply, contact Public Works at (805) 564-5388 or stop by the Public Works Counter at 630 Garden St. Information is also available at [www.santabarbara.gov/psd/permits/trafficcontrolpermits](http://www.santabarbara.gov/psd/permits/trafficcontrolpermits).

**DUMPSTERS**


Always cover dumpsters with a rollback tarp. Areas around dumpsters should be swept daily. Perimeter controls around dumpster areas should be provided if pollutants are leaking or discharging from the dumpster.

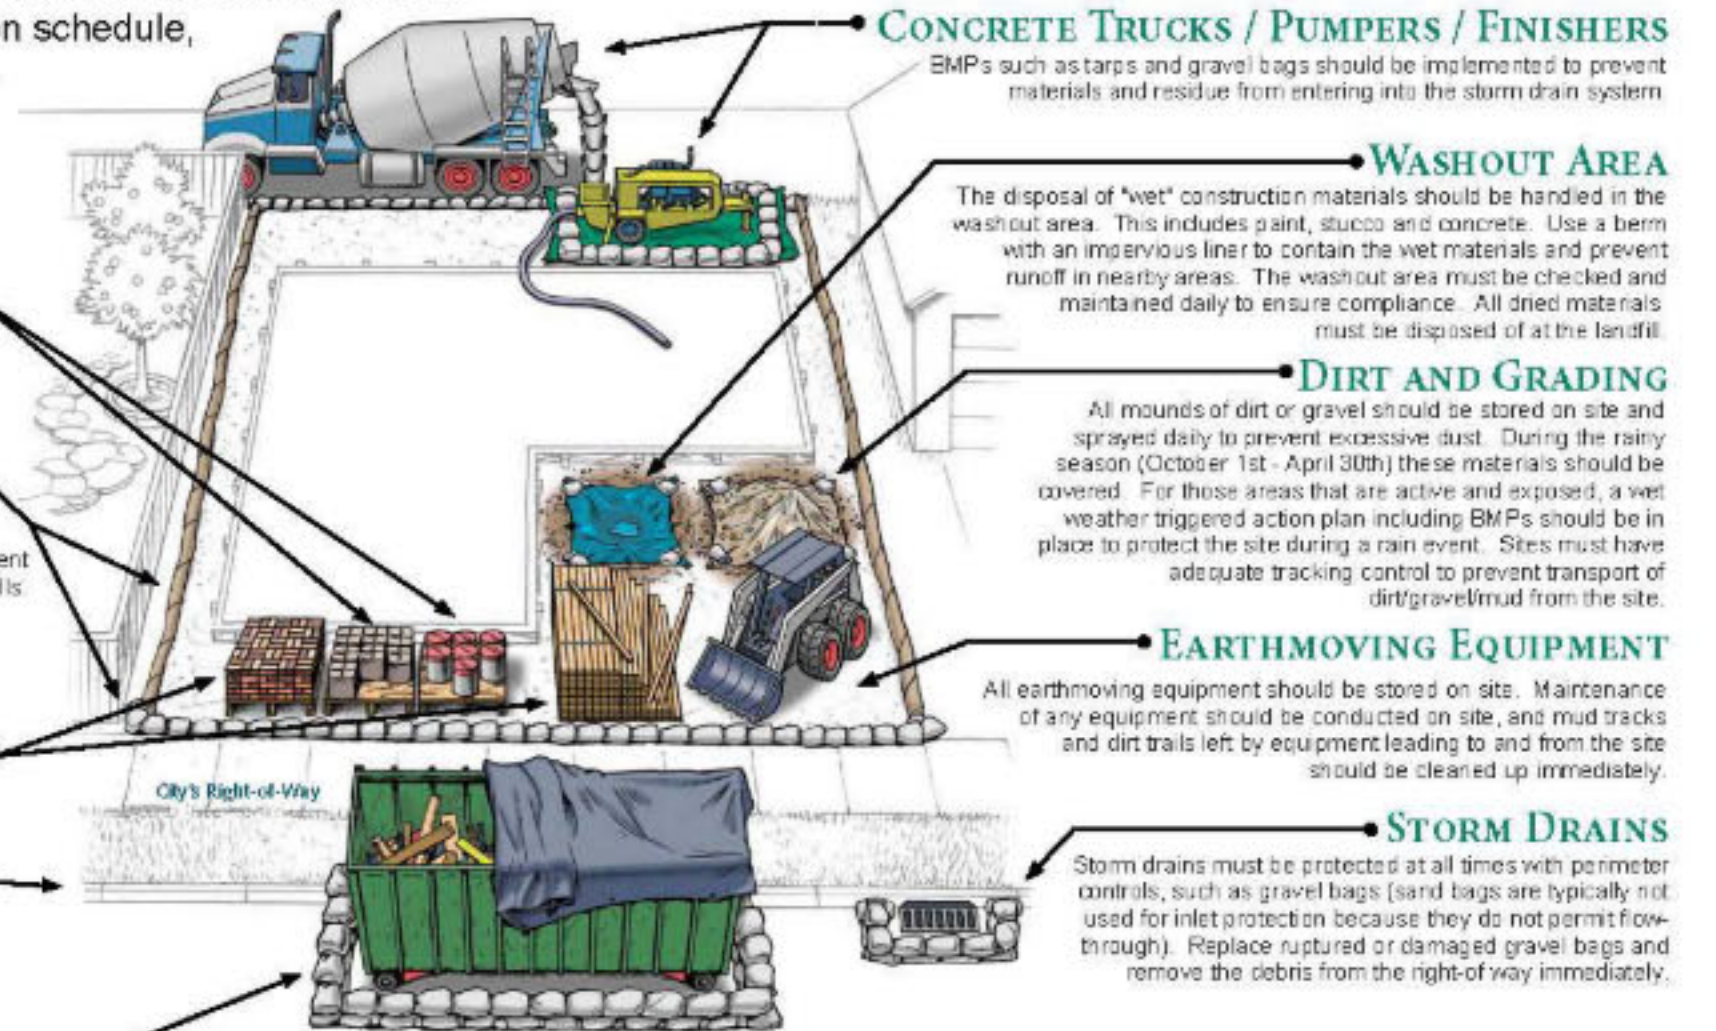

Protecting water resources improves and preserves Santa Barbara's quality of life for our children and future generations. Questions? Contact your Building Inspector or call Building & Safety at (805) 564-5485



## Stabilized Construction Entrance/Exit TC-1

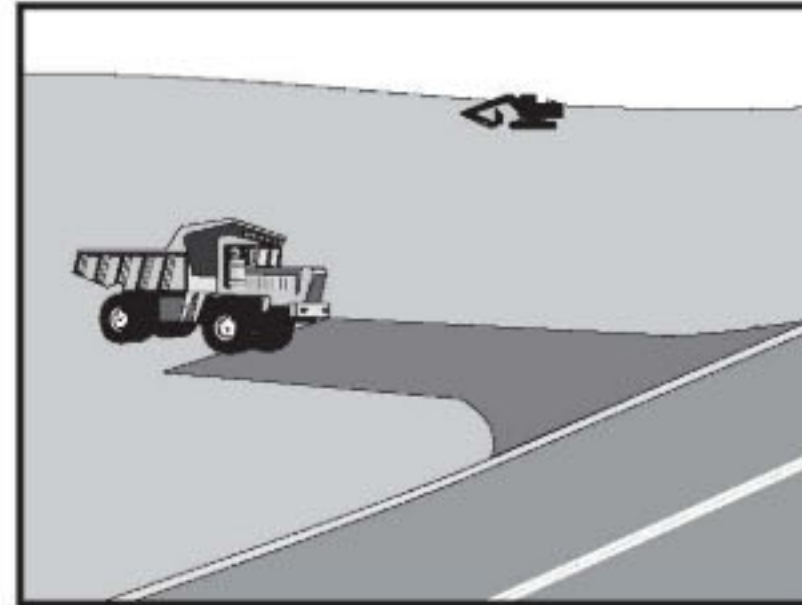

Categories	
EC	Erosion Control <input checked="" type="checkbox"/>
SE	Sediment Control <input checked="" type="checkbox"/>
TC	Tracking Control <input checked="" type="checkbox"/>
WE	Wind Erosion Control
NS	Non-Stormwater Management Control
WM	Waste Management and Materials Pollution Control
Legend:	
<input checked="" type="checkbox"/>	Primary Objective
<input type="checkbox"/>	Secondary Objective

Targeted Constituents	
Sediment	<input checked="" type="checkbox"/>
Nutrients	
Trash	
Metals	
Bacteria	
Oil and Grease	
Organics	
Potential Alternatives	
None	

### Description and Purpose

A stabilized construction access is defined by a point of entrance/exit to a construction site that is stabilized to reduce the tracking of mud and dirt onto public roads by construction vehicles.

### Suitable Applications

Use at construction sites:

- Where dirt or mud can be tracked onto public roads.
- Adjacent to water bodies.
- Where poor soils are encountered.
- Where dust is a problem during dry weather conditions.

### Limitations

- Entrances and exits require periodic top dressing with additional stones.
- This BMP should be used in conjunction with street sweeping on adjacent public right of way.
- Entrances and exits should be constructed on level ground only.
- Stabilized construction entrances are rather expensive to construct and when a wash rack is included, a sediment trap of some kind must also be provided to collect wash water.



## Stabilized Construction Entrance/Exit TC-1

runoff.

### Implementation

#### General

A stabilized construction entrance is a pad of aggregate underlain with filter cloth located at any point where traffic will be entering or leaving a construction site to or from a public right of way, street, alley, sidewalk, or parking area. The purpose of a stabilized construction entrance is to reduce or eliminate the tracking of sediment onto public rights of way or streets. Reducing tracking of sediments and other pollutants onto paved roads helps prevent deposition of sediments into local storm drains and production of airborne dust.

Where traffic will be entering or leaving the construction site, a stabilized construction entrance should be used. NPDES permits require that appropriate measures be implemented to prevent tracking of sediments onto paved roadways, where a significant source of sediments is derived from mud and dirt carried out from unpaved roads and construction sites.

Stabilized construction entrances are moderately effective in removing sediment from equipment leaving a construction site. The entrance should be built on level ground. Advantages of the Stabilized Construction Entrance/Exit is that it does remove some sediment from equipment and serves to channel construction traffic in and out of the site at specified locations. Efficiency is greatly increased when a washing rack is included as part of a stabilized construction entrance/exit.

#### Design and Layout

- Construct on level ground where possible.
- Select 3 to 6 in. diameter stones.
- Use minimum depth of stones of 12 in. or as recommended by soils engineer.
- Construct length of 50 ft minimum, and 30 ft minimum width.
- Rumble racks constructed of steel panels with ridges and installed in the stabilized entrance/exit will help remove additional sediment and to keep adjacent streets clean.
- Provide ample turning radii as part of the entrance.
- Limit the points of entrance/exit to the construction site.
- Limit speed of vehicles to control dust.
- Properly grade each construction entrance/exit to prevent runoff from leaving the construction site.
- Route runoff from stabilized entrances/exits through a sediment trapping device before discharge.
- Design stabilized entrance/exit to support heaviest vehicles and equipment that will use it.

## Stabilized Construction Entrance/Exit TC-1

- Select construction access stabilization (aggregate, asphaltic concrete, concrete) based on longevity, required performance, and site conditions. Do not use asphalt concrete (AC) grindings for stabilized construction access/roadway.
  - If aggregate is selected, place crushed aggregate over geotextile fabric to at least 12 in. depth, or place aggregate to a depth recommended by a geotechnical engineer. A crushed aggregate greater than 3 in. but smaller than 6 in. should be used.
  - Designate combination or single purpose entrances and exits to the construction site.
  - Require that all employees, subcontractors, and suppliers utilize the stabilized construction access.
  - Implement SE-7, Street Sweeping and Vacuuming, as needed.
  - All exit locations intended to be used for more than a two-week period should have stabilized construction entrance/exit BMPs.
- ### Inspection and Maintenance
- Inspect and verify that activity-based BMPs are in place prior to the commencement of associated activities. While activities associated with the BMPs are under way, inspect weekly during the rainy season and of two-week intervals in the non-rainy season to verify continued BMP implementation.
  - Inspect local roads adjacent to the site daily. Sweep or vacuum to remove visible accumulated sediment.
  - Remove aggregate, separate and dispose of sediment if construction entrance/exit is clogged with sediment.
  - Keep all temporary roadway ditches clear.
  - Check for damage and repair as needed.
  - Replace gravel material when surface voids are visible.
  - Remove all sediment deposited on paved roadways within 24 hours.
  - Remove gravel and filter fabric at completion of construction.

## Stabilized Construction Entrance/Exit TC-1

National Management Measures to Control Nonpoint Source Pollution from Urban Areas, USEPA Agency, 2002.

Proposed Guidance Specifying Management Measures for Sources of Nonpoint Pollution in Coastal Waters, Work Group Working Paper, USEPA, April 1992.

Stormwater Quality Handbooks Construction Site Best Management Practices (BMPs) Manual, State of California Department of Transportation (Caltrans), November 2000.


Stormwater Management of the Puget Sound Basin, Technical Manual, Publication #91-75, Washington State Department of Ecology, February 1992.

Virginia Erosion and Sedimentation Control Handbook, Virginia Department of Conservation and Recreation, Division of Soil and Water Conservation, 1991.


Guidance Specifying Management Measures for Nonpoint Pollution in Coastal Waters, EPA 840-B-9-002, USEPA, Office of Water, Washington, DC, 1993.

Water Quality Management Plan for the Lake Tahoe Region, Volume II, Handbook of Management Practices, Tahoe Regional Planning Agency, November 1988.

## Stabilized Construction Entrance/Exit TC-1

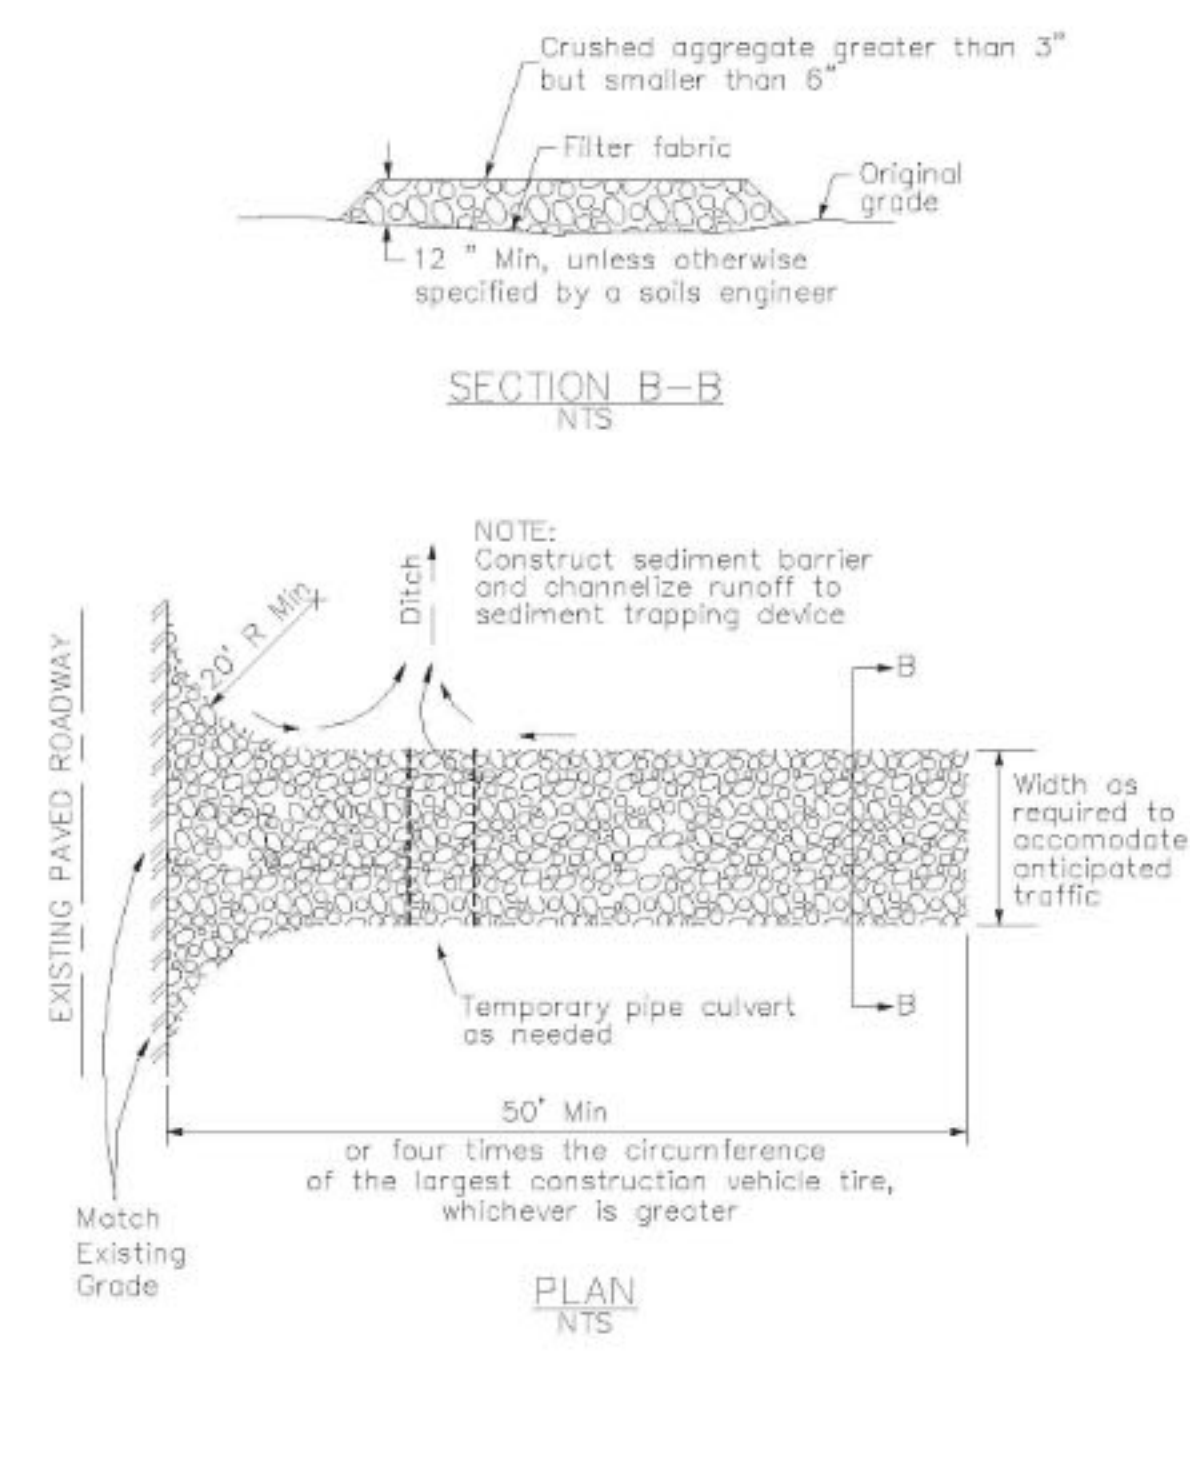

## Stabilized Construction Entrance/Exit TC-1

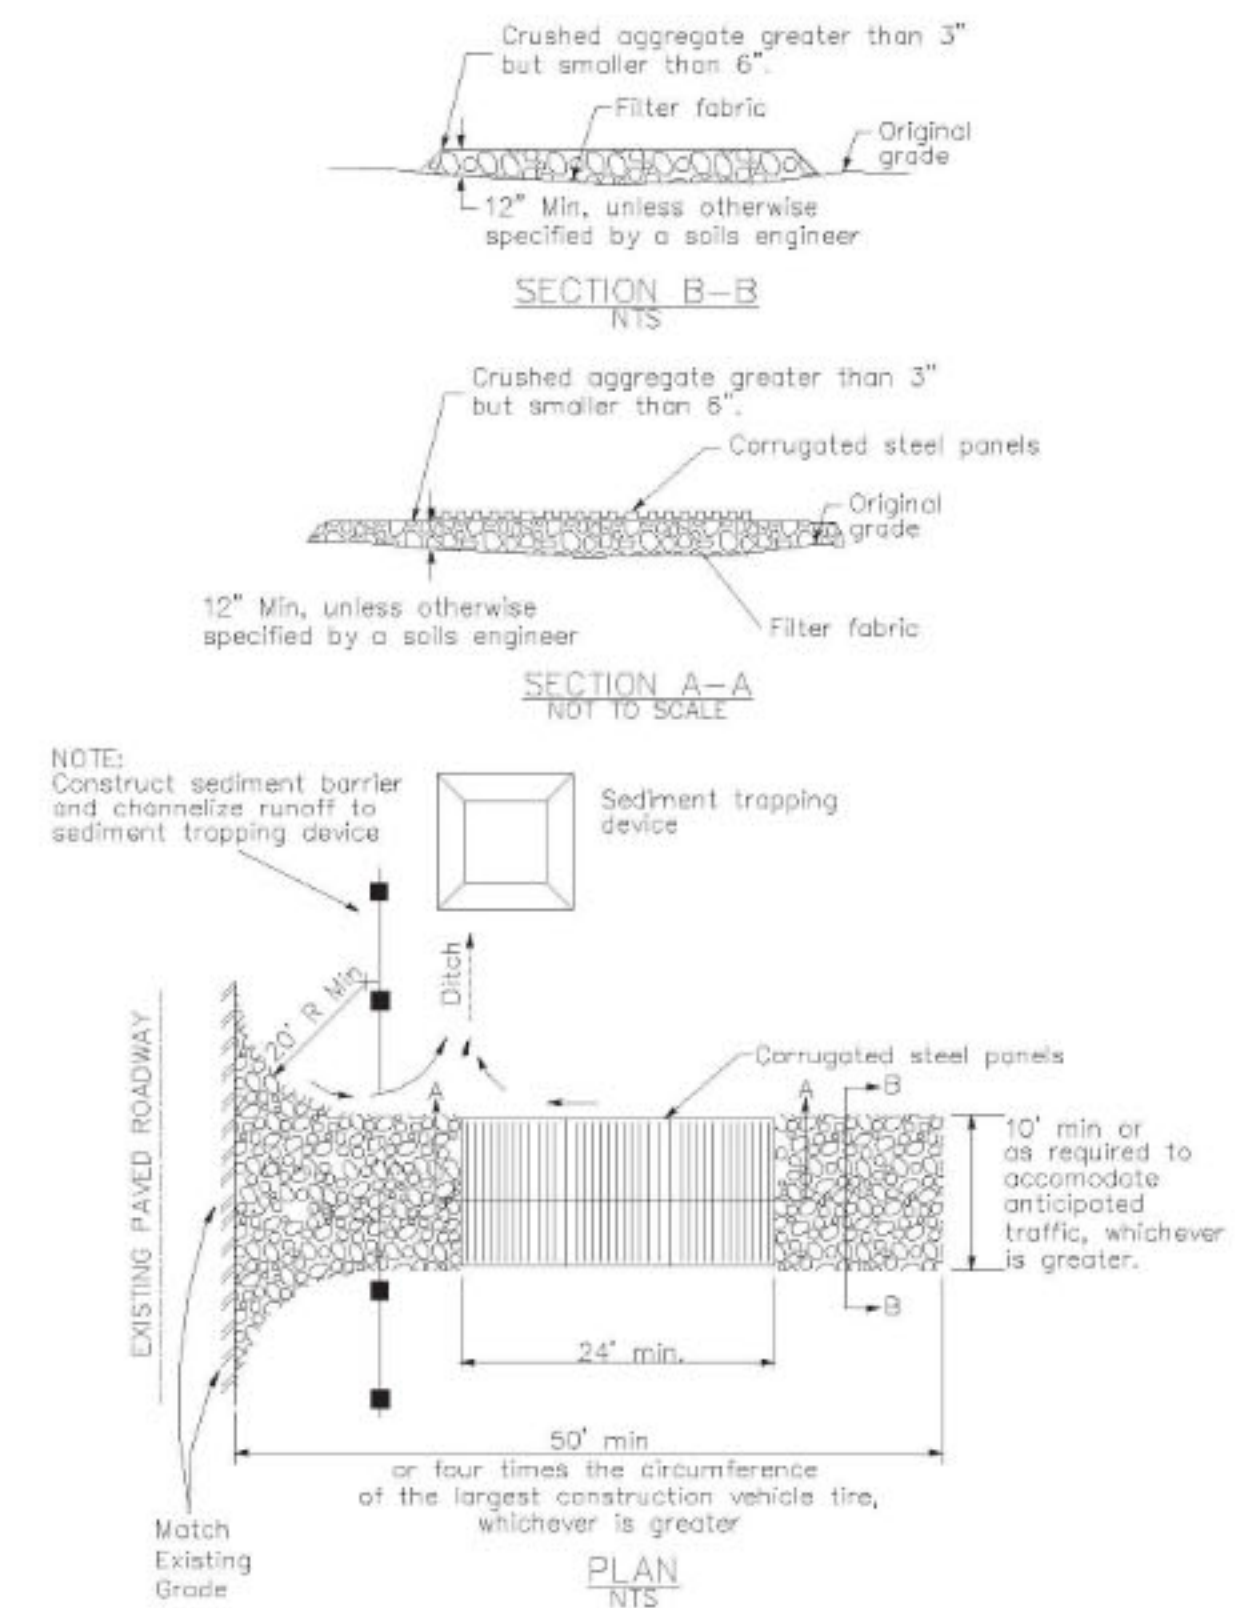


**City of Santa Barbara**  
 EROSION / SEDIMENTATION CONTROL AND  
 STORMWATER QUALITY MANAGEMENT PROGRAM

Standard  
BMP-2



# Temporary Silt Fence

SC-1

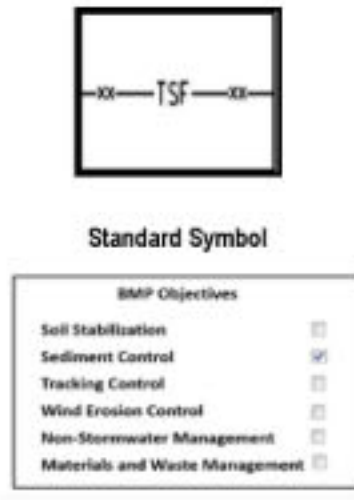

## Definition and Purpose

A silt fence is a temporary linear sediment barrier of permeable fabric designed to intercept and slow the flow of sediment-laden sheet flow runoff. Silt fences allow sediment to settle from runoff before water leaves the construction site.

## Appropriate Applications

- Below the toe of exposed and erodible slopes.
- Down-slope of exposed soil areas.
- Around temporary stockpiles.
- Along streams and channels.
- Along the perimeter of a project.

## Limitations

- Not effective unless trenched and keyed in.
- Not intended for use as mid-slope protection on slopes greater than 4:1 (H:V).
- Must be maintained.
- Must be removed and disposed of.
- Don't use below slopes subject to creep, slumping, or landslides.

# Temporary Silt Fence

SC-1

- Don't use in streams, channels, drain inlets, or anywhere flow is concentrated.
- Don't use silt fences to divert flow.
- Don't use in locations where ponded water may cause a flooding hazard.

## Standards and Specifications

### Design and Layout

The drainage area above any fence should not exceed a quarter of an acre, (100-feet of silt fence per 10,000 square feet of DSA).

Slope of area draining to silt fence should be less than 1:1 (H:V).

Silt fences must be placed parallel to the slope contour.

Silt fences rely on temporary ponding to encourage sediment deposition and achieve water quality benefits. Limit application to areas where ponding and deposition may occur on the uphill side of the silt fence.

Temporary silt fence fabrics generally have life spans ranging between five and eight months. Projects with longer durations may require replacing silt fence fabric.

Silt fences constructed across concentrated flows are susceptible to washout. Silt fences shall not be installed across concentrated flows.

For slopes adjacent to water bodies or Environmentally Sensitive Areas (ESAs), additional temporary soil stabilization BMPs should be used.

For any 50 foot section of silt fence, the elevation of the base of the fence may not vary by more than 1/3 of the fence height.

Install along a level contour, so water does not pond more than 1.5 ft at any point along the silt fence.

Join separate sections to form reaches not more than 500 feet without openings. Ensure there are no gaps between posts.

### Reinforced Silt Fence

Temporary reinforced silt fence is typically used in areas affected by high winds. They are also often used on slopes steeper than 2:1 (H:V) that contain a high number of rocks or large dirt clods that tend to dislodge, or where area draining fence contains moderate sediment loads.

Temporary reinforced silt fence (type 2) may also be used to provide sediment control and delineate ESAs.

# Temporary Silt Fence

SC-1

## Materials

Silt fence fabric should be a woven or unwoven geosynthetic textile that complies with Section 96-1.02E of the Standard Specifications. The Contractor must submit a certificate of compliance for silt fence fabric in accordance with Standard Specifications Section 6-2.03C.

Wood posts should be untreated fir, redwood, cedar, or pine lumber. Each silt fence post should be at least 4 feet long, except reinforced silt fence posts should be at least 6 feet for Type 1 and 5 feet for Type 2 installations. Posts should be free from decay, splits or cracks longer than the thickness of the post or other defects that would weaken the posts and cause the posts to be structurally unsuitable. Steel posts may be used as well. Posts should comply with the requirements in Standard Specifications sections 16-2.03B and 13-10.02C.

Anchors may be used. Anchors consist of a number 4 steel reinforcing bar. End protection shall be provided for any exposed bar reinforcement.

Staples used to fasten the fence fabric to the posts and to join adjacent silt fence sections shall be U-shaped and have 1/2-inch legs and a 1-inch crown. Staples should be 1/16-inch in diameter. At least four staples should be installed on each silt fence post for adequate fastening, with a maximum of 8-inches between each staple.

## Installation

Install in accordance with Pages 5 and 6 of this BMP (Standard Plans T51 "Temporary Silt Fence" and T60 "Temporary Reinforced Silt Fence").

Generally, silt fences should be used in conjunction with soil stabilization source controls up slope to provide effective erosion and sediment control.

Excavate a trench that is 6-inches deep and 6-inches wide with a length consistent with the project design plans. Place the bottom of the silt fence fabric in the trench. Backfill the trench with soil over the base of the silt fence fabric. Compact the backfill soil by hand or mechanical methods.

Construct the length of each reach so that the change in base elevation along any 50-foot reach does not exceed 1/3 the height of the barrier; in no case should any reach of temporary silt fence exceed 500 feet in length.

Construct silt fences with a set-back of at least 3 feet from the toe of a slope. Where a silt fence is determined to be not practical with a 3 foot set-back from the toe due to specific site conditions, the silt fence may be constructed at the toe of the slope, but should be constructed as far from the toe of the slope as practical.

# Temporary Silt Fence

SC-1

## Maintenance and Inspection

- Repair undercut silt fences.
- Repair or replace split, torn, slumping, or weathered fabric.
- Inspect silt fence when rain is forecast. Perform necessary maintenance, or maintenance required by the Engineer.
- Inspect silt fence following rain events. Perform maintenance as necessary, or as required by the Engineer.
- Maintain silt fences to provide an adequate sediment holding capacity. Sediment should be removed when the sediment accumulation reaches one-third (1/3) of the barrier height.

Silt fences that are damaged and become unsuitable for the intended purpose should be removed from the site of work, disposed of outside the highway right of way in conformance with the Standard Specifications, and replaced with new silt fence barriers.


Holes, depressions or other ground disturbance caused by the removal of the temporary silt fences should be backfilled and repaired in conformance with the Standard Specifications.

Remove silt fence when no longer needed. Fill and compact post holes and anchorage trench, remove sediment accumulation, and grade fence alignment to blend with adjacent ground.

Silt Fence placement is to be shown in the WPCDs along with other BMPs.

## SWPPP or WPCP

Temporary Silt Fence or Reinforced Silt Fence must be discussed in Section 500.3.3 of the SWPPP or Section 30.2.2 of the WPCP.

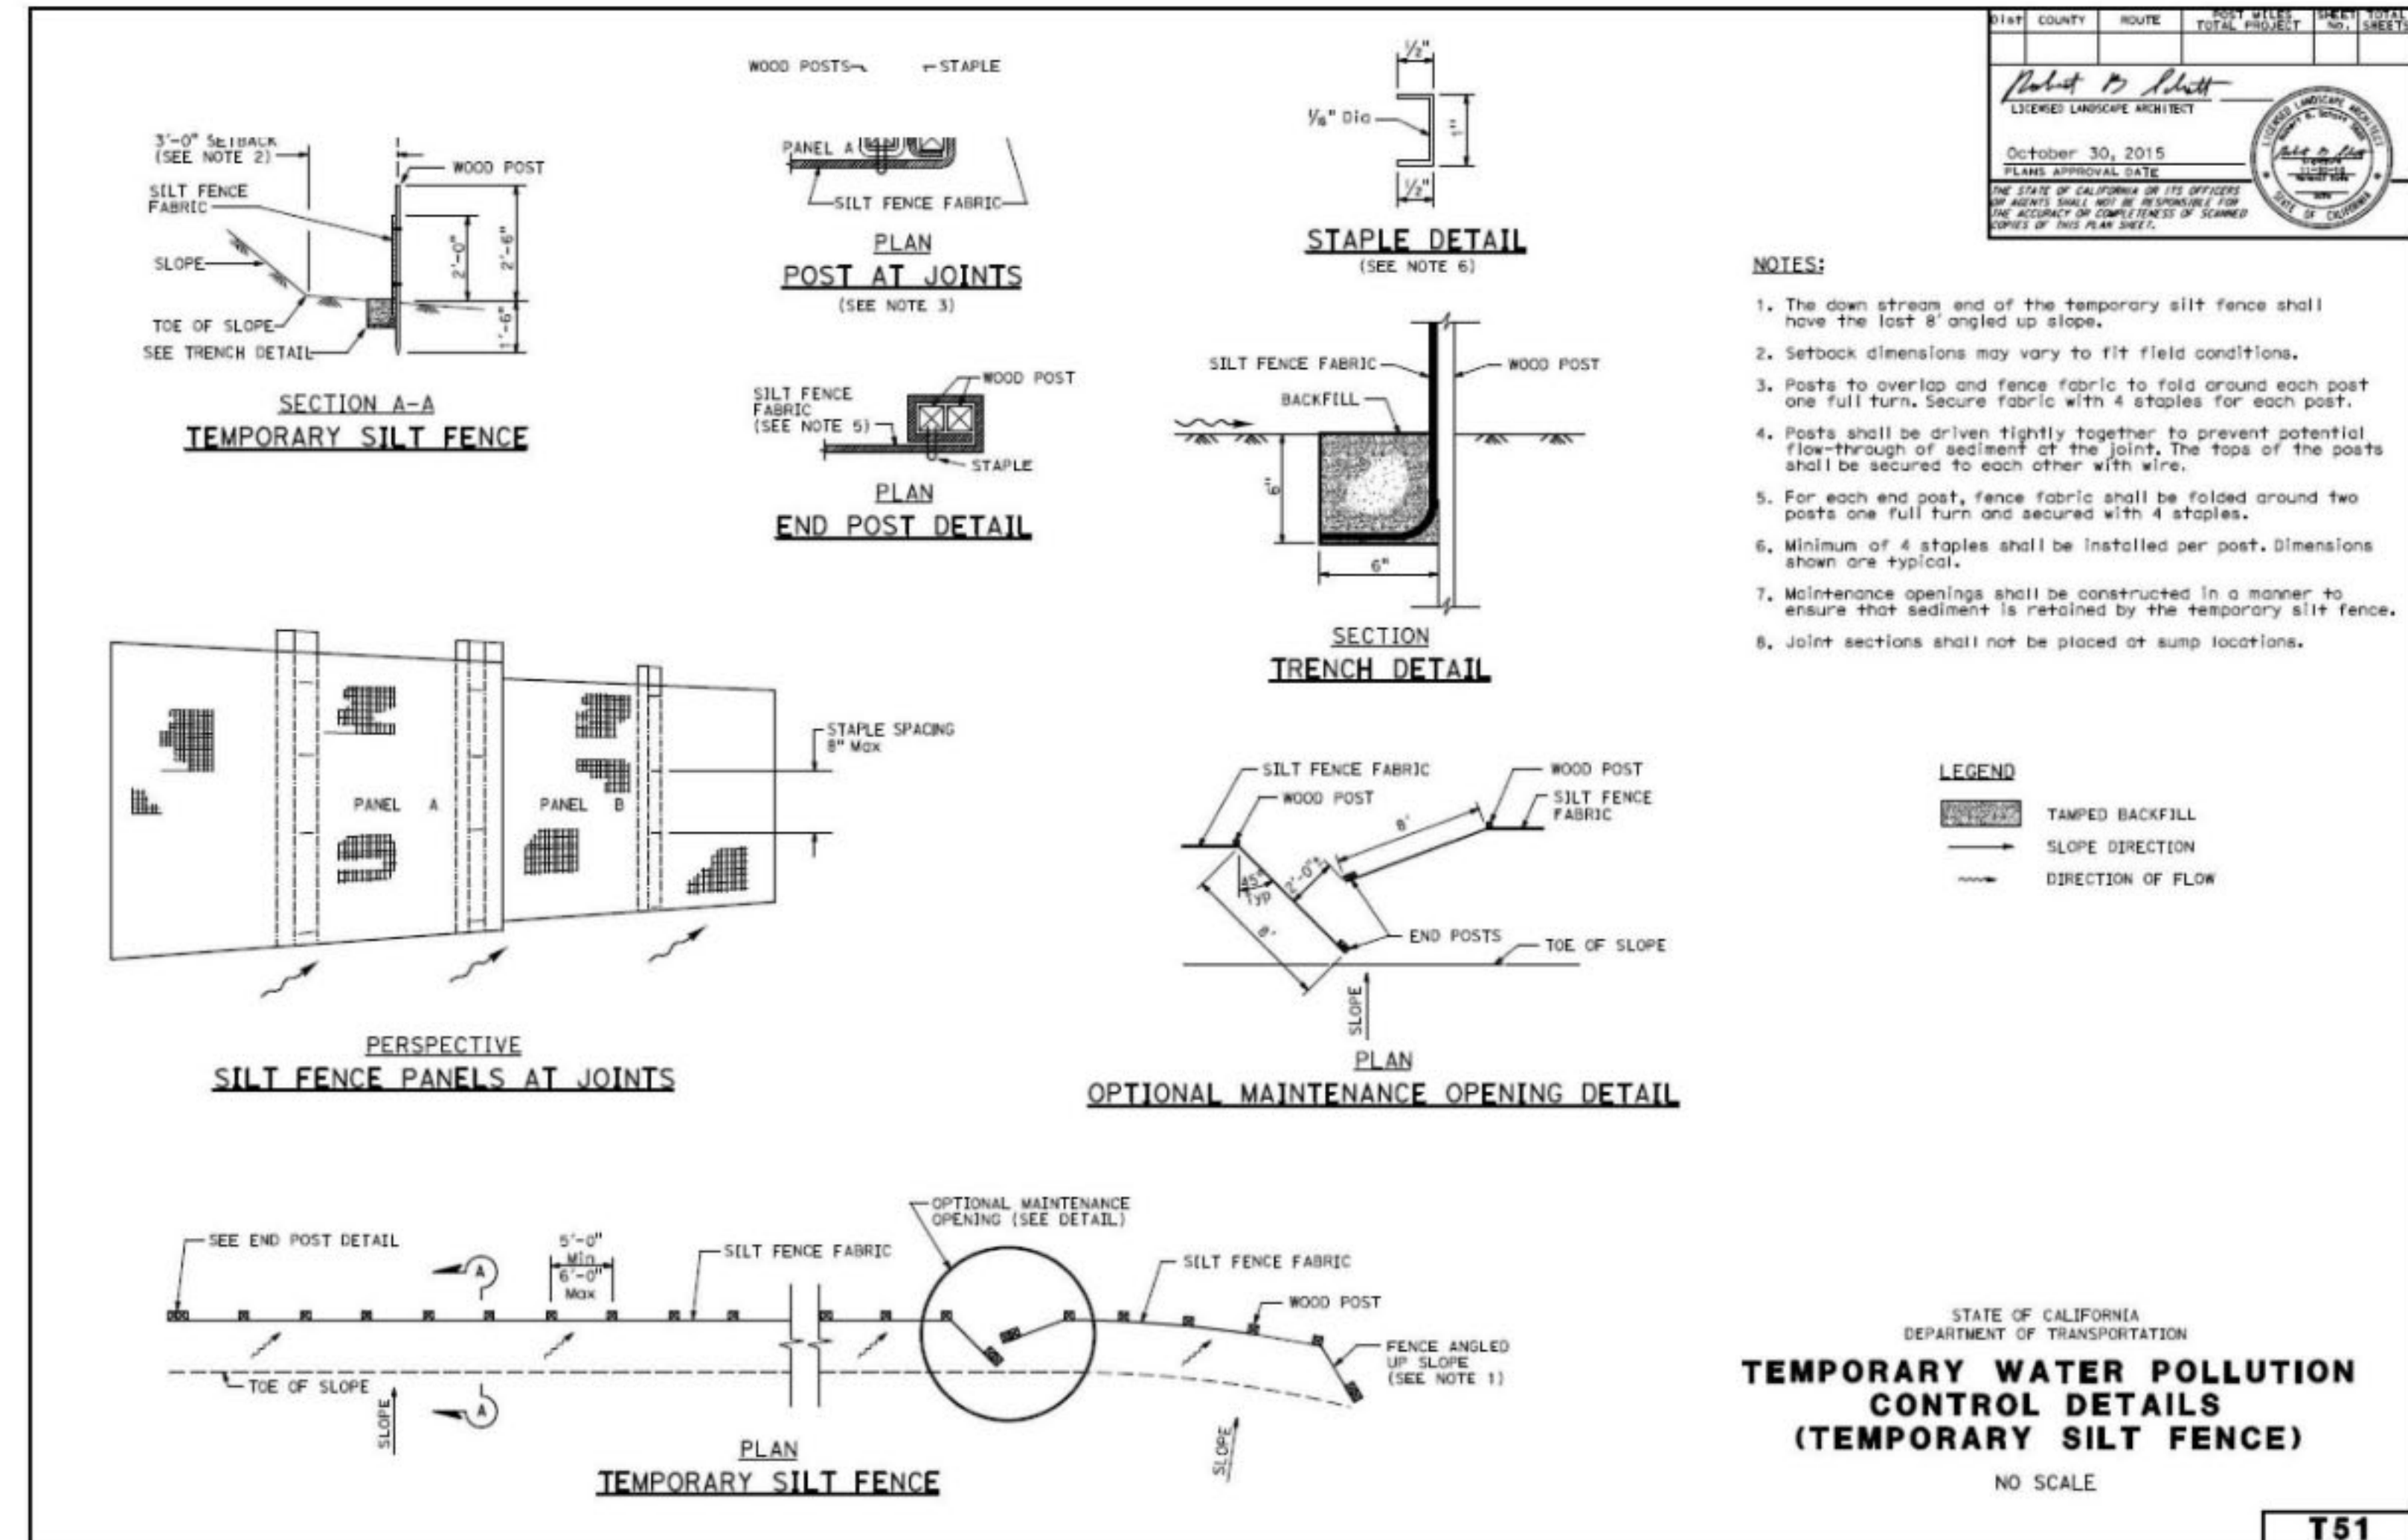


**City of Santa Barbara**  
 EROSION / SEDIMENTATION CONTROL AND  
 STORMWATER QUALITY MANAGEMENT PROGRAM

Standard  
**BMP-3**



## Fiber Rolls

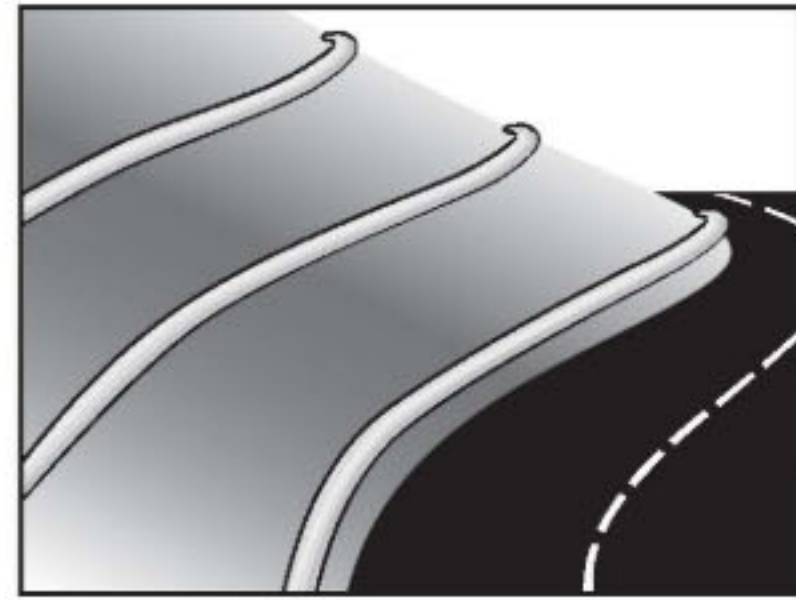

### Description and Purpose

A fiber roll consists of straw, coir, or other biodegradable materials bound into a tight tubular roll wrapped by netting, which can be photodegradable or natural. Additionally, gravel core fiber rolls are available, which contain an imbedded ballast material such as gravel or sand for additional weight when staking the rolls are not feasible (such as use as inlet protection). When fiber rolls are placed at the toe and on the face of slopes along the contours, they intercept runoff, reduce its flow velocity, release the runoff as sheet flow, and provide removal of sediment from the runoff (through sedimentation). By interrupting the length of a slope, fiber rolls can also reduce sheet and rill erosion until vegetation is established.

### Suitable Applications

Fiber rolls may be suitable:

- Along the toe, top, face, and at grade breaks of exposed and erodible slopes to shorten slope length and spread runoff as sheet flow.
- At the end of a downward slope where it transitions to a steeper slope.
- Along the perimeter of a project.
- As check dams in unlined ditches with minimal grade.
- Down-slope of exposed soil areas.
- At operational storm drains as a form of inlet protection.

## SE-5

Categories	
EC	Erosion Control <input checked="" type="checkbox"/>
SE	Sediment Control <input checked="" type="checkbox"/>
TC	Tracking Control
WE	Wind Erosion Control
NS	Non-Stormwater Management Control
WM	Waste Management and Materials Pollution Control

Legend:

Primary Category

Secondary Category

### Targeted Constituents

Sediment	<input checked="" type="checkbox"/>
Nutrients	
Trash	
Metals	
Bacteria	
Oil and Grease	
Organics	

### Potential Alternatives

SE-1 Silt Fence
SE-6 Gravel Bag Berm
SE-8 Sandbag Barrier
SE-14 Biofilter Bags



## Fiber Rolls

## SE-5

- Around temporary stockpiles.
- Limitations**
- Fiber rolls are not effective unless trenched in and staked.
  - Not intended for use in high flow situations.
  - Difficult to move once saturated.
  - If not properly staked and trenched in, fiber rolls could be transported by high flows.
  - Fiber rolls have a very limited sediment capture zone.
  - Fiber rolls should not be used on slopes subject to creep, slumping, or landslide.
  - Rolls typically function for 12-24 months depending upon local conditions.

### Implementation

#### Fiber Roll Materials

- Fiber rolls should be prefabricated.
- Fiber rolls may come manufactured containing polyacrylamide (PAM), a flocculating agent within the roll. Fiber rolls impregnated with PAM provide additional sediment removal capabilities and should be used in areas with fine, clayey or silty soils to provide additional sediment removal capabilities. Monitoring may be required for these installations.
- Fiber rolls are made from weed free rice straw, flax, or a similar agricultural material bound into a tight tubular roll by netting.
- Typical fiber rolls vary in diameter from 9 in. to 20 in. Larger diameter rolls are available as well.

### Installation

- Locate fiber rolls on level contours spaced as follows:
  - Slope inclination of 4:1 (H:V) or flatter: Fiber rolls should be placed at a maximum interval of 20 ft.
  - Slope inclination between 4:1 and 2:1 (H:V): Fiber Rolls should be placed at a maximum interval of 15 ft. (a closer spacing is more effective).
  - Slope inclination 2:1 (H:V) or greater: Fiber Rolls should be placed at a maximum interval of 10 ft. (a closer spacing is more effective).
- Prepare the slope before beginning installation.
- Dig small trenches across the slope on the contour. The trench depth should be 1/4 to 1/3 of the thickness of the roll, and the width should equal the roll diameter, in order to provide area to backfill the trench.

## Fiber Rolls

## SE-5

- It is critical that rolls are installed perpendicular to water movement, and parallel to the slope contour.
- Start building trenches and installing rolls from the bottom of the slope and work up.
- It is recommended that pilot holes be driven through the fiber roll. Use a straight bar to drive holes through the roll and into the soil for the wooden stakes.
- Turn the ends of the fiber roll up slope to prevent runoff from going around the roll.
- Stake fiber rolls into the trench.
  - Drive stakes at the end of each fiber roll and spaced 4 ft maximum on center.
  - Use wood stakes with a nominal classification of 0.75 by 0.75 in. and minimum length of 24 in.
- If more than one fiber roll is placed in a row, the rolls should be overlapped, not abutted.
- See typical fiber roll installation details at the end of this fact sheet.

### Removal

- Fiber rolls can be left in place or removed depending on the type of fiber roll and application (temporary vs. permanent installation). Typically, fiber rolls encased with plastic netting are used for a temporary application because the netting does not biodegrade. Fiber rolls used in a permanent application are typically encased with a biodegradable material and are left in place. Removal of a fiber roll used in a permanent application can result in greater disturbance.
- Temporary installations should only be removed when up gradient areas are stabilized per General Permit requirements, and/or pollutant sources no longer present a hazard. But, they should also be removed before vegetation becomes too mature so that the removal process does not disturb more soil and vegetation than is necessary.

### Inspection and Maintenance

- BMPs must be inspected in accordance with General Permit requirements for the associated project type and risk level. It is recommended that at a minimum, BMPs be inspected weekly, prior to forecasted rain events, daily during extended rain events, and after the conclusion of rain events.
- Repair or replace split, torn, unraveling, or slumping fiber rolls.
- If the fiber roll is used as a sediment capture device, or as an erosion control device to maintain sheet flows, sediment that accumulates in the BMP should be periodically removed.

## Fiber Rolls


## SE-5

- In order to maintain BMP effectiveness. Sediment should be removed when sediment accumulation reaches one-third the designated sediment storage depth.
- If fiber rolls are used for erosion control, such as in a check dam, sediment removal should not be required as long as the system continues to control the grade. Sediment control BMPs will likely be required in conjunction with this type of application.
- Repair any rills or gullies promptly.

### References


Stormwater Quality Handbooks – Construction Site Best Management Practices (BMPs) Manual, State of California Department of Transportation (Caltrans), March 2003.

Erosion and Sediment Control Manual, Oregon Department of Environmental Quality, February 2005.

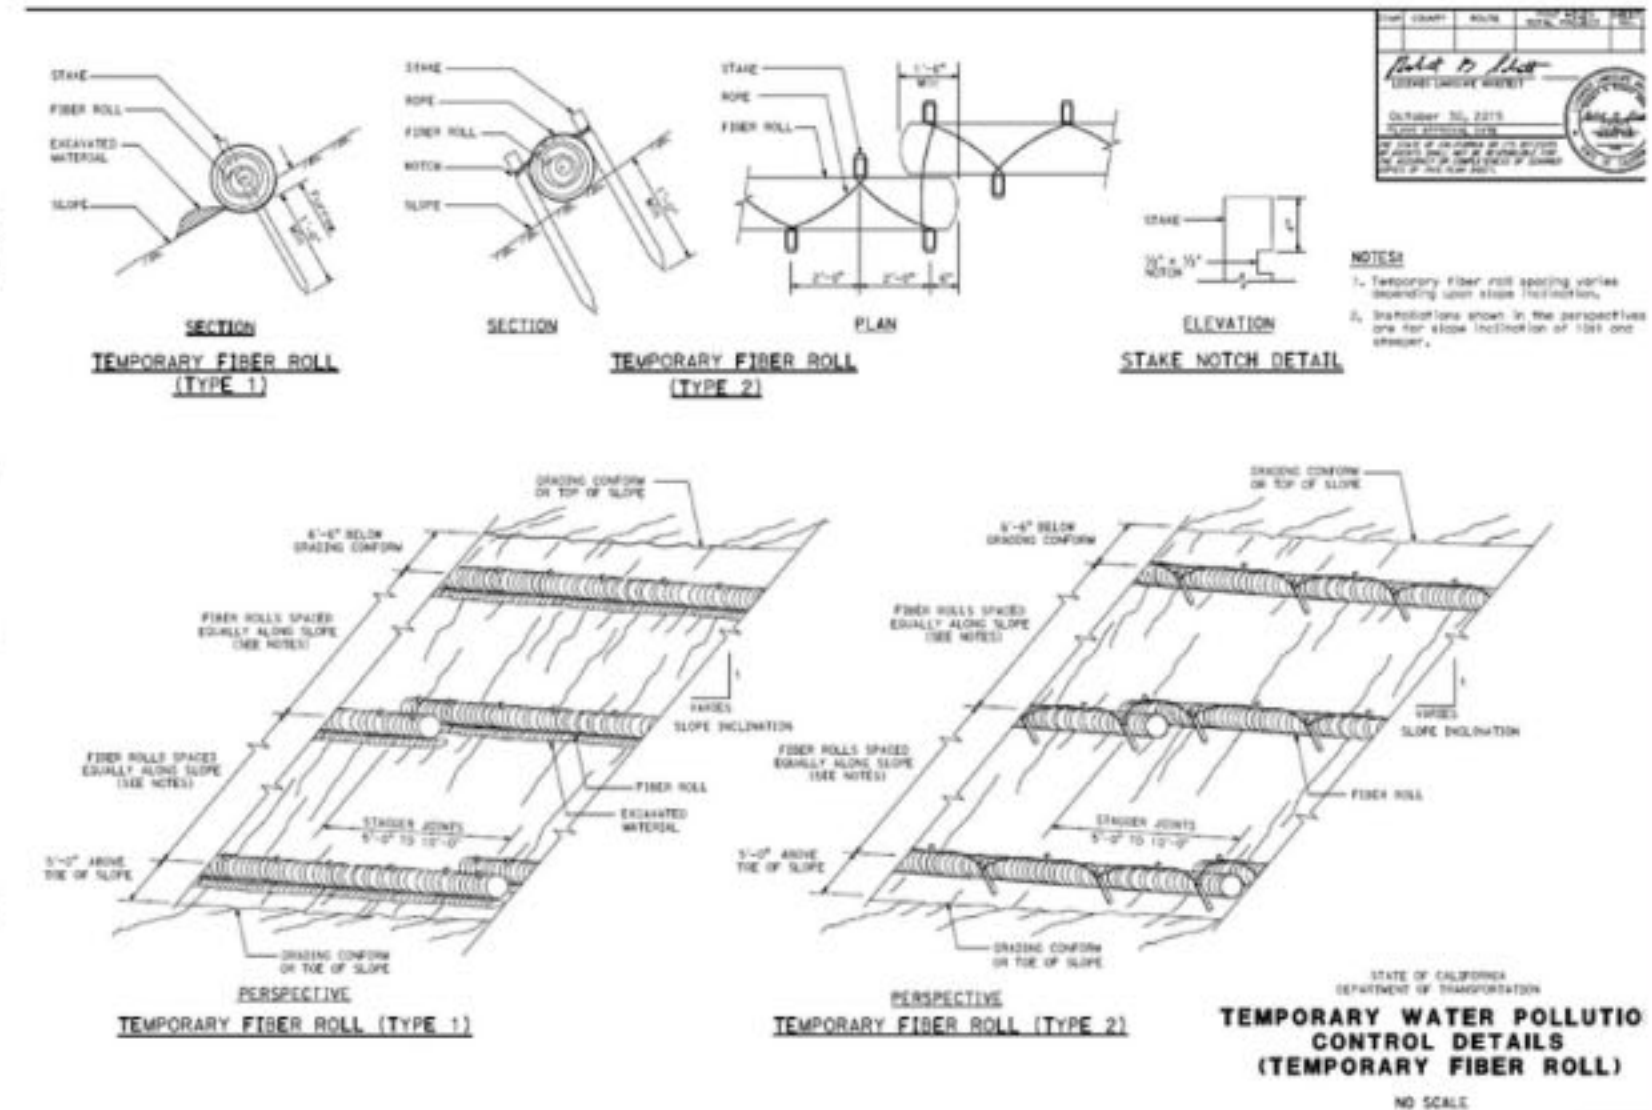

## Straw Bale Barrier

## SC-9

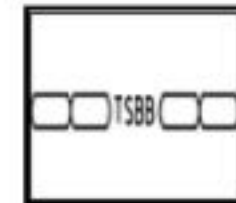

### Standard Symbol

BMP Objectives	
Soil Stabilization	<input type="checkbox"/>
Sediment Control	<input checked="" type="checkbox"/>
Tracking Control	<input type="checkbox"/>
Wind Erosion Control	<input type="checkbox"/>
Non-Stormwater Management	<input type="checkbox"/>
Materials and Waste Management	<input type="checkbox"/>

### Definition and Purpose

A straw bale barrier is a temporary linear sediment barrier consisting of straw bales, designed to intercept and slow sediment-laden sheet flow runoff. Straw bale barriers allow sediment to settle from runoff before water leaves the construction site.

### Appropriate Applications

- Along the perimeter of a site.
- Along streams and channels.
- Below the toe of exposed and erodible slopes.
- Down slope of exposed soil areas.
- Around stockpiles.
- Across minor swales or ditches with small catchments.
- Around above grade type temporary concrete washouts (see WM-8, "Concrete Waste Management").
- Parallel to a roadway to keep sediment off paved areas.

### Limitations

Installation can be labor intensive.

Straw bale barriers are maintenance intensive.

## Straw Bale Barrier

## SC-9

Degraded straw bales may fall apart when removed or left in place for extended periods.

Can't be used on paved surfaces.

Not to be used for drain inlet protection.

Not to be used in areas of concentrated flow.

Can be an attractive food source for some animals.

May introduce undesirable non-native plants to the area.

### Standards and Specifications

#### Materials

Straw must conform to the provisions in Standard Specifications Section 21-2.02H, "Straw."

Each straw bale should be a minimum of 14 in wide, 18 in high, 36 in long and have a minimum weight of 50 lb.

The straw bale must be composed entirely of vegetative matter, except for the binding material.

Bales can be bound by either wire, nylon, or polypropylene string placed horizontally. Jute and cotton binding may not be used. Baling wire should be at least 16 gauge. Nylon or polypropylene string should have a diameter of approximately 0.08 in with a breaking strength of 80 lbs.

Wood or metal posts should be used as stakes. Posts for straw bale barriers must comply with Standard Specifications Section 16-2.03 "High-Visibility Fences."

#### Installation

Place a single row of straw bales end-to-end and parallel with the slope contour. For any 20-foot section of straw bale barrier, do not allow it to vary by more than 5% from level.

Place straw bales in a trench or key them into the slope. Place the bales such that the binding wire or string does not come in contact with the soil. Use wood or metal posts as stakes.

Secure each straw bale with two posts. The first post in each bale must be driven toward the previously laid bale to force the bales together. Drive the posts into the soil such that the top of the post is less than 2 in above the top of the straw bale. The post must extend a minimum of 2 ft in the ground below the bottom of the straw bales.

Angle the last 6 feet upslope at the downhill end of the run.

See page 5 of this BMP for installation detail.

## Straw Bale Barrier

## SC-9

### Other Considerations

Construct straw bale barriers with a set-back of at least 3 ft from the toe of a slope. Where it is determined to be not practical due to specific site conditions, the straw bale barrier may be constructed at the toe of the slope, but be constructed as far from the toe of the slope as practical.

This BMP may be implemented on a project-by-project basis in addition to other BMPs when determined necessary and feasible by the RE.

Straw bale barriers may be used in combination with a silt fence (see SC-2 "Silt Fence") for additional sediment control.

### Maintenance and Inspection

At a minimum, BMPs must be inspected weekly, prior to forecasted rain events, daily during extended rain events, and after the conclusion of rain events.

Inspect straw bale barriers for sediment accumulations and remove sediment when depth reaches one-third the barrier height. Removed sediment should be disposed of outside the highway right-of-way in conformance with the Standard Specifications.

Replace or repair damaged bales as needed or as directed by the RE.

Repair washouts or other damages as needed or as directed by the RE.

Remove straw bales when no longer needed. Remove sediment accumulation, and clean, re-grade, and stabilized the area.


Straw Bale Barrier placement must be shown on the WPCDs and reflect current site conditions.

### SWPPP or WPCP

Straw Bale Barrier must be discussed in Section 500.3 of the SWPPP or Section 30.2 of the WPCP.





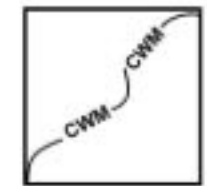

Standard Symbol

BMP Objectives	
Soil Stabilization	<input type="checkbox"/>
Sediment Control	<input type="checkbox"/>
Tracking Control	<input type="checkbox"/>
Wind Erosion Control	<input type="checkbox"/>
Non-Stormwater Management	<input type="checkbox"/>
Materials and Waste Management	<input checked="" type="checkbox"/>

**Definition and Purpose**

These are procedures and practices that are designed to minimize or eliminate the discharge of concrete waste materials to the storm drain systems or watercourses.

**Appropriate Applications**

Concrete waste management procedures and practices are implemented on construction projects where concrete is used as a construction material or where concrete dust and debris result from demolition activities.

Where slurries containing portland cement concrete (PCC) or asphalt concrete (AC) are generated, such as from sawcutting, coring, grinding, grooving, and hydro-concrete demolition.

Where concrete trucks and other concrete-coated equipment are washed on site, when approved by the Resident Engineer (RE). See also NS-8, "Vehicle and Equipment Cleaning."

Where mortar-mixing stations exist.

**Limitations**

None identified.

**Standards and Specifications**

**Education**

Educate employees, subcontractors, and suppliers on the concrete waste management techniques described herein.

The WPC Manager shall oversee and enforce concrete waste management procedures.

**Concrete Demolition Wastes**

Stockpile concrete demolition wastes in accordance with BMP WM-3, "Stockpile Management."

Disposal of hardened PCC and AC waste shall be in conformance with Standard Specifications Section 14-10 Solid Waste Disposal and Recycling.

**Concrete Slurry Waste Management and Disposal**

PCC and AC waste shall not be allowed to enter storm drainage systems or watercourses.

A sign shall be installed adjacent to each temporary concrete washout facility to inform concrete equipment operators to utilize the proper facilities.

The WPCM must ensure that onsite concrete working tasks are being monitored, such as saw cutting, coring, grinding and grooving to ensure proper methods are implemented.

Residue from saw cutting, coring and grinding operations shall be picked up by means of a vacuum device. Residue shall not be allowed to flow across the pavement and shall not be left on the surface of the pavement. See also NS-3, "Paving and Grinding Operations."

Vacuumed slurry residue shall be disposed in accordance with WM-5, "Solid Waste Management" and Standard Specifications Section 7-1.13. Slurry residue shall be temporarily stored in a facility as described in "Onsite Temporary Concrete Washout Facility, Concrete Transit Truck Washout Procedures" below), or within an impermeable containment vessel or bin.

Collect and dispose of all residues from grooving and grinding operations in accordance with Standard Specifications Section 14-10 Solid Waste Disposal and Recycling and Standard Specifications 14-11 Hazardous Waste and Contamination.

**Onsite Temporary Concrete Washout Facility, Concrete Transit Truck Washout Procedures**

Temporary concrete washout facilities shall be located a minimum of 50 ft. from storm drain inlets, open drainage facilities, and watercourses, unless determined infeasible by the RE. Each facility shall be located away from construction traffic or access areas to prevent disturbance or tracking.

A sign shall be installed adjacent to each washout facility to inform concrete equipment operators to utilize the proper facilities. The sign shall be installed as shown on the plans and in conformance with the provisions in Standard Specifications Section 56 2, Overhead Sign Structure.

Temporary concrete washout facilities shall be constructed above grade or below grade at the option of the Contractor. Temporary concrete washout facilities shall be constructed and maintained in sufficient quantity and size to contain all liquid and concrete waste generated by washout operations.

Temporary washout facilities shall have a temporary pit or bermed areas of sufficient volume to completely contain all liquid and waste concrete materials generated during washout procedures.

Perform washout of concrete mixers, delivery trucks, and other delivery systems in designated areas only.

Wash concrete only from mixer chutes into approved concrete washout facility. Washout may be collected in an impermeable bag or other impermeable containment devices for disposal.

Pump excess concrete in concrete pump bin back into concrete mixer truck.

Concrete washout from concrete pumper bins can be washed into concrete pumper trucks and discharged into designated washout area or properly disposed offsite.

Once concrete wastes are washed into the designated area and allowed to harden, the concrete shall be broken up, removed, and disposed of in conformance with the provisions in Standard Specifications Section 7-1.13 or 15 3.02.

**Temporary Concrete Washout Facility Type "Above Grade"**

Temporary concrete washout facility Type "Above Grade" shall be constructed as shown on Page 6 or 7, with a recommended minimum length and minimum width of 10 ft. but with sufficient quantity and volume to contain all liquid and concrete waste generated by washout operations. The length and width of a facility may be increased, at the Contractor's expense, upon approval from the RE.

Straw bales, wood stakes, and sandbag materials shall conform to the provisions in SC-9, "Straw Bale Barrier."

Plastic lining material shall be a minimum of 10-mil polyethylene sheeting and shall be free of holes, tears or other defects that compromise the impermeability of the material. Liner seams shall be installed in accordance with manufacturers' recommendations.

Portable delineators shall conform to the provisions in Standard Specifications Section 12 3.04, "Portable Delineators." The delineator bases shall be cemented to the pavement in the same manner as provided for cementing pavement markers to pavement. Portable delineators shall be applied only to a clean, dry surface.

**Temporary Concrete Washout Facility (Type Below Grade)**

Temporary concrete washout facility Type "Below Grade" shall be constructed as shown on page 6, with a recommended minimum length and minimum width of 10 ft. The quantity and volume shall be sufficient to contain all liquid and concrete waste generated by washout operations. The length and width of a facility may be increased, at the Contractor's expense, upon approval of the RE. Lath and flagging shall be commercial type.

Plastic lining material shall be a minimum of 10-mil polyethylene sheeting and shall be free of holes, tears or other defects that compromise the impermeability of the material. Liner seams shall be installed in accordance with manufacturers' recommendations.

The soil base shall be prepared free of rocks or other debris that may cause tears or holes in the plastic lining material.

Temporary washout facilities shall implement BMPs to prevent run-on and run-off from the facility.

**Removal of Temporary Concrete Washout Facilities**

When temporary concrete washout facilities are no longer required for the work, as determined by the RE, the hardened concrete shall be removed and disposed of. Disposal of PCC dried residues, slurries or liquid waste shall be disposed of outside the highway right-of-way in conformance with provisions of Standard Specifications Section 7-1-13. Materials used to construct temporary concrete washout facilities shall become

the property of the Contractor, shall be removed from the site of the work, and shall be disposed of outside the highway right-of-way.

Holes, depressions or other ground disturbance caused by the removal of the temporary concrete washout facilities shall be backfilled and repaired in conformance with the provisions in Standard Specifications Section 15 1.02, "Preservation of Property."

**Maintenance and Inspection**

Inspect Concrete Waste Management areas before, during and after rainfall events, and at least weekly during other times.

The WPC Manager shall monitor concrete working tasks, such as sawcutting, coring, grinding and grooving daily to ensure proper methods are employed or as directed by the RE.

Temporary concrete washout facilities shall be maintained to provide adequate holding capacity with a minimum freeboard of 4 inches for above grade facilities and 12 inches for below grade facilities.

Maintaining temporary concrete washout facilities shall include removing and disposing of hardened concrete and returning the facilities to a functional condition.

Hardened concrete materials shall be removed and disposed of in conformance with the provisions in Standard Specifications Section 7-1.13 or 15 3.02.

Existing facilities must be cleaned, or new facilities must be constructed and ready for use once the washout is 75% full.

Temporary concrete washout facilities shall be inspected for damage (i.e. tears in polyethylene liner, missing sandbags, etc.). Damaged facilities shall be repaired.

Inspection and Maintenance of these areas must be properly documented and ensure no potential for discharges occur from these areas as part of the non-visible monitoring requirements.


**SWPPP or WPCP**

Concrete Waste Management must be discussed in Section 500.4.2 of the SWPPP or Section 30.3.2 of the WPCP.



City of Santa Barbara  
 EROSION / SEDIMENTATION CONTROL AND  
 STORMWATER QUALITY MANAGEMENT PROGRAM

Concrete Waste Management

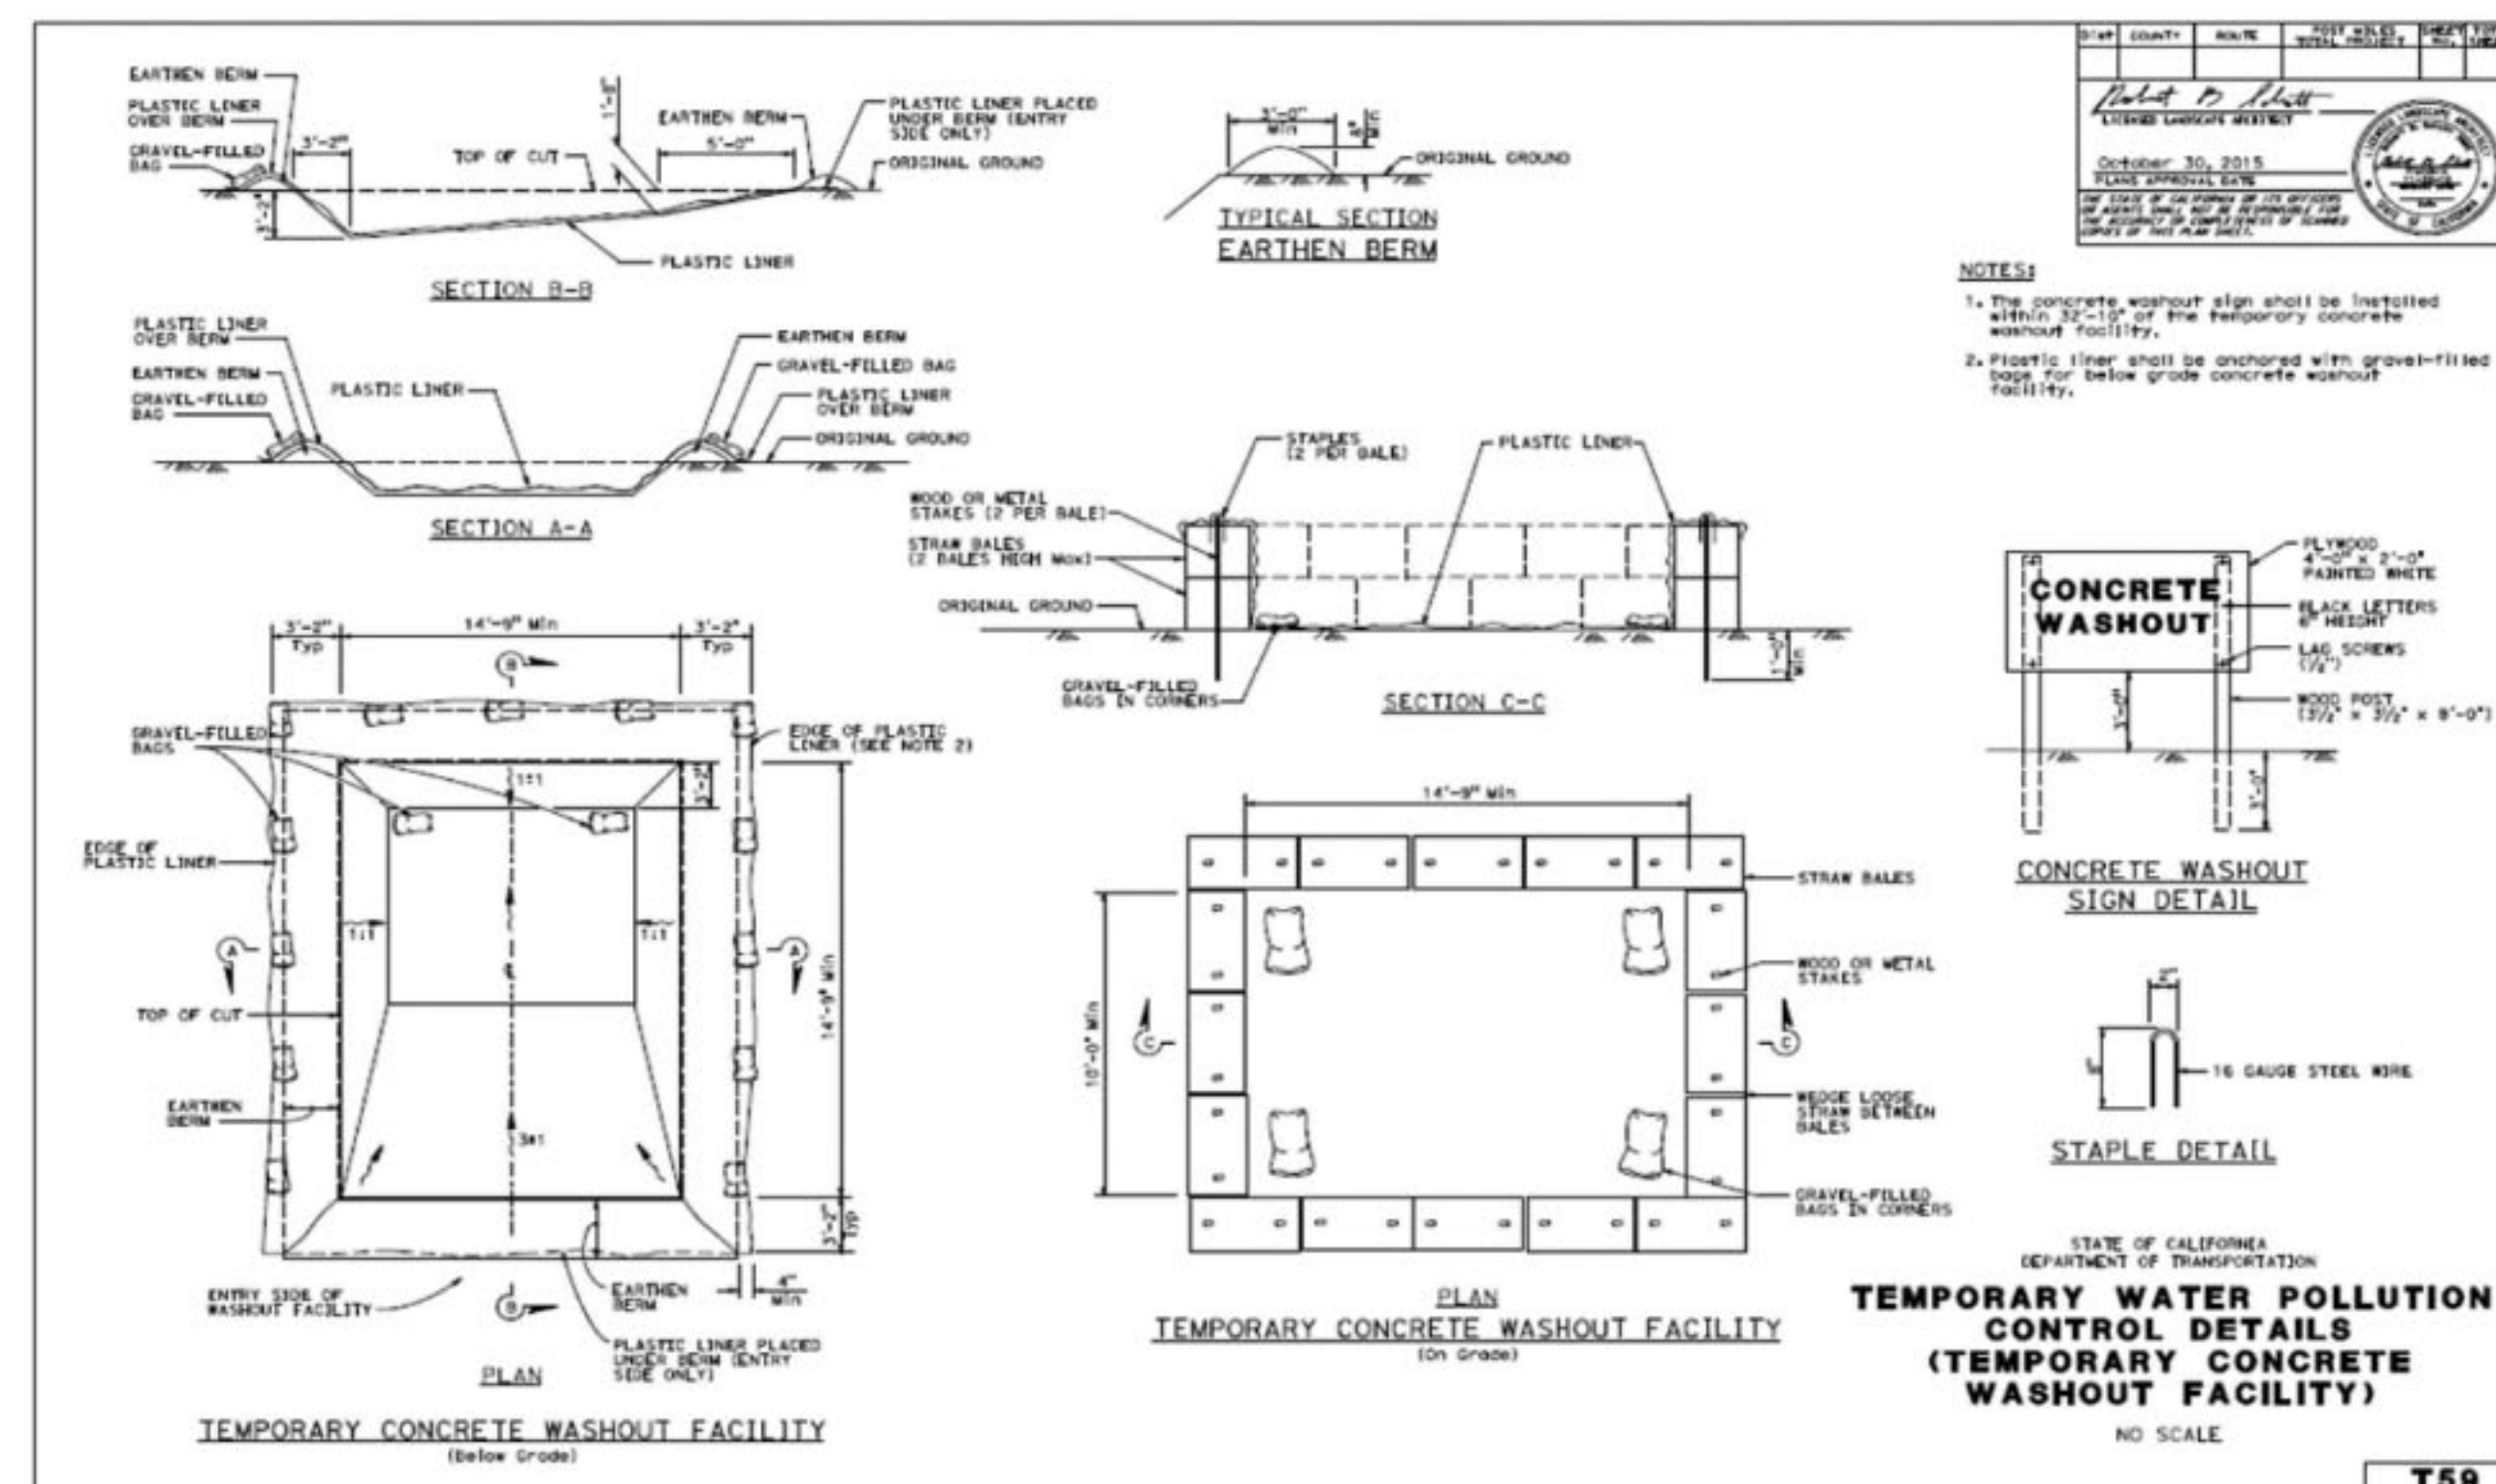



Drawn By:  
 NN

Drawing Date:  
 October 10, 2023

Revision	date	notes
1	12/13/23	Plan Check

**Evans Remodel**  
 412 Flora Vista, Santa Barbara, CA

PROJECT:



**BMP Plan**

SHEET TITLE:

**BMP-6**

DRAW:

**BMP Required Maintenance:**

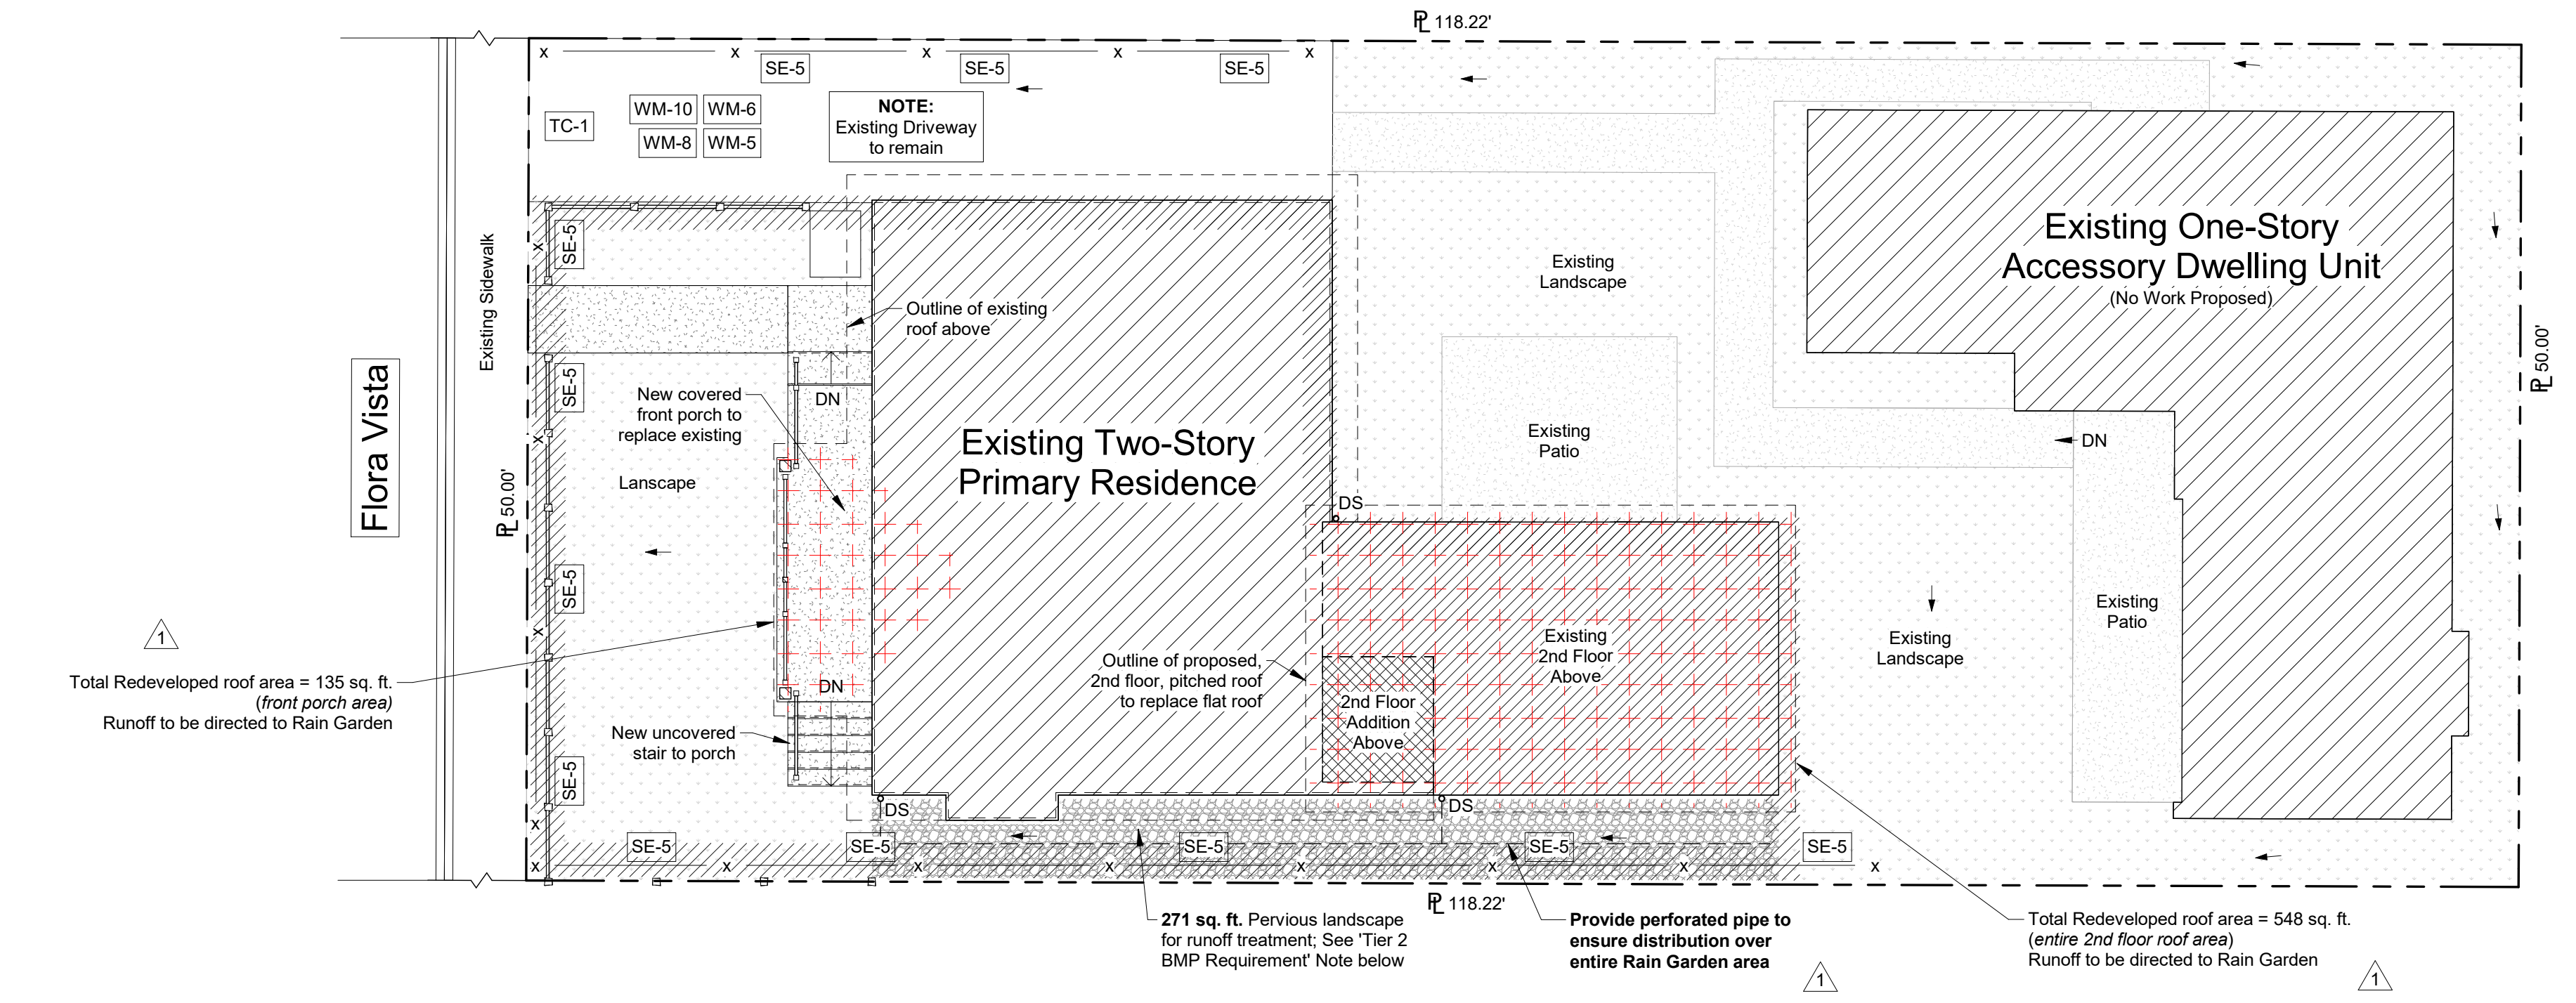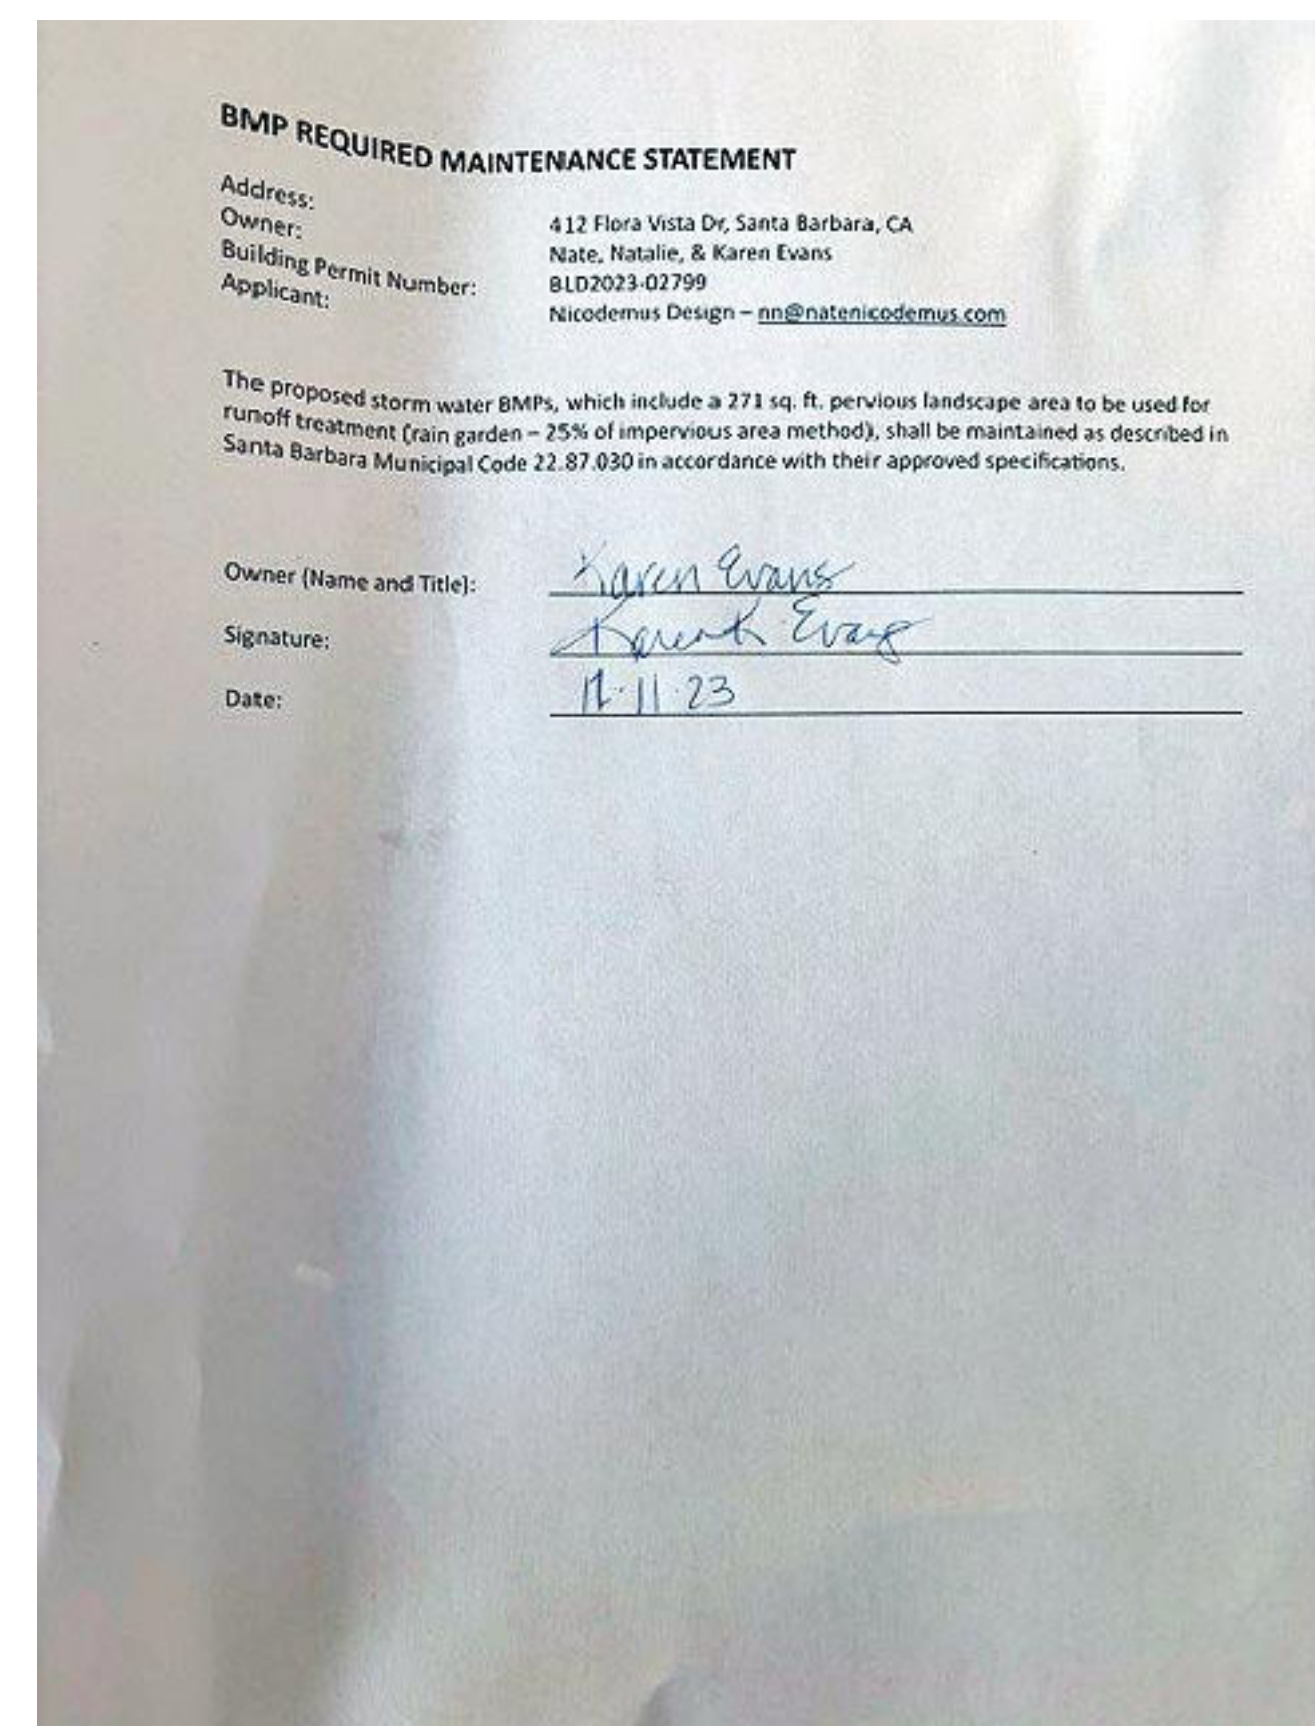

**1** BMP Plan  
 1/8" = 1'-0"

**Source Control BMPs:**

- 3.1.7 Design Trash Storage Areas to Reduce Pollution Contribution**  
 Trash storage areas shall:  
 - Be paved with an impervious surface designed to prevent run-on from adjoining areas and screened or walled to prevent off-site transport of trash.  
 - Contain attached lids on all trash containers to prevent rainfall intrusion.  
 - Contain a roof or awning, at the discretion of the City, for high usage trash areas such as those for fast food establishments, convenience stores, and high-density residential developments.
- 3.1.14 Use Non-Toxic Roofing Materials Where Feasible:**  
 - Avoid the use of galvanized steel or copper for roofs, gutters, and downspouts  
 - If using such materials, reduce the potential for leaching of metals by applying a coating or patina  
 - Avoid composite roofing materials that contain copper

**Legend**

	Concrete		Natural Stone Tile
	Landscape		Site Drainage
	Limit of Work		Rain Garden for runoff treatment
	Redeveloped Impervious Area		Downspout
	Temporary Silt Fence		

**Tier 2 BMP Requirement - Runoff Treatment Area:**

Per City of Santa Barbara Storm Water BMP Guidance Manual (page 61):  
 "One simple and inexpensive way to comply with Tier 2 requirements involves providing natural/vegetated/mulched area totaling at least 25% of tributary impervious surface area. Runoff shall be able to "access" the entire 25% treatment area to ensure maximum infiltration. The proposed permeable treatment area must have a slope less than 7%, and be at least 18" wide."

**Proposed Redeveloped Impervious Area: 683 sq. ft.**  
 2nd Floor Roof: 548 sq. ft. (see roof plan 4/A3 & 1/BMP-6)  
 Entry Porch Roof: 135 sq. ft. (see plan 1/A3 & 1/BMP-6)

**683 sq. ft. x 0.25 = 170.75 sq. ft. Pervious Treatment Area Required**

**Pervious Treatment Area Provided: 271 sq. ft.** (see southern side yard on Site Plan 1/A1 and 1/BMP-6)

**NOTE:** See plans 4/A3 and 1/A3 for downspout locations. Runoff from downspouts to sheet flow over pervious landscape area, where sheet flow does not occur naturally, utilize a flow spreader such as a level spreader or disperser.

**Low-Impact Development Design Practices:**

All Standard Development Projects shall be subject to the LID BMP requirements detailed in this section. Additional LID requirements will apply to PDPs as outlined in section 4.4. The objectives of the Standard Development Project LID BMP requirements are to detain and filter runoff using natural features. Storm water retention for storm water reuse represents a potential added benefit of LID facilities, but is not specifically required as part of Standard Development Project LID requirements. The applicability of Standard Development Project LID BMP requirements varies depending on project characteristics such as development density, site location, or other land use issues. While certain landscaping LID features may be incorporated into a detached residential or commercial project, they may not fit into the development footprint of other projects, such as urban high-rise developments. Additional information regarding LID design approaches can be found in the Countywide Model SUSMP and the City's LID Design Manual (see Suggested Resources in Appendix A). LID strategies for Standard Development Projects include:

**1. Optimize the Site Layout**  
 To minimize storm water related impacts, apply the following design principles to the layout of newly developed and redeveloped sites:  
 - Utilize existing topography to optimize the site layout and reduce the need for grading.  
 Development envelopes should be focused in the upper elevations of a site to promote sheet flow and natural surface drainage to BMPs or Integrated Management Practices (IMPs) located at lower elevations of the site (IMPs are discussed in detail in Appendix I of this manual).  
 - Where possible, conform the site layout along natural landforms, avoid excessive grading and disturbance of vegetation and soils, and replicate the site's natural drainage patterns. Set development sufficiently away from creeks, wetlands, and riparian habitats.

**3. Disperse Runoff to Adjacent Landscaping**  
 Project designs should direct runoff from impervious areas to adjacent landscaping areas. The design, including consideration of slopes and soils, must reflect a reasonable expectation that an inch of rainfall will soak into the soil and produce no runoff.  
 - Minimize directly connected impervious areas as follows:  
 Drain rooftops into adjacent landscaping areas.  
 Drain impervious parking lots, sidewalks, walkways, trails, and patios into adjacent landscaping areas.

**Stormwater BMPs:**

	Stabilized Construction Entrance (See Sheet BMP2)
	Temporary Silt Fence (See Sheet BMP3)
	Fiber Rolls (See Sheet BMP4)
	Straw Bale Barrier (See Sheet BMP4)
	Concrete Waste Management (See Sheet BMP5)
	Sanitary Waste Management
	Concrete Waste Management (See Sheet BMP5)

**General Notes:**

This drawing illustrates Best Management Practices (BMPs) that must be used at all construction sites in the City to protect storm drains and minimize pollution.

The following is a list of BMPs and pollution prevention measures that shall be implemented at all construction sites.

- 1) Conduct daily site cleanings.
- 2) Develop spill response and containment procedures.
- 3) Educate employees and subcontractors about BMPs.
- 4) Develop an erosion control plan for wind and rain.
- 5) Regularly maintain all BMPs at project site.



# PROJECT MATERIALS

Composite shingle roof to match existing:  
GAF Timberline



Windows to match existing ADU;  
Aluminum-Clad Wood Windows  
by Lincoln; Black Exterior



Stucco to match existing ADU;  
El Dorado by La Habra, Smooth

Evans Remodel  
412 Flora Vista, Santa Barbara, CA







1) 412 Flora Vista - From Street (From West looking East)

Evans Remodel  
412 Flora Vista, Santa Barbara, CA







2) 412 Flora Vista - Northwest Corner

Evans Remodel  
412 Flora Vista, Santa Barbara, CA







3) 412 Flora Vista - From North looking South

Evans Remodel  
412 Flora Vista, Santa Barbara, CA







4) 412 Flora Vista - From East looking West

Evans Remodel  
412 Flora Vista, Santa Barbara, CA







5) 412 Flora Vista ADU - From West looking East

Evans Remodel  
412 Flora Vista, Santa Barbara, CA





6) 412 Flora Vista ADU - From South looking North

Evans Remodel  
412 Flora Vista, Santa Barbara, CA





7) 412 Flora Vista - From Cliff Drive (South looking North)

Evans Remodel  
412 Flora Vista, Santa Barbara, CA







8) 2336 Cliff Drive

Evans Remodel  
412 Flora Vista, Santa Barbara, CA





9) 416 Flora Vista Drive

Evans Remodel  
412 Flora Vista, Santa Barbara, CA





10) 422 Flora Vista Drive

Evans Remodel  
412 Flora Vista, Santa Barbara, CA







11) 419 Flora Vista Drive

Evans Remodel  
412 Flora Vista, Santa Barbara, CA





12) 415 Flora Vista Drive

Evans Remodel  
412 Flora Vista, Santa Barbara, CA





13) 409 Flora Vista Drive

Evans Remodel  
412 Flora Vista, Santa Barbara, CA





14) 2342 Cliff Drive

Evans Remodel  
412 Flora Vista, Santa Barbara, CA